


AMENDMENTS:		
AMENDMENT	DATE	DESCRIPTION



SERVICES

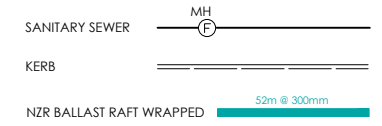

NOTES:

- 1) ALL LATERAL AND SEWER PRESSURE MAIN AS BUILT INFORMATION WAS PROVIDED BY FULTON HOGAN LIMITED & CITY CARE LIMITED AND NO LIABILITY IS ACCEPTED FOR THE ACCURACY OF THIS INFORMATION.
- 2) THIS PLAN HAS BEEN PREPARED FOR ASBUILT PURPOSES ONLY. NO LIABILITY IS ACCEPTED IF THE PLAN IS USED FOR ANY OTHER PURPOSE.
- 3) ANY MEASUREMENTS TAKEN FROM INFORMATION WHICH IS NOT DIMENSIONED ON THE ELECTRONIC COPY ARE AT THE RISK OF THE RECIPIENT.
- 4) **ORIGIN OF LEVELS**
BM.EHC6 RL=28.99
CORNER OF AWATEA & WIGRAM ROADS
LEVELS IN TERMS OF CHRISTCHURCH DRAINAGE DATUM.
JANUARY 2012 ISSUE



116 Wrights Road P O Box 679 Christchurch 8140, New Zealand
Telephone: 03 379-0793 Website: www.dls.co.nz E-mail: office@dls.co.nz


JOB TITLE:
Fulton Hogan Land Development
Knights Stream Park

SHEET TITLE:
Sewer Asbuilt


DRAWING STATUS:
Stage 3C - Asbuilt

SCALE: 1:500@A1
1:1000@A3 **DATE:** November 2014

CAD FILE: J:\18022\Eng\CIVIL 3C\ASBUILT\E18022.3C.AB01.R0.dwg **REVISION:**
DRAWING No: **SHEET No:**
E.18022.3C.SS.AB01 **R0**

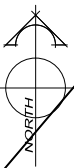

AMENDMENTS:		
AMENDMENT	DATE	DESCRIPTION

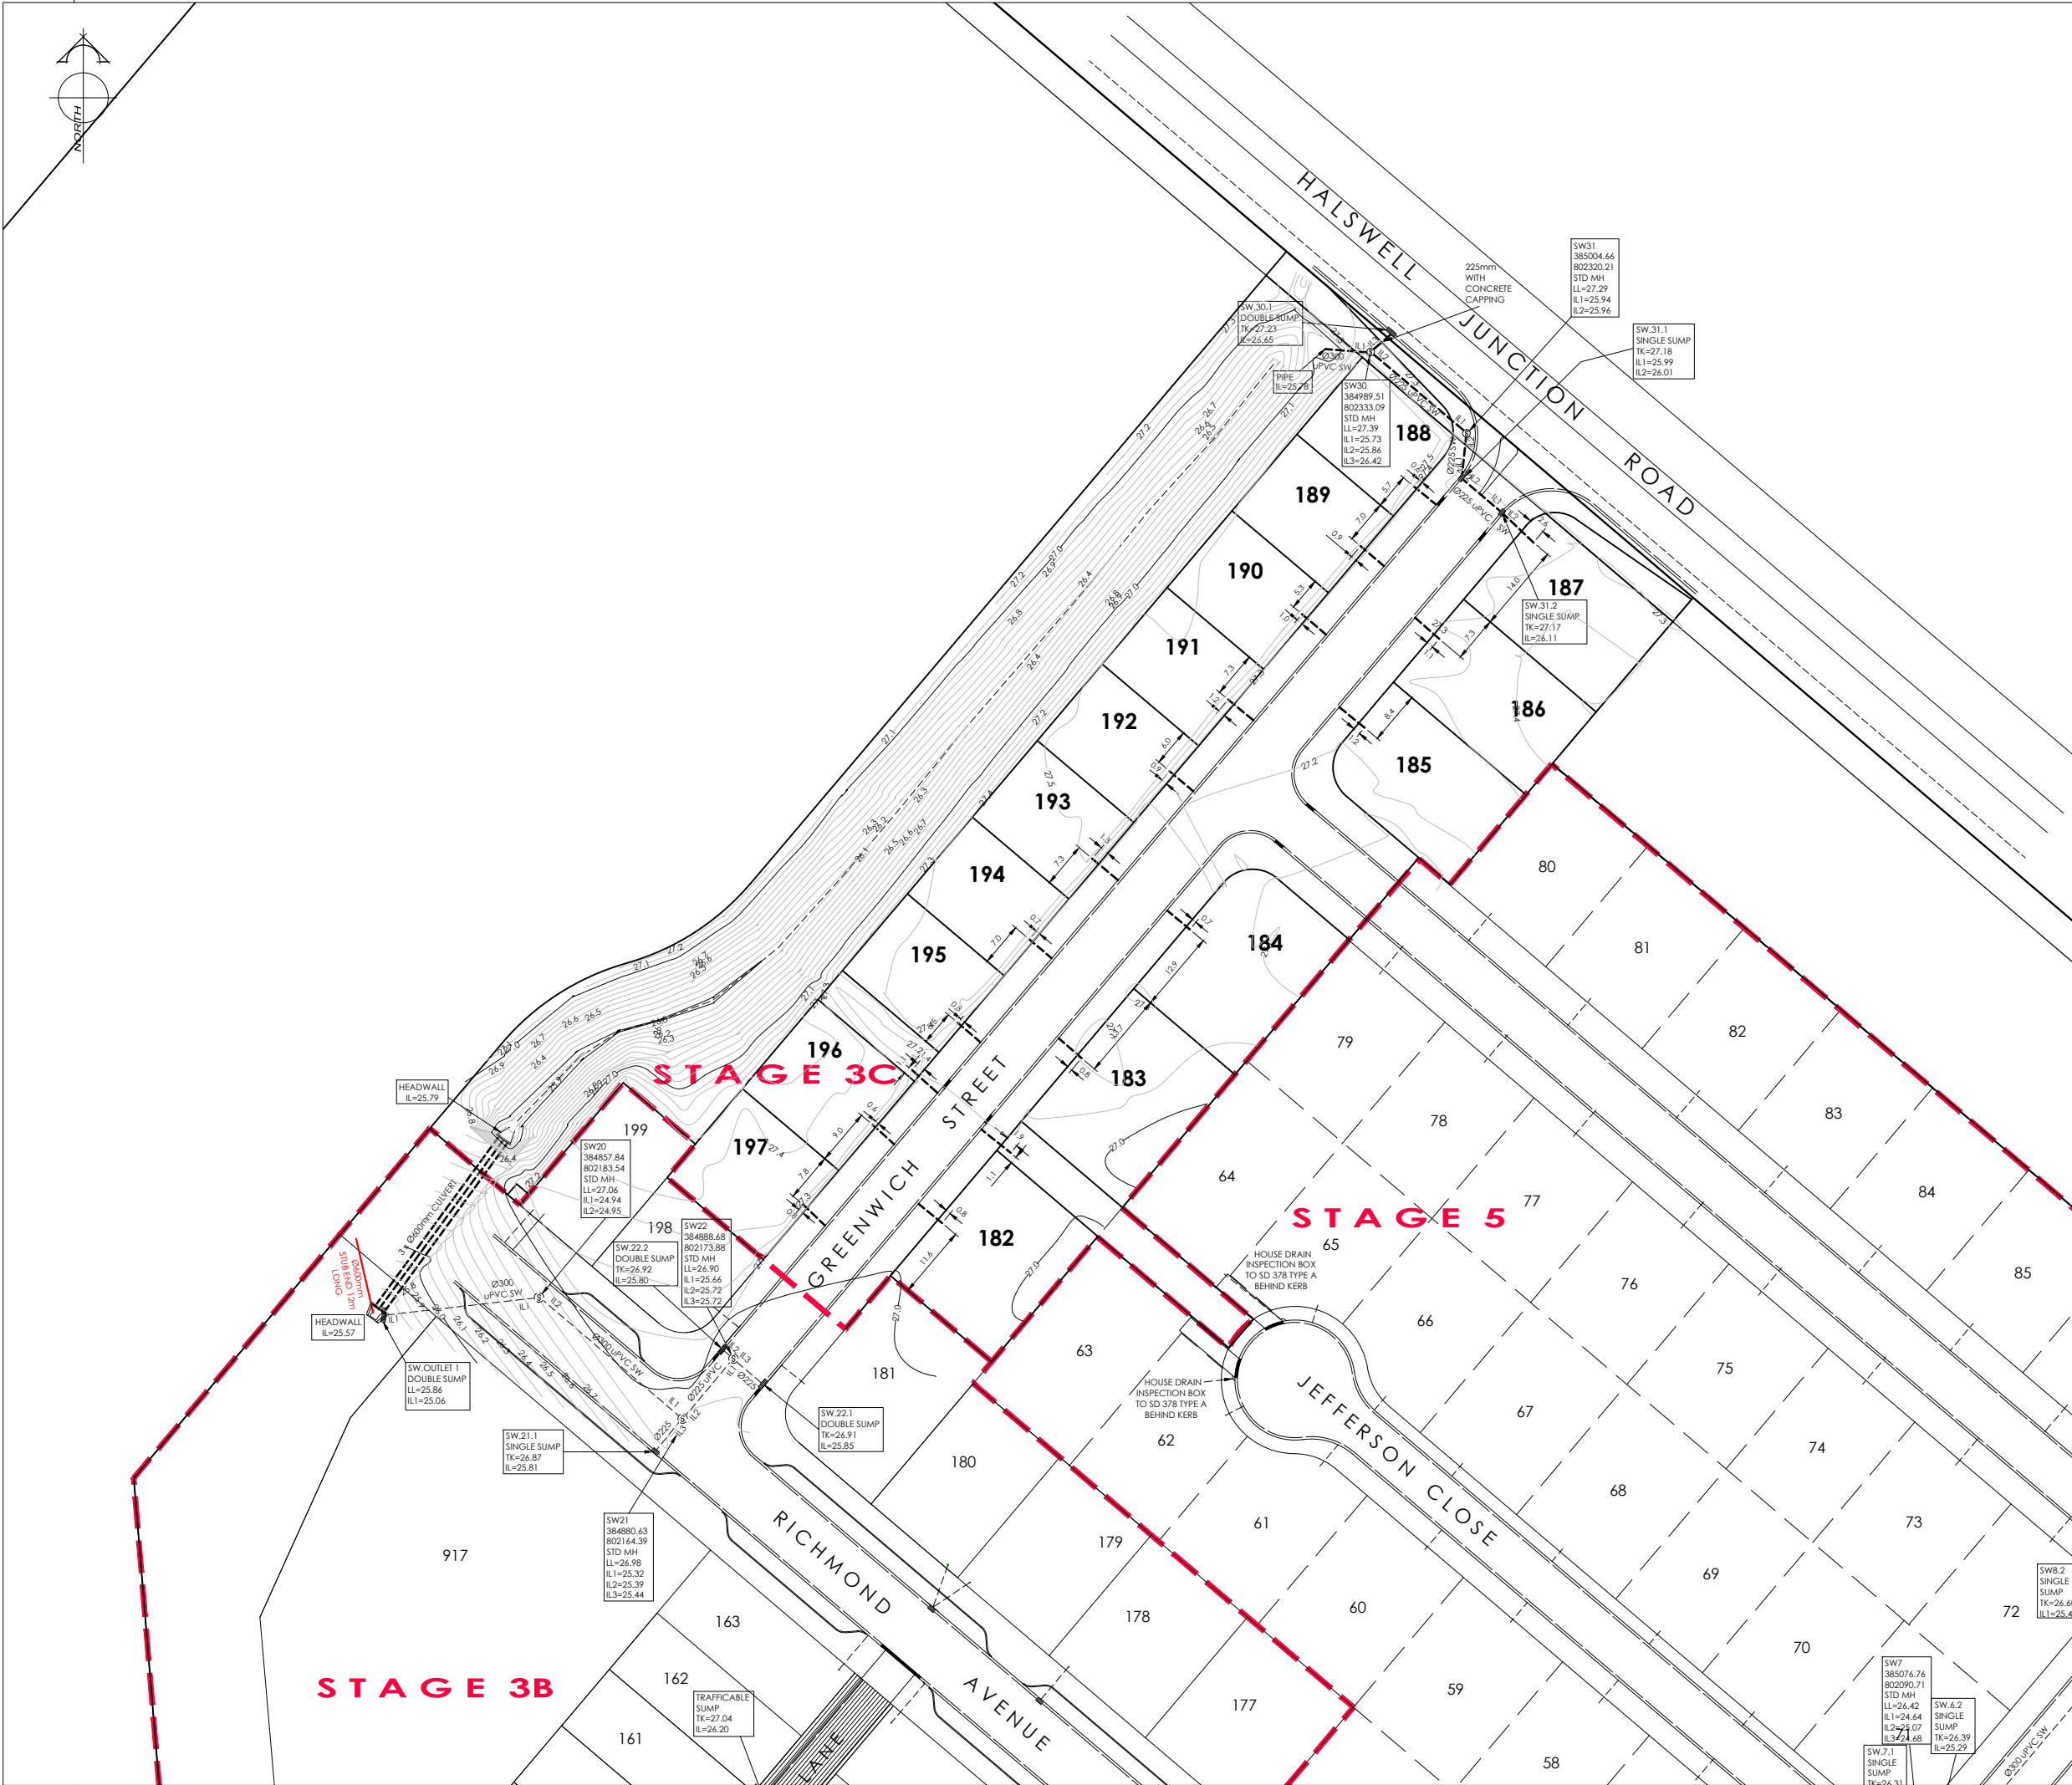

- NOTES:**
- 1) ALL LATERAL AS BUILT INFORMATION WAS PROVIDED BY FULTON HOGAN LIMITED & CITY CARE LIMITED AND NO LIABILITY IS ACCEPTED FOR THE ACCURACY OF THIS INFORMATION.
 - 2) THIS PLAN HAS BEEN PREPARED FOR ASBUILT PURPOSES ONLY. NO LIABILITY IS ACCEPTED IF THE PLAN IS USED FOR ANY OTHER PURPOSE.
 - 3) ANY MEASUREMENTS TAKEN FROM INFORMATION WHICH IS NOT DIMENSIONED ON THE ELECTRONIC COPY ARE AT THE RISK OF THE RECIPIENT.
 - 4) ORIGIN OF LEVELS
 BM.LHC6 RL=28.99
 CORNER OF AWATEA & WIGRAM ROADS
 LEVELS IN TERMS OF CHRISTCHURCH DRAINAGE DATUM, JANUARY 2012 ISSUE



116 Wrights Road P O Box 679 Christchurch 8140, New Zealand
 Telephone: 03 379-0793 Website: www.dls.co.nz E-mail: office@dls.co.nz


JOB TITLE:
 Fulton Hogan Land Development
 Knights Stream Park

SHEET TITLE:
 Stormwater Asbuilt


DRAWING STATUS:
 Stage 3C - Asbuilt

SCALE: 1:500@A1
 1:1000@A3 **DATE:** November 2014


CAD FILE: J:\18022\Eng\CIVIL 3C\ASBUILT\E18022.3C.AB01 R0.dwg **REVISION:**
DRAWING No: E.18022.3C.SW.AB01 **SHEET No:** R0

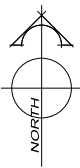

AMENDMENTS:		
AMENDMENT	DATE	DESCRIPTION
R1	20.6.13	AS BUILT STORMWATER BASINS UPDATED

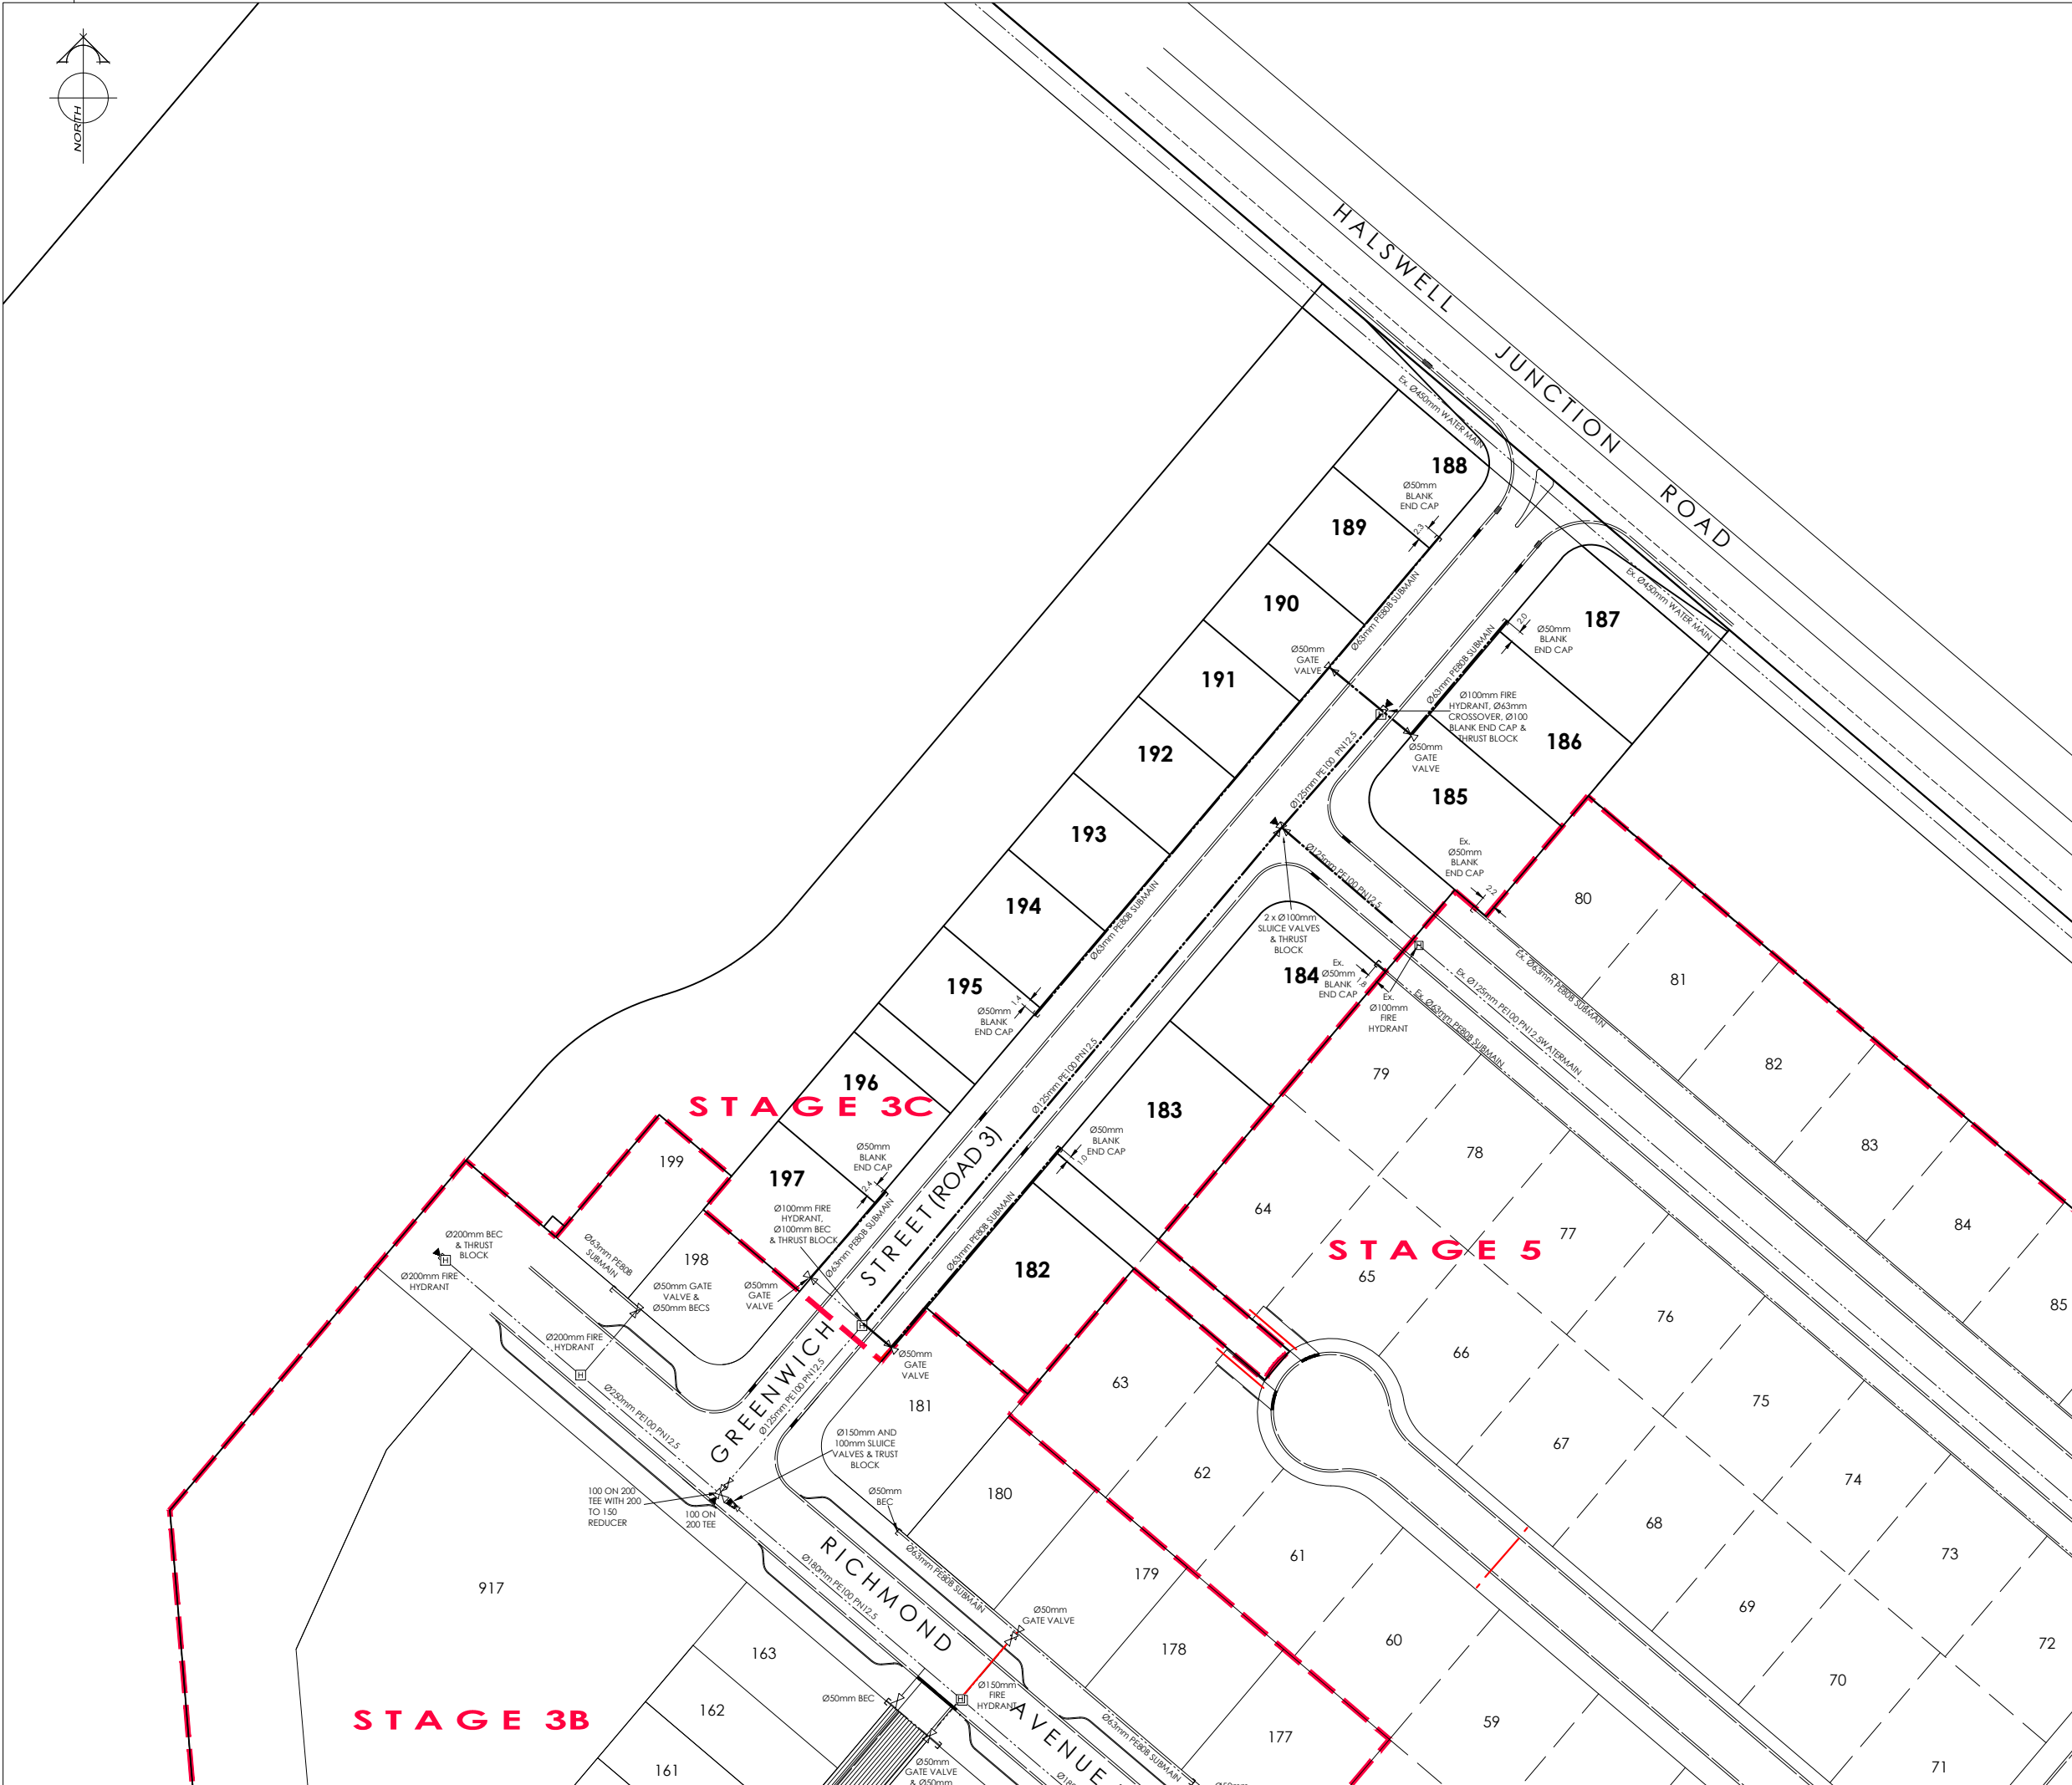

SERVICES

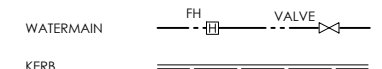

NOTES:

- 1) ALL AS BUILT INFORMATION WAS PROVIDED BY FULTON HOGAN LIMITED & CITY CARE LIMITED AND NO LIABILITY IS ACCEPTED FOR THE ACCURACY OF THIS INFORMATION.
- 2) THIS PLAN HAS BEEN PREPARED FOR ASBUILT PURPOSES ONLY. NO LIABILITY IS ACCEPTED IF THE PLAN IS USED FOR ANY OTHER PURPOSE.
- 3) ANY MEASUREMENTS TAKEN FROM INFORMATION WHICH IS NOT DIMENSIONED ON THE ELECTRONIC COPY ARE AT THE RISK OF THE RECIPIENT.
- 4) ORIGIN OF LEVELS
 BM.LHC6 RL=28.99
 CORNER OF AWATEA & WIGRAM ROADS
 LEVELS IN TERMS OF CHRISTCHURCH DRAINAGE DATUM, JANUARY 2012 ISSUE



116 Wrights Road P O Box 679 Christchurch 8140. New Zealand
 Telephone: 03 379-0793 Website: www.dls.co.nz E-mail: office@dls.co.nz

JOB TITLE:
 Fulton Hogan Land Development
 Knights Stream Park

SHEET TITLE:
 Water Asbuilt

DRAWING STATUS:
 Stage 3C - Asbuilt

SCALE: 1:500@A1 DATE: November 2014
 1:1000@A3

CAD FILE: J:\18022\Eng\CIVIL 3C\ASBUILT\E18022.3C.A801 R0.dwg **REVISION:**
DRAWING No: E.18022.3C.W.AB01 **SHEET No:** R0