


STAGE 3a

STAGE 6

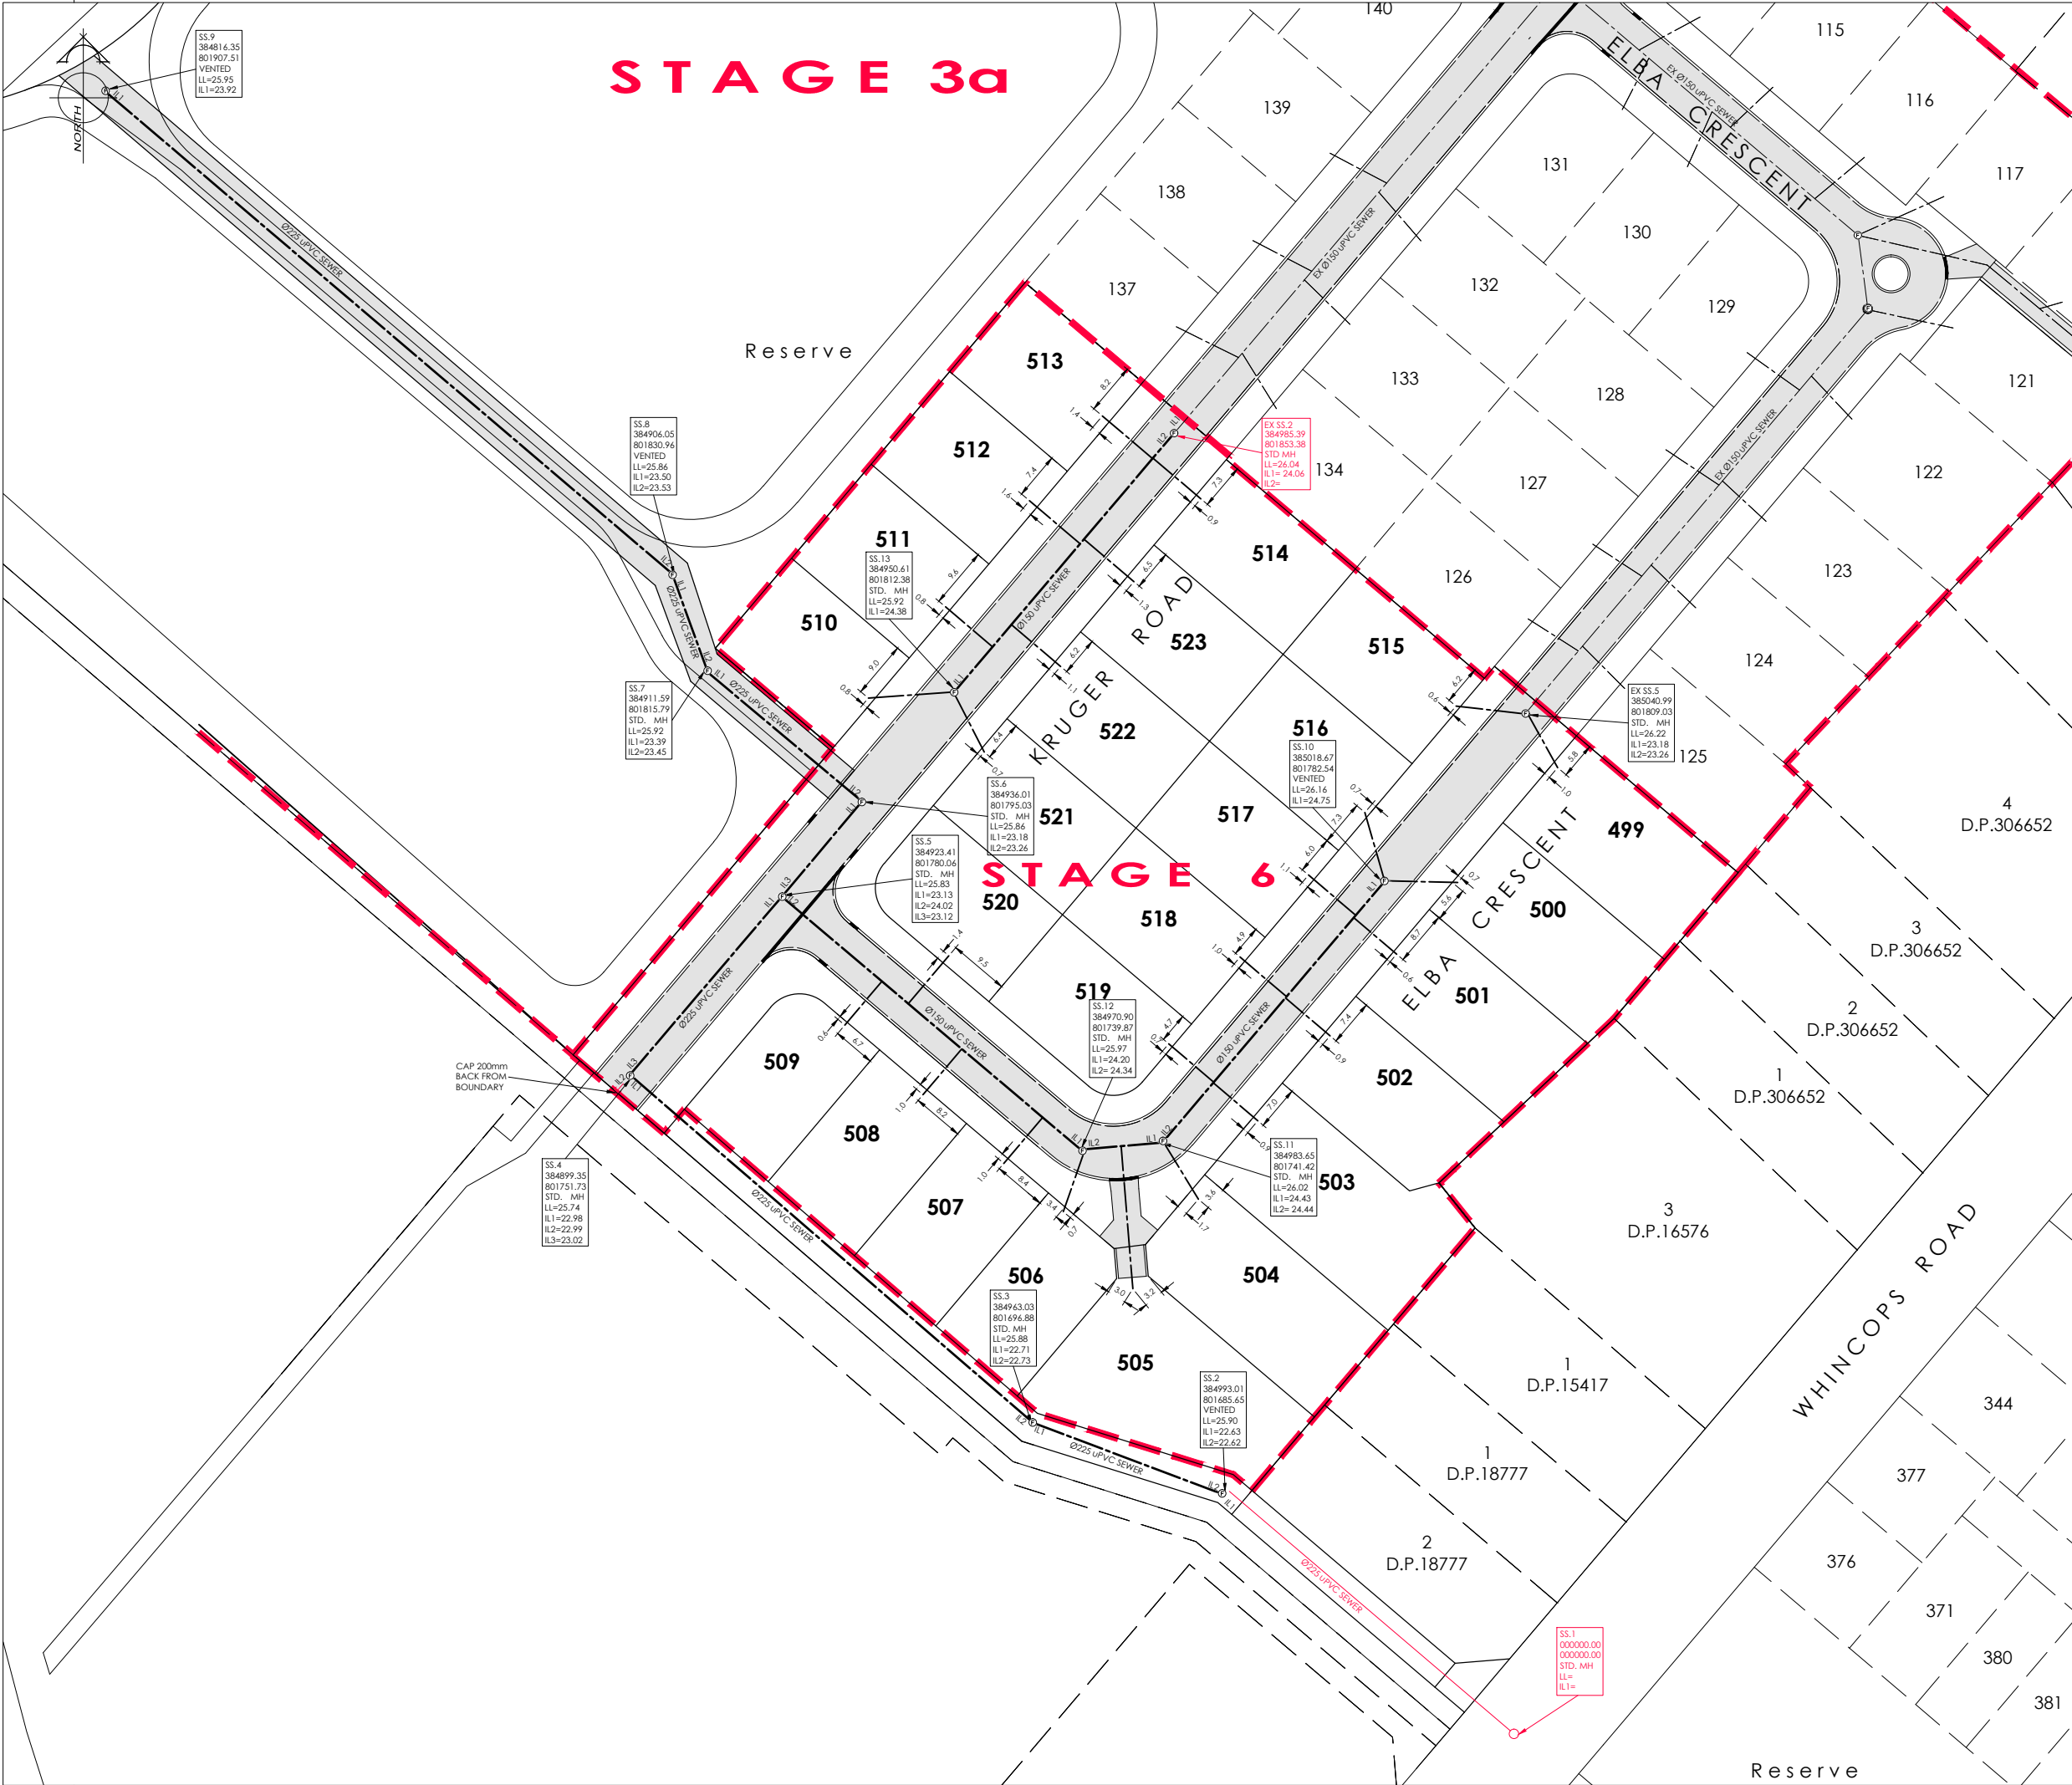

AMENDMENTS:		
AMENDMENT	DATE	DESCRIPTION

NOTES:

1) ALL AS BUILT INFORMATION WAS PROVIDED BY FULTON HOGAN LIMITED & CITY CARE LIMITED AND NO LIABILITY IS ACCEPTED FOR THE ACCURACY OF THIS INFORMATION.

2) THIS PLAN HAS BEEN PREPARED FOR ASBUILT PURPOSES ONLY. NO LIABILITY IS ACCEPTED IF THE PLAN IS USED FOR ANY OTHER PURPOSE.


3) ANY MEASUREMENTS TAKEN FROM INFORMATION WHICH IS NOT DIMENSIONED ON THE ELECTRONIC COPY ARE AT THE RISK OF THE RECIPIENT.

4) ORIGIN OF LEVELS
 BM.EHC6 RL=28.99
 CORNER OF AWATEA & WIGRAM ROADS

LEVELS IN TERMS OF CHRISTCHURCH DRAINAGE DATUM.
 JANUARY 2012 ISSUE



- NOTES:**
- 1) ALL AS BUILT INFORMATION WAS PROVIDED BY FULTON HOGAN LIMITED & CITY CARE LIMITED AND NO LIABILITY IS ACCEPTED FOR THE ACCURACY OF THIS INFORMATION.
 - 2) THIS PLAN HAS BEEN PREPARED FOR ASBUILT PURPOSES ONLY. NO LIABILITY IS ACCEPTED IF THE PLAN IS USED FOR ANY OTHER PURPOSE.
 - 3) ANY MEASUREMENTS TAKEN FROM INFORMATION WHICH IS NOT DIMENSIONED ON THE ELECTRONIC COPY ARE AT THE RISK OF THE RECIPIENT.
 - 4) ORIGIN OF LEVELS
 BM.EHC6 RL=28.99
 CORNER OF AWATEA & WIGRAM ROADS
- LEVELS IN TERMS OF CHRISTCHURCH DRAINAGE DATUM.
 JANUARY 2012 ISSUE

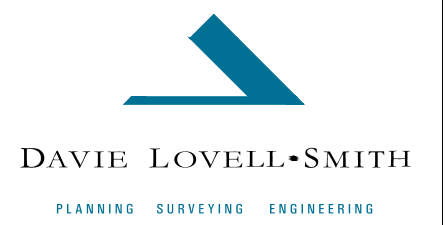

116 Wrights Road P.O. Box: 679 Christchurch 8140. New Zealand
 Telephone: 03 379-0793 E-mail: office@dls.co.nz


JOB TITLE:
 Fulton Hogan Land Development
 Knights Stream Park
 Stage 6

SHEET TITLE:
 Sewer Asbuilt
 RMA92023522

DRAWING STATUS:
 Stage 6 - Asbuilt

SCALE: 1:500@A1
 1:1000@A3 **DATE:** June 2014

CAD FILE: J:\18390\ASBUILTS - STAGE 6\E18390.AB.DWG **REVISION:**
DRAWING No: E.18390.6.SS.AB **SHEET No:** RO

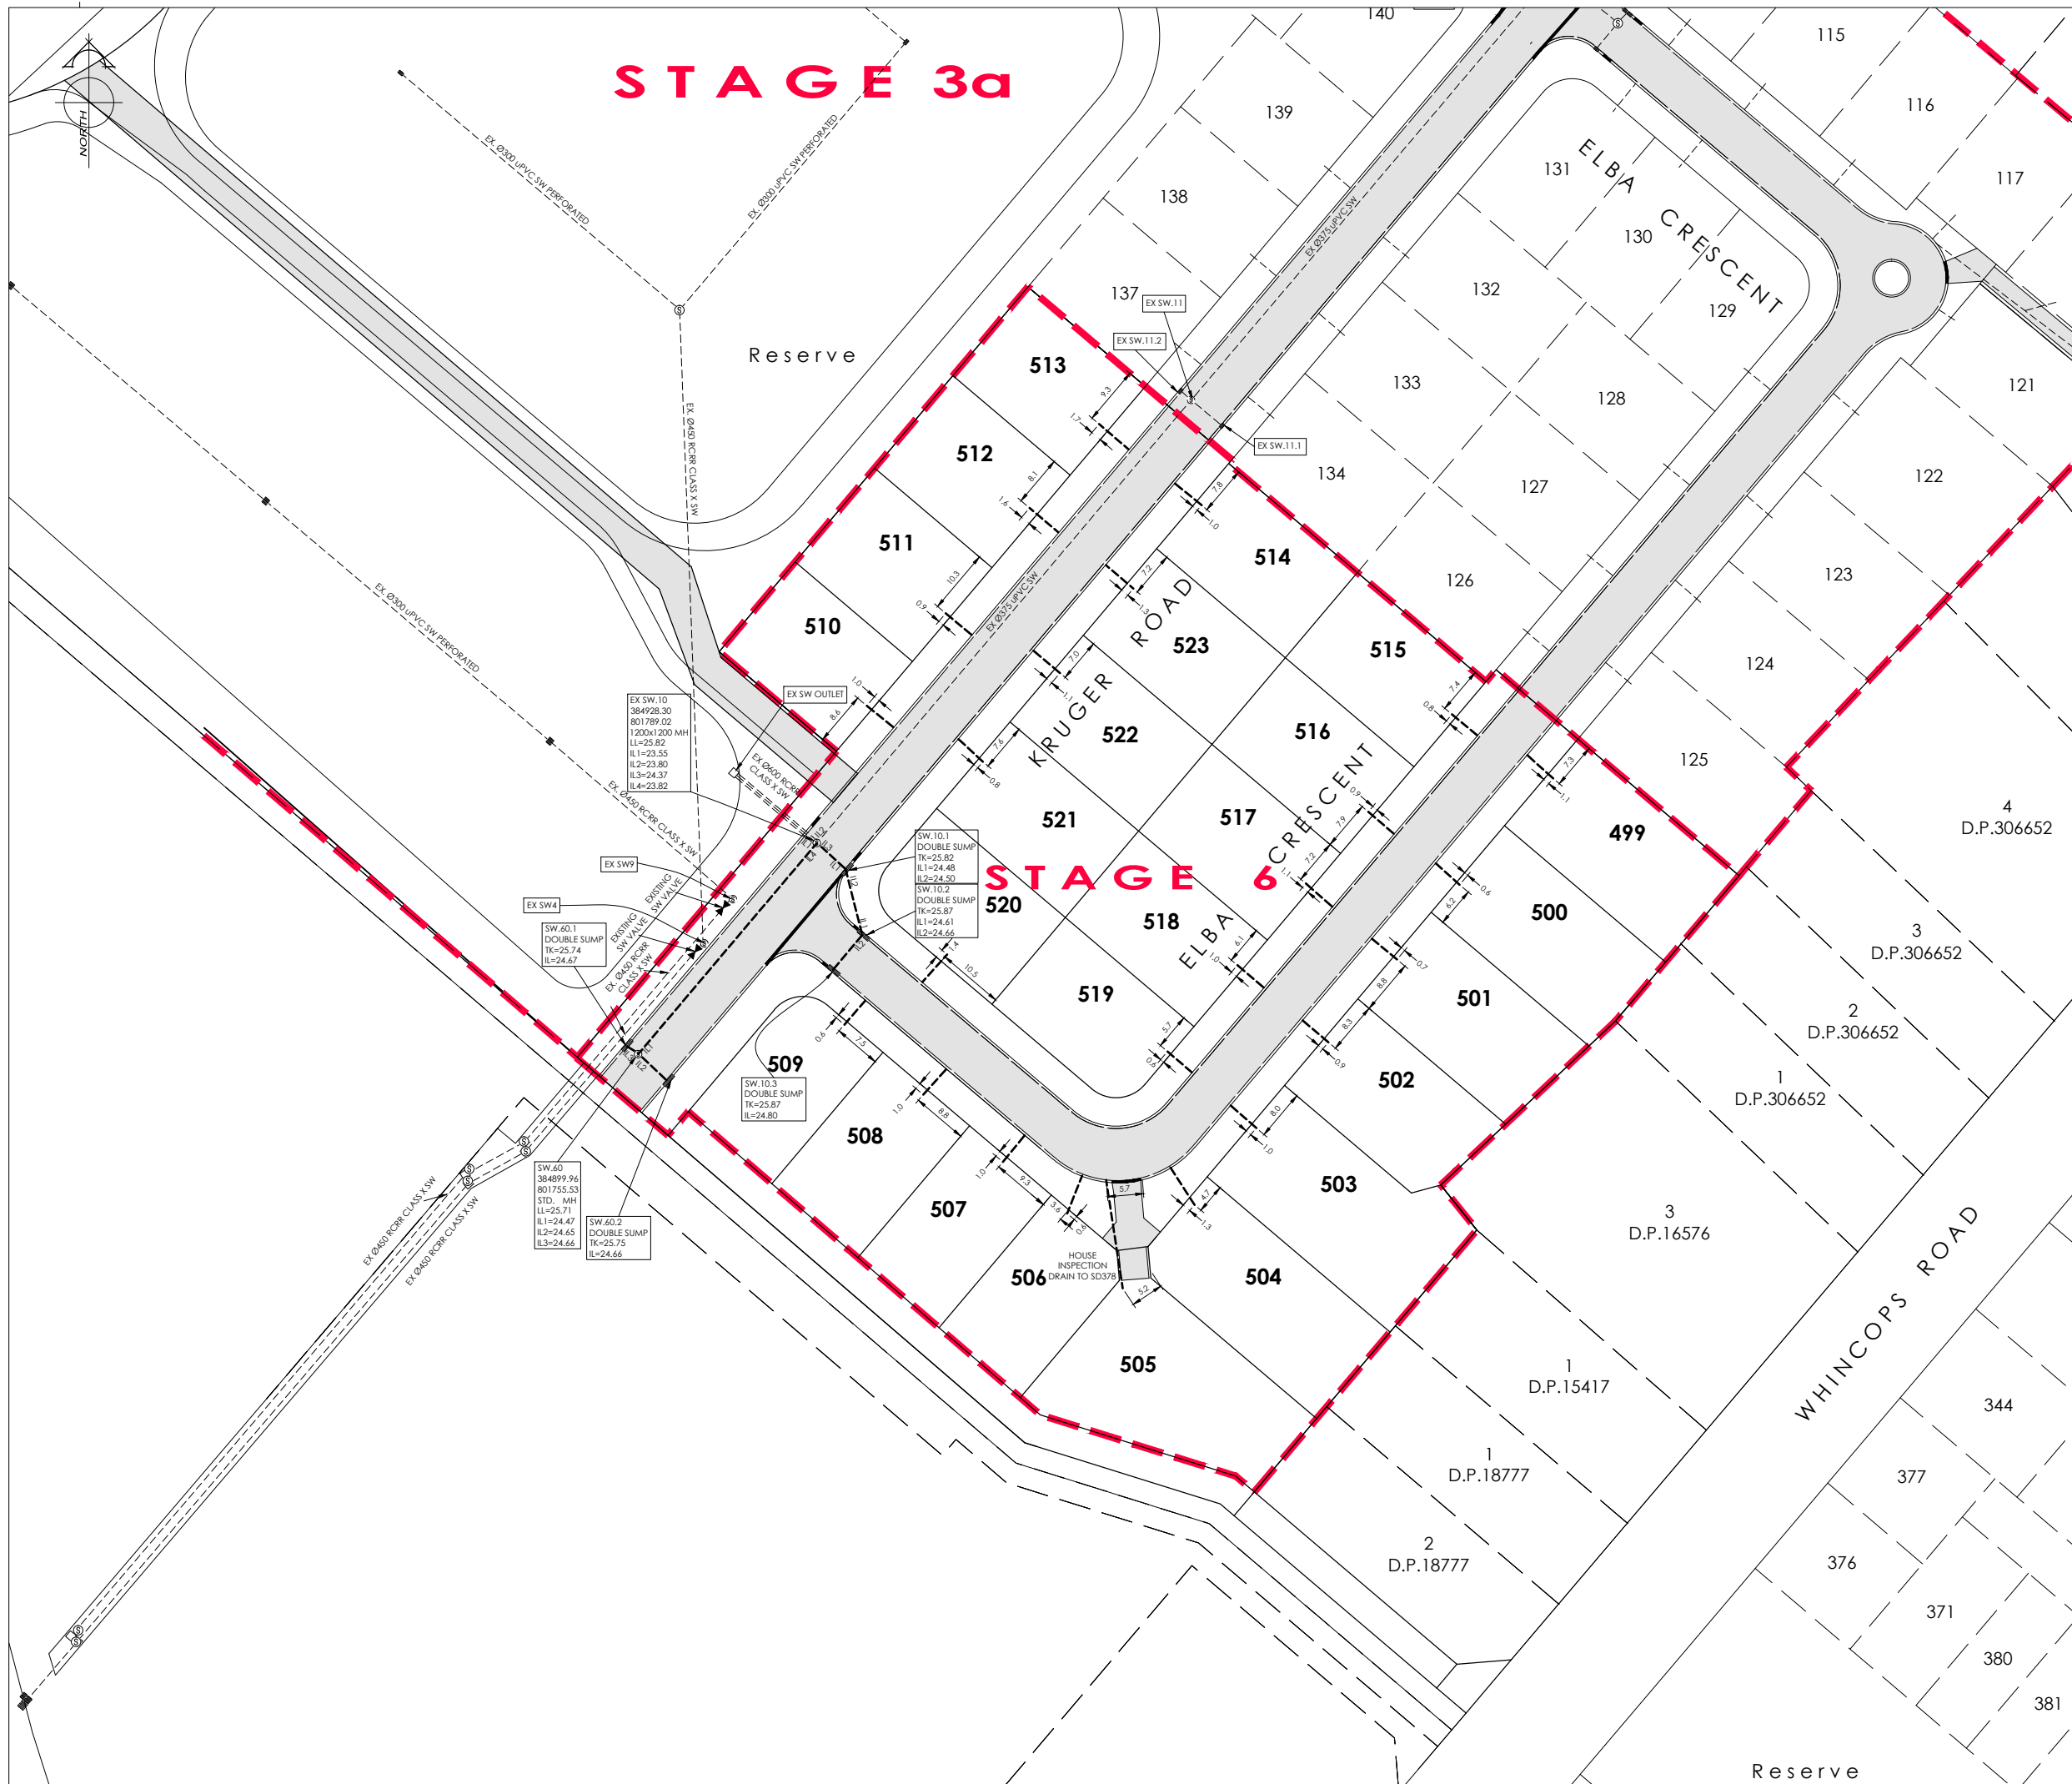

AMENDMENTS:		
AMENDMENT	DATE	DESCRIPTION

NOTES:

SERVICES

STORMWATER

KERB

NOTES:

- 1) ALL AS BUILT INFORMATION WAS PROVIDED BY FULTON HOGAN LIMITED & CITY CARE LIMITED AND NO LIABILITY IS ACCEPTED FOR THE ACCURACY OF THIS INFORMATION.
- 2) THIS PLAN HAS BEEN PREPARED FOR ASBUILT PURPOSES ONLY. NO LIABILITY IS ACCEPTED IF THE PLAN IS USED FOR ANY OTHER PURPOSE.
- 3) ANY MEASUREMENTS TAKEN FROM INFORMATION WHICH IS NOT DIMENSIONED ON THE ELECTRONIC COPY ARE AT THE RISK OF THE RECIPIENT.
- 4) ORIGIN OF LEVELS
BM.EHC6 RL=28.99
CORNER OF AWATEA & WIGRAM ROADS

LEVELS IN TERMS OF CHRISTCHURCH DRAINAGE DATUM.
JANUARY 2012 ISSUE

Fulton Hogan
LAND DEVELOPMENT LTD.

DAVIE LOVELL-SMITH
PLANNING SURVEYING ENGINEERING

116 Wrights Road P.O. Box: 679 Christchurch 8140. New Zealand
Telephone: 03 379-0793 E-mail: office@dls.co.nz

JOB TITLE:
**Fulton Hogan Land Development
Knights Stream Park
Stage 6**



SHEET TITLE:
**Stormwater Asbuilt
RMA92023522**

DRAWING STATUS:
Stage 6 - Asbuilt

SCALE: 1:500@A1 DATE: June 2014
1:1000@A3

CAD FILE: J:\18390\ASBUILT - STAGE 6\E18390.AB.DWG REVISION:
DRAWING No: SHEET No:
E.18390.6.SW.AB RO

STAGE 3a

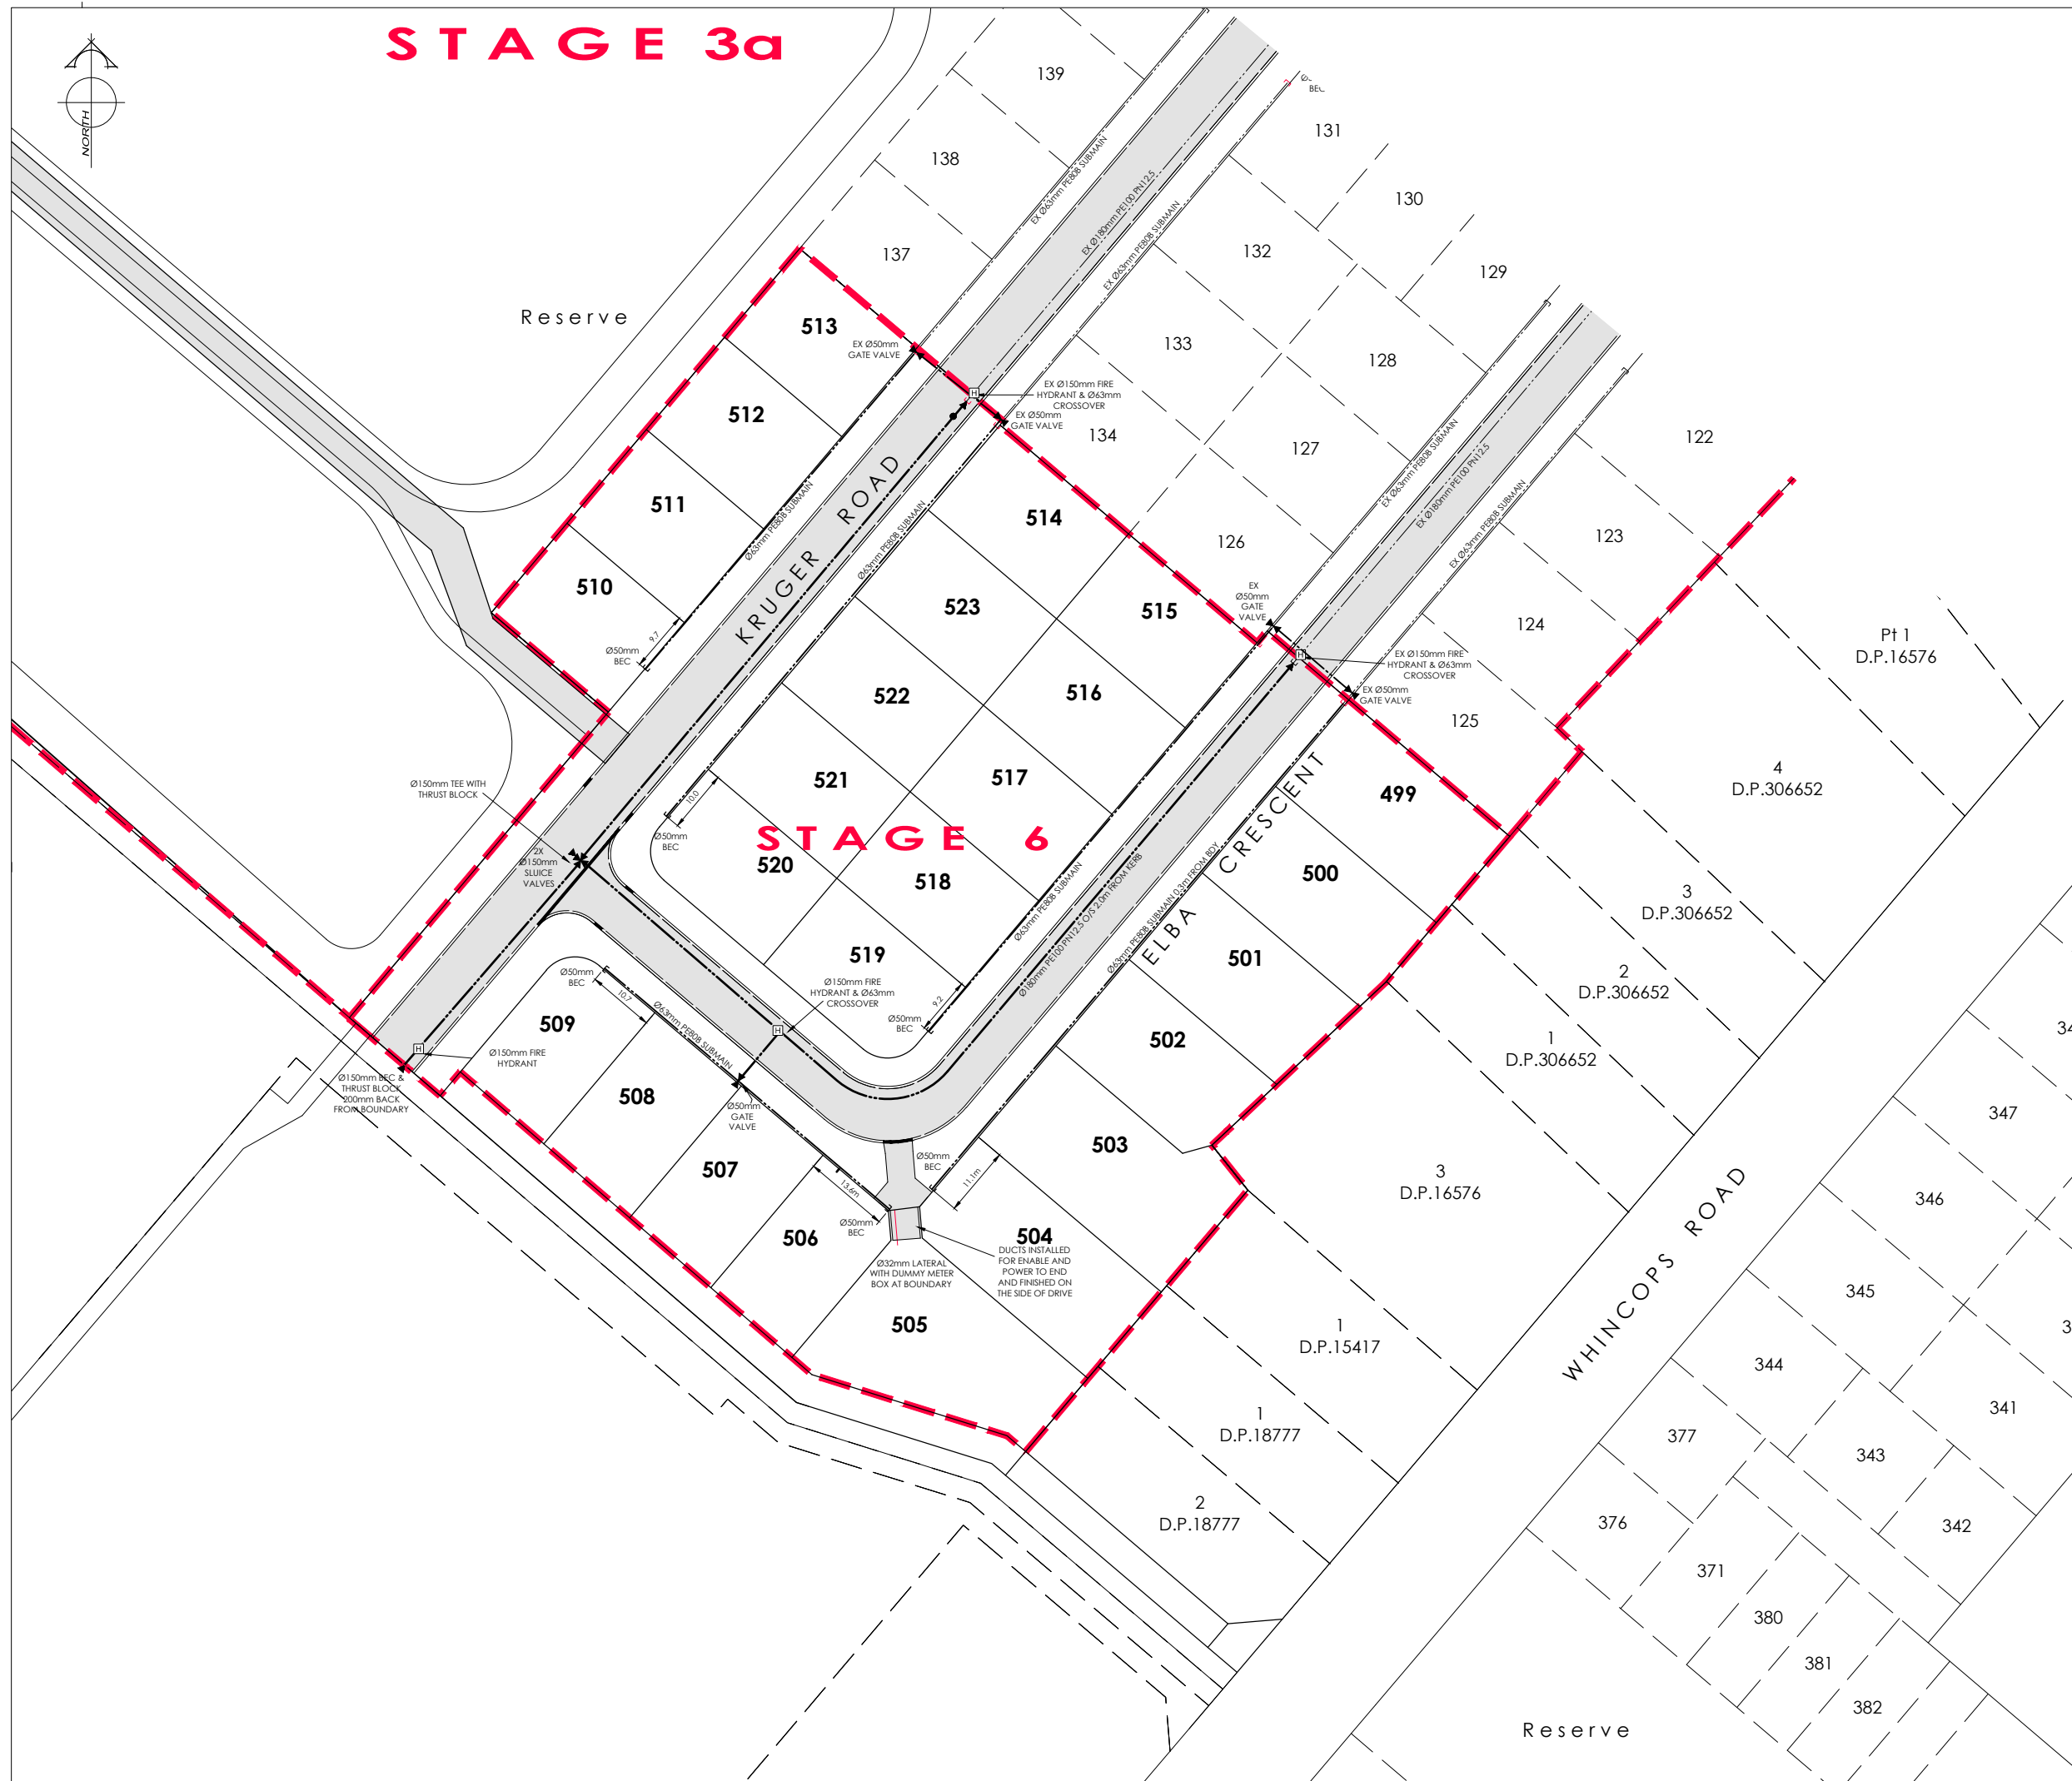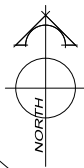

AMENDMENTS:		
AMENDMENT	DATE	DESCRIPTION

NOTES:

SERVICES

WATERMAIN VALVE

KERB

NOTES:

- 1) ALL AS BUILT INFORMATION WAS PROVIDED BY FULTON HOGAN LIMITED & CITY CARE LIMITED AND NO LIABILITY IS ACCEPTED FOR THE ACCURACY OF THIS INFORMATION.
- 2) THIS PLAN HAS BEEN PREPARED FOR ASBUILT PURPOSES ONLY. NO LIABILITY IS ACCEPTED IF THE PLAN IS USED FOR ANY OTHER PURPOSE.
- 3) ANY MEASUREMENTS TAKEN FROM INFORMATION WHICH IS NOT DIMENSIONED ON THE ELECTRONIC COPY ARE AT THE RISK OF THE RECIPIENT.
- 4) ORIGIN OF LEVELS
BM.EHC6 RL=28.99
CORNER OF AWATEA & WIGRAM ROADS

LEVELS IN TERMS OF CHRISTCHURCH DRAINAGE DATUM, JANUARY 2012 ISSUE

Fulton Hogan
LAND DEVELOPMENT LTD.

DAVIE LOVELL-SMITH
PLANNING SURVEYING ENGINEERING

116 Wrights Road P.O. Box: 679 Christchurch 8140, New Zealand
Telephone: 03 379-0793 E-mail: office@dls.co.nz

JOB TITLE:
**Fulton Hogan Land Development
Knights Stream Park
Stage 6**

SHEET TITLE:
**Water Asbuilt
RMA92023522**

DRAWING STATUS:
Stage 6 - Asbuilt

SCALE: 1:500@A1 DATE: June 2014
1:1000@A3

CAD FILE: J:\18390\ASBUILTS - STAGE 6\E18390.AB.DWG REVISION:
DRAWING No: SHEET No:
E.18390.6.W.AB RO