



AMENDMENTS:		
AMENDMENT	DATE	DESCRIPTION
R1	12.2.13	RAFTING ADDED

936

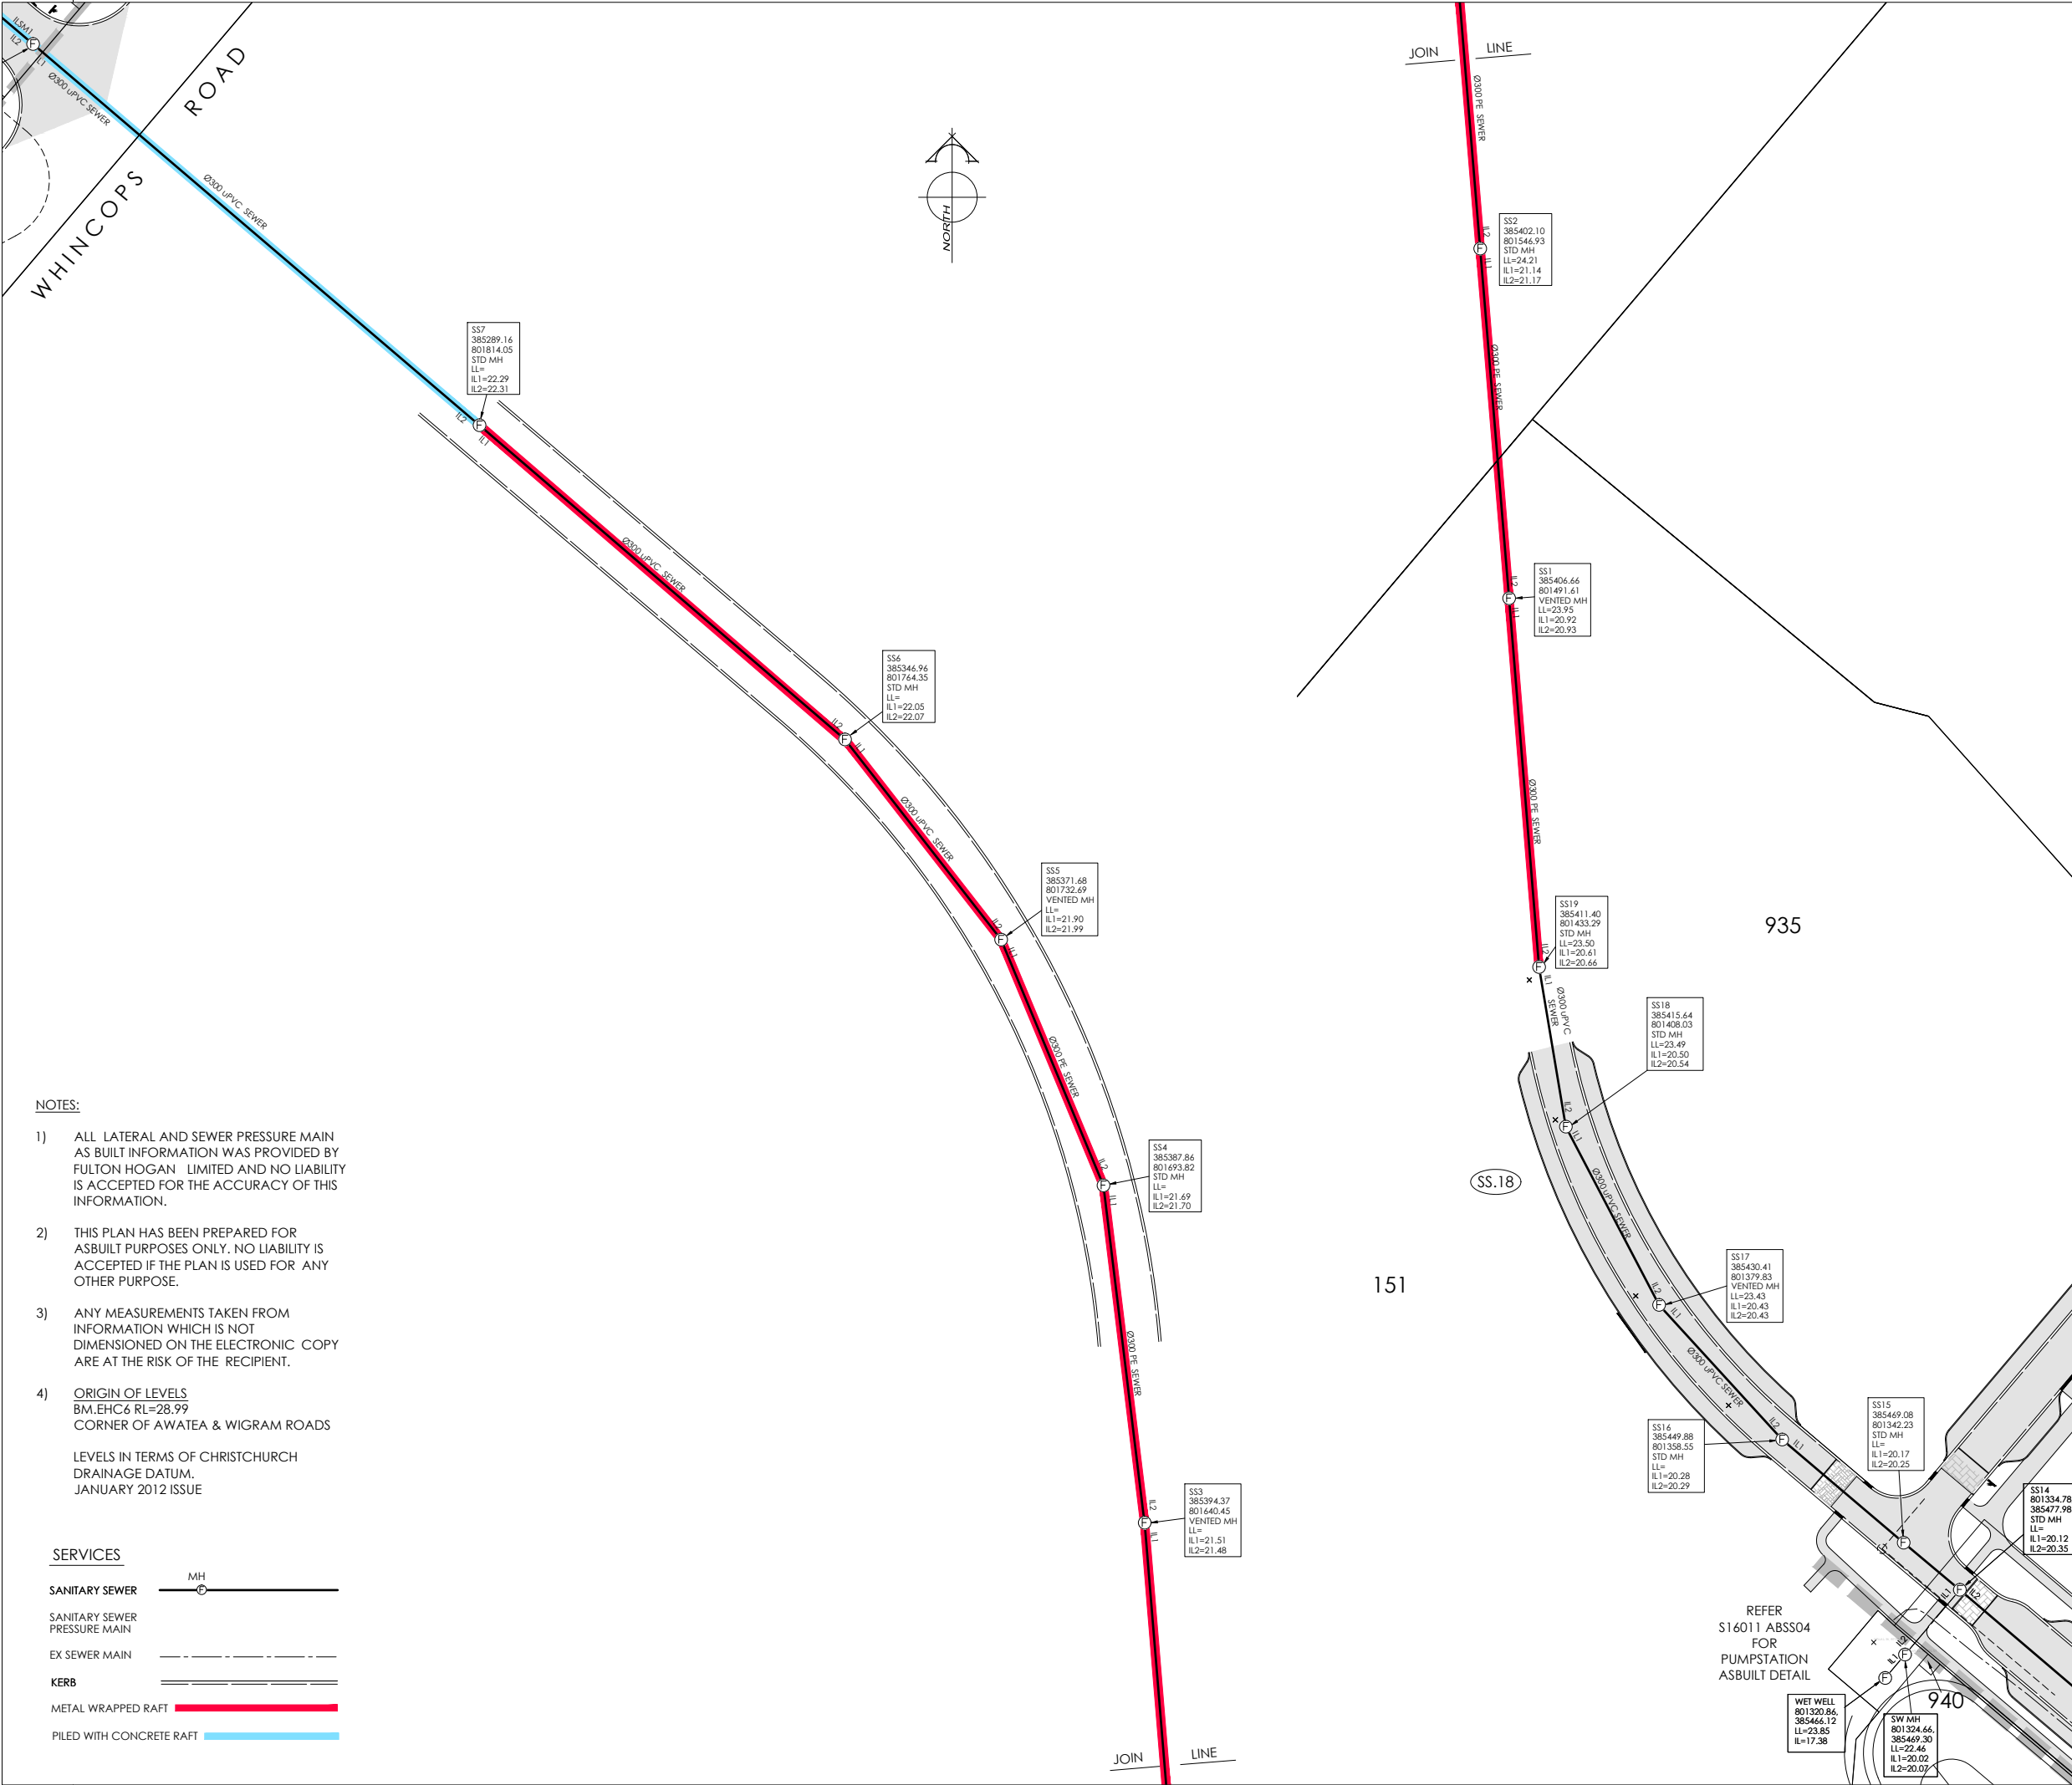


- NOTES:**
- 1) ALL LATERAL AND SEWER PRESSURE MAIN AS BUILT INFORMATION WAS PROVIDED BY FULTON HOGAN LIMITED AND NO LIABILITY IS ACCEPTED FOR THE ACCURACY OF THIS INFORMATION.
 - 2) THIS PLAN HAS BEEN PREPARED FOR ASBUILT PURPOSES ONLY. NO LIABILITY IS ACCEPTED IF THE PLAN IS USED FOR ANY OTHER PURPOSE.
 - 3) ANY MEASUREMENTS TAKEN FROM INFORMATION WHICH IS NOT DIMENSIONED ON THE ELECTRONIC COPY ARE AT THE RISK OF THE RECIPIENT.
 - 4) **ORIGIN OF LEVELS**
 BM.EHC6 RL=28.99
 CORNER OF AWATEA & WIGRAM ROADS

 LEVELS IN TERMS OF CHRISTCHURCH DRAINAGE DATUM, JANUARY 2012 ISSUE

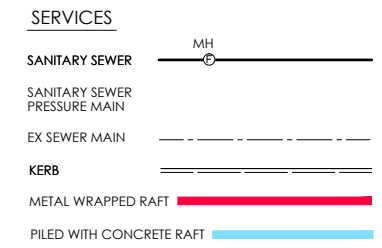

REFER S16011 ABSS04 FOR PUMPSTATION ASBUILT DETAIL



DAVIE LOVELL • SMITH
 PLANNING SURVEYING ENGINEERING

79 Cambridge Terrace P O Box 679 Christchurch 8140, New Zealand
 Telephone: 03 379-0793 Fax: 03 379-5664 E-mail: office@dls.co.nz

JOB TITLE:
Fulton Hogan Land Development Ltd Knights Stream


SHEET TITLE:
Sewer - Asbuilt RMA.92018802

DRAWING STATUS:
Asbuilt



SCALE: 1:500@A1 DATE: February 2013
 1:1000@A3

CAD FILE: J:\16011\Eng\Knights Stream\STAGE 4\Asbuilt\S16011.AB01 R2.dwg REVISION:
 DRAWING No: SHEET No:
S.16011 ABSS01 R.1

AMENDMENTS:		
AMENDMENT	DATE	DESCRIPTION
R1	12.2.13	RAFTING ADDED

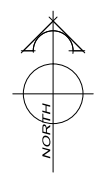

- NOTES:**
- 1) ALL LATERAL AND SEWER PRESSURE MAIN AS BUILT INFORMATION WAS PROVIDED BY FULTON HOGAN LIMITED & CITY CARE LIMITED AND NO LIABILITY IS ACCEPTED FOR THE ACCURACY OF THIS INFORMATION.
 - 2) THIS PLAN HAS BEEN PREPARED FOR ASBUILT PURPOSES ONLY. NO LIABILITY IS ACCEPTED IF THE PLAN IS USED FOR ANY OTHER PURPOSE.
 - 3) ANY MEASUREMENTS TAKEN FROM INFORMATION WHICH IS NOT DIMENSIONED ON THE ELECTRONIC COPY ARE AT THE RISK OF THE RECIPIENT.
 - 4) ORIGIN OF LEVELS
BM.EHC6 RL=28.99
CORNER OF AWATEA & WIGRAM ROADS
- LEVELS IN TERMS OF CHRISTCHURCH DRAINAGE DATUM, JANUARY 2012 ISSUE

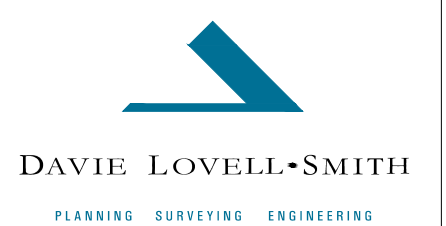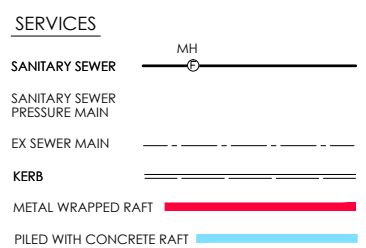

79 Cambridge Terrace P O Box 679 Christchurch 8140, New Zealand
Telephone: 03 379-0793 Fax: 03 379-5664 E-mail: office@dls.co.nz

JOB TITLE:
Fulton Hogan Land Development Ltd
Knights Stream


SHEET TITLE:
Sewer - Asbuilt
RMA.92018802

DRAWING STATUS:
Asbuilt

SCALE: 1:500@A1 DATE: February 2013
1:1000@A3

CAD FILE: J:\16011\Eng\Knights Stream\STAGE 4\Asbuilt\16011.A801 R2.dwg REVISION:
DRAWING No: S.16011 SHEET No: ABSS02 R.1


AMENDMENTS:		
AMENDMENT	DATE	DESCRIPTION
R1	12.2.13	RAFTING ADDED

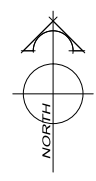

2
D.P.360125



- NOTES:**
- 1) ALL LATERAL AND SEWER PRESSURE MAIN AS BUILT INFORMATION WAS PROVIDED BY FULTON HOGAN LIMITED & CITY CARE LIMITED AND NO LIABILITY IS ACCEPTED FOR THE ACCURACY OF THIS INFORMATION.
 - 2) THIS PLAN HAS BEEN PREPARED FOR ASBUILT PURPOSES ONLY. NO LIABILITY IS ACCEPTED IF THE PLAN IS USED FOR ANY OTHER PURPOSE.
 - 3) ANY MEASUREMENTS TAKEN FROM INFORMATION WHICH IS NOT DIMENSIONED ON THE ELECTRONIC COPY ARE AT THE RISK OF THE RECIPIENT.
 - 4) ORIGIN OF LEVELS
BM.EHC6 RL=28.99
CORNER OF AWATEA & WIGRAM ROADS
LEVELS IN TERMS OF CHRISTCHURCH DRAINAGE DATUM.
JANUARY 2012 ISSUE

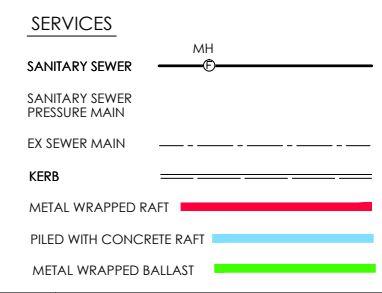

DAVIE LOVELL • SMITH
PLANNING SURVEYING ENGINEERING

79 Cambridge Terrace P O Box 679 Christchurch 8140, New Zealand
Telephone: 03 379-0793 Fax: 03 379-5664 E-mail: office@dls.co.nz

JOB TITLE: Fulton Hogan Land Development Ltd Knights Stream

SHEET TITLE: Sewer - Asbuilt RMA.92018802

DRAWING STATUS: Asbuilt

SCALE: 1:500@A1 DATE: February 2013
1:1000@A3

CAD FILE: J:\16011\Eng\knights Stream\STAGE 4\Asbuilt\S16011.AB01 R2.dwg REVISION:
DRAWING No: S.16011 SHEET No: ABSS03 R.1



AMENDMENTS:		
AMENDMENT	DATE	DESCRIPTION
R1	12.2.13	RAFTING ADDED

NOTES:


- 1) ALL LATERAL AS BUILT INFORMATION WAS PROVIDED BY FULTON HOGAN LIMITED & CITY CARE LIMITED AND NO LIABILITY IS ACCEPTED FOR THE ACCURACY OF THIS INFORMATION.
- 2) THIS PLAN HAS BEEN PREPARED FOR ASBUILT PURPOSES ONLY. NO LIABILITY IS ACCEPTED IF THE PLAN IS USED FOR ANY OTHER PURPOSE.
- 3) ANY MEASUREMENTS TAKEN FROM INFORMATION WHICH IS NOT DIMENSIONED ON THE ELECTRONIC COPY ARE AT THE RISK OF THE RECIPIENT.
- 4) ORIGIN OF LEVELS
BM.EHC6 RL=28.99
CORNER OF AWATEA & WIGRAM ROADS

LEVELS IN TERMS OF CHRISTCHURCH DRAINAGE DATUM.
JANUARY 2012 ISSUE

SERVICES

STORMWATER --- MH ---
GROUNDWATER --- MH ---
KERB ---
METAL WRAPPED RAFT ---

NAME	SIGNED	DATE
DESIGNED BY: MATTHEW WENBORN		
CHECKED BY: ANDY HALL		



DAVIE LOVELL • SMITH
PLANNING SURVEYING ENGINEERING

79 Cambridge Terrace P O Box 679 Christchurch 8140, New Zealand
Telephone: 03 379-0793 Fax: 03 379-5664 E-mail: office@dls.co.nz


JOB TITLE:
Fulton Hogan Land Development Ltd Knights Stream

SHEET TITLE:
Stormwater - Asbuilt RMA.92018802


DRAWING STATUS:
Asbuilt

SCALE: 1:500@A1 DATE: February 2013
1:1000@A3

CAD FILE: J:\16011\Eng\Knights Stream\STAGE 4\Asbuilt\16011.AB01 R2.dwg REVISION:
DRAWING No.: S.16011 ABSW01 SHEET No.: R.1

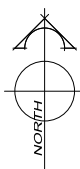

2
D.P.360125

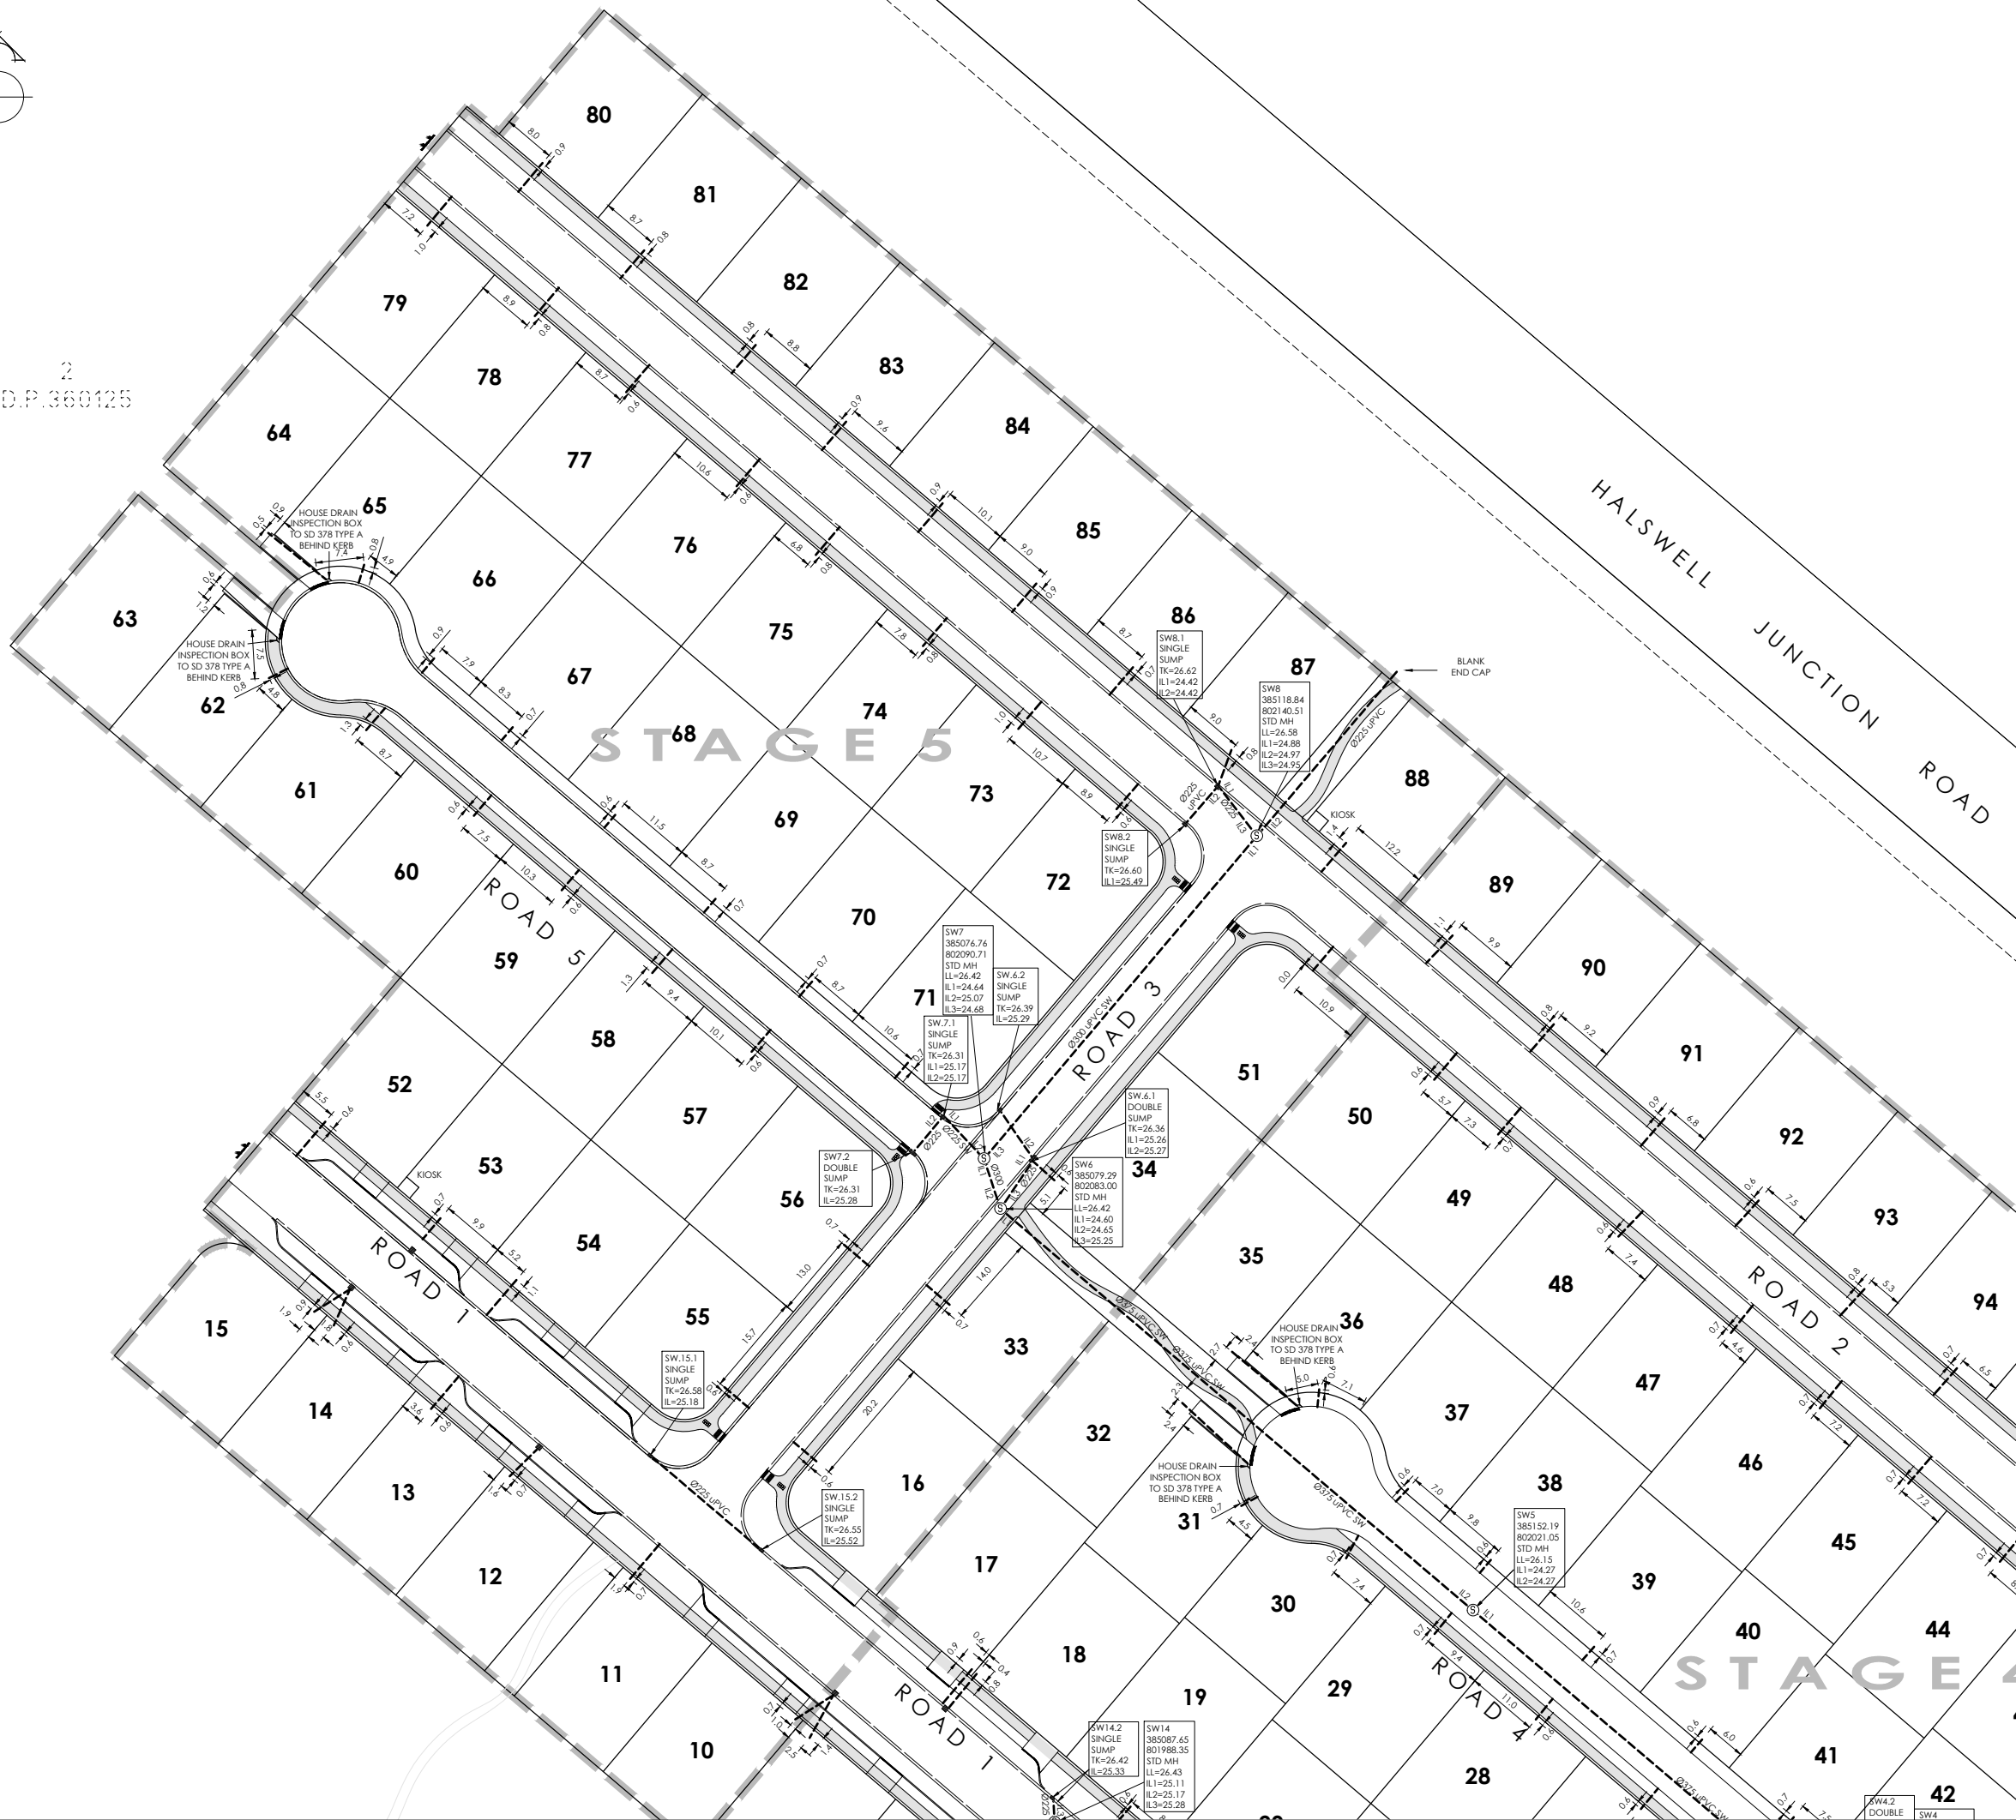


AMENDMENTS:		
AMENDMENT	DATE	DESCRIPTION
R1	12.2.13	RAFTING ADDED

NOTES:

- 1) ALL LATERAL AS BUILT INFORMATION WAS PROVIDED BY FULTON HOGAN LIMITED & CITY CARE LIMITED AND NO LIABILITY IS ACCEPTED FOR THE ACCURACY OF THIS INFORMATION.
- 2) THIS PLAN HAS BEEN PREPARED FOR ASBUILT PURPOSES ONLY. NO LIABILITY IS ACCEPTED IF THE PLAN IS USED FOR ANY OTHER PURPOSE.
- 3) ANY MEASUREMENTS TAKEN FROM INFORMATION WHICH IS NOT DIMENSIONED ON THE ELECTRONIC COPY ARE AT THE RISK OF THE RECIPIENT.
- 4) ORIGIN OF LEVELS
BM.EHC6 RL=28.99
CORNER OF AWATEA & WIGRAM ROADS

LEVELS IN TERMS OF CHRISTCHURCH DRAINAGE DATUM.
JANUARY 2012 ISSUE

SERVICES

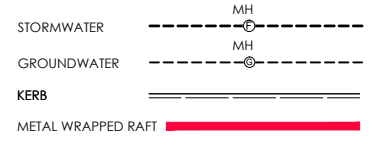

NAME	SIGNED	DATE
DESIGNED BY MATTHEW WENBORN		
CHECKED BY ANDY HALL		



DAVIE LOVELL • SMITH
PLANNING SURVEYING ENGINEERING

79 Cambridge Terrace P O Box 679 Christchurch 8140, New Zealand
Telephone: 03 379-0793 Fax: 03 379-5664 E-mail: office@dls.co.nz


JOB TITLE:
Fulton Hogan Land Development Ltd
Knights Stream

SHEET TITLE:
Stormwater - Asbuilt
RMA.92018802

DRAWING STATUS:
Asbuilt


SCALE: 1:500@A1
1:1000@A3 **DATE:** February 2013

CAD FILE: J:\16011\Eng\Knights Stream\STAGE 4\Asbuilt\16011.AB01 R2.dwg **REVISION:**
DRAWING No: S.16011 **SHEET No:** ABSW02 **R.1**

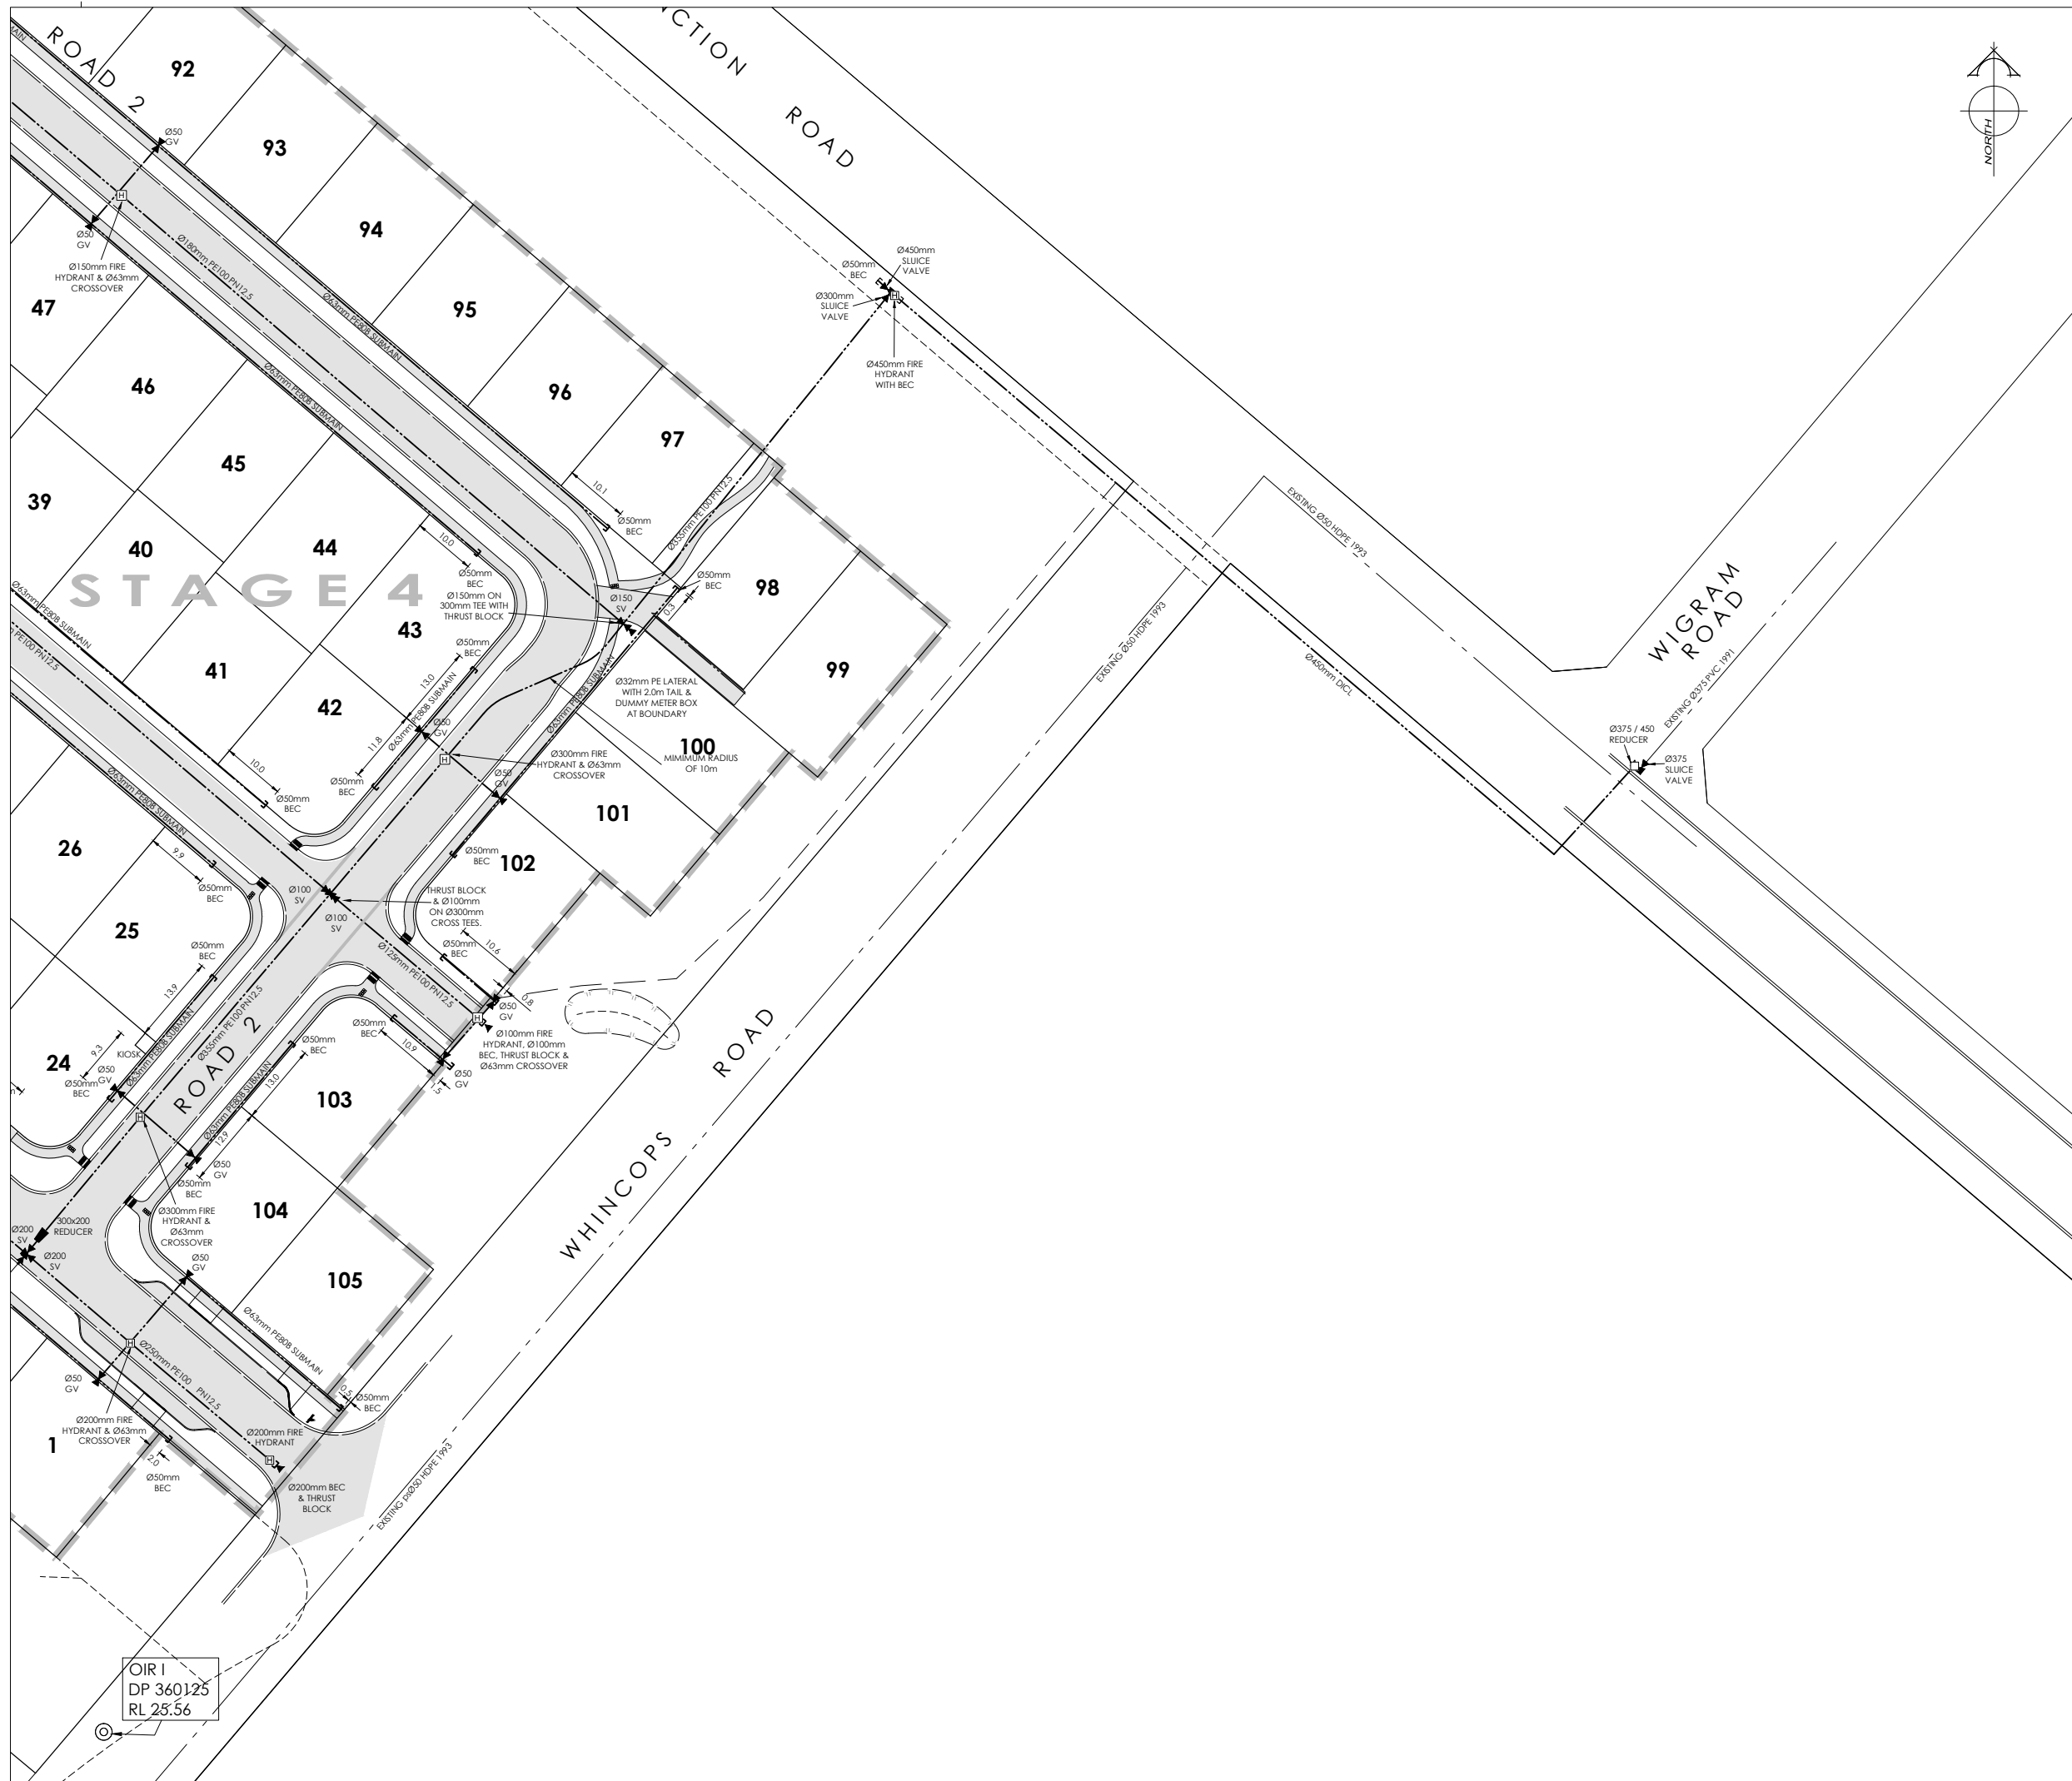

AMENDMENTS:		
AMENDMENT	DATE	DESCRIPTION
R1	12.2.13	RAFTING ADDED

- NOTES:**
- 1) ALL AS BUILT INFORMATION WAS PROVIDED BY FULTON HOGAN LIMITED & CITY CARE LIMITED AND NO LIABILITY IS ACCEPTED FOR THE ACCURACY OF THIS INFORMATION.
 - 2) THIS PLAN HAS BEEN PREPARED FOR ASBUILT PURPOSES ONLY. NO LIABILITY IS ACCEPTED IF THE PLAN IS USED FOR ANY OTHER PURPOSE.
 - 3) ANY MEASUREMENTS TAKEN FROM INFORMATION WHICH IS NOT DIMENSIONED ON THE ELECTRONIC COPY ARE AT THE RISK OF THE RECIPIENT.
 - 4) ORIGIN OF LEVELS
 BM.EHC 6 RL=28.99
 CORNER OF AWATEA & WIGRAM ROADS
 LEVELS IN TERMS OF CHRISTCHURCH DRAINAGE DATUM, JANUARY 2012 ISSUE

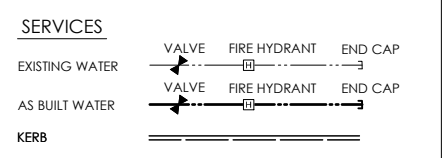

	NAME	SIGNED	DATE
DESIGNED BY	MATTHEW WENBORN		
CHECKED BY	ANDY HALL		

DAVIE LOVELL • SMITH
 PLANNING SURVEYING ENGINEERING

79 Cambridge Terrace P O Box 679 Christchurch 8140, New Zealand
 Telephone: 03 379-0793 Fax: 03 379-5664 E-mail: office@dls.co.nz

JOB TITLE:
 Fulton Hogan Land Development Ltd
 Knights Stream


SHEET TITLE:
 Water - Asbuilt
 RMA.92018802

DRAWING STATUS:
 Asbuilt

SCALE: 1:500@A1 DATE: March 2013
 1:1000@A3

CAD FILE:	SHEET No:	REVISION:
S.16011	ABW01	R.1

OIR 1
 DP 360125
 RL 25.56

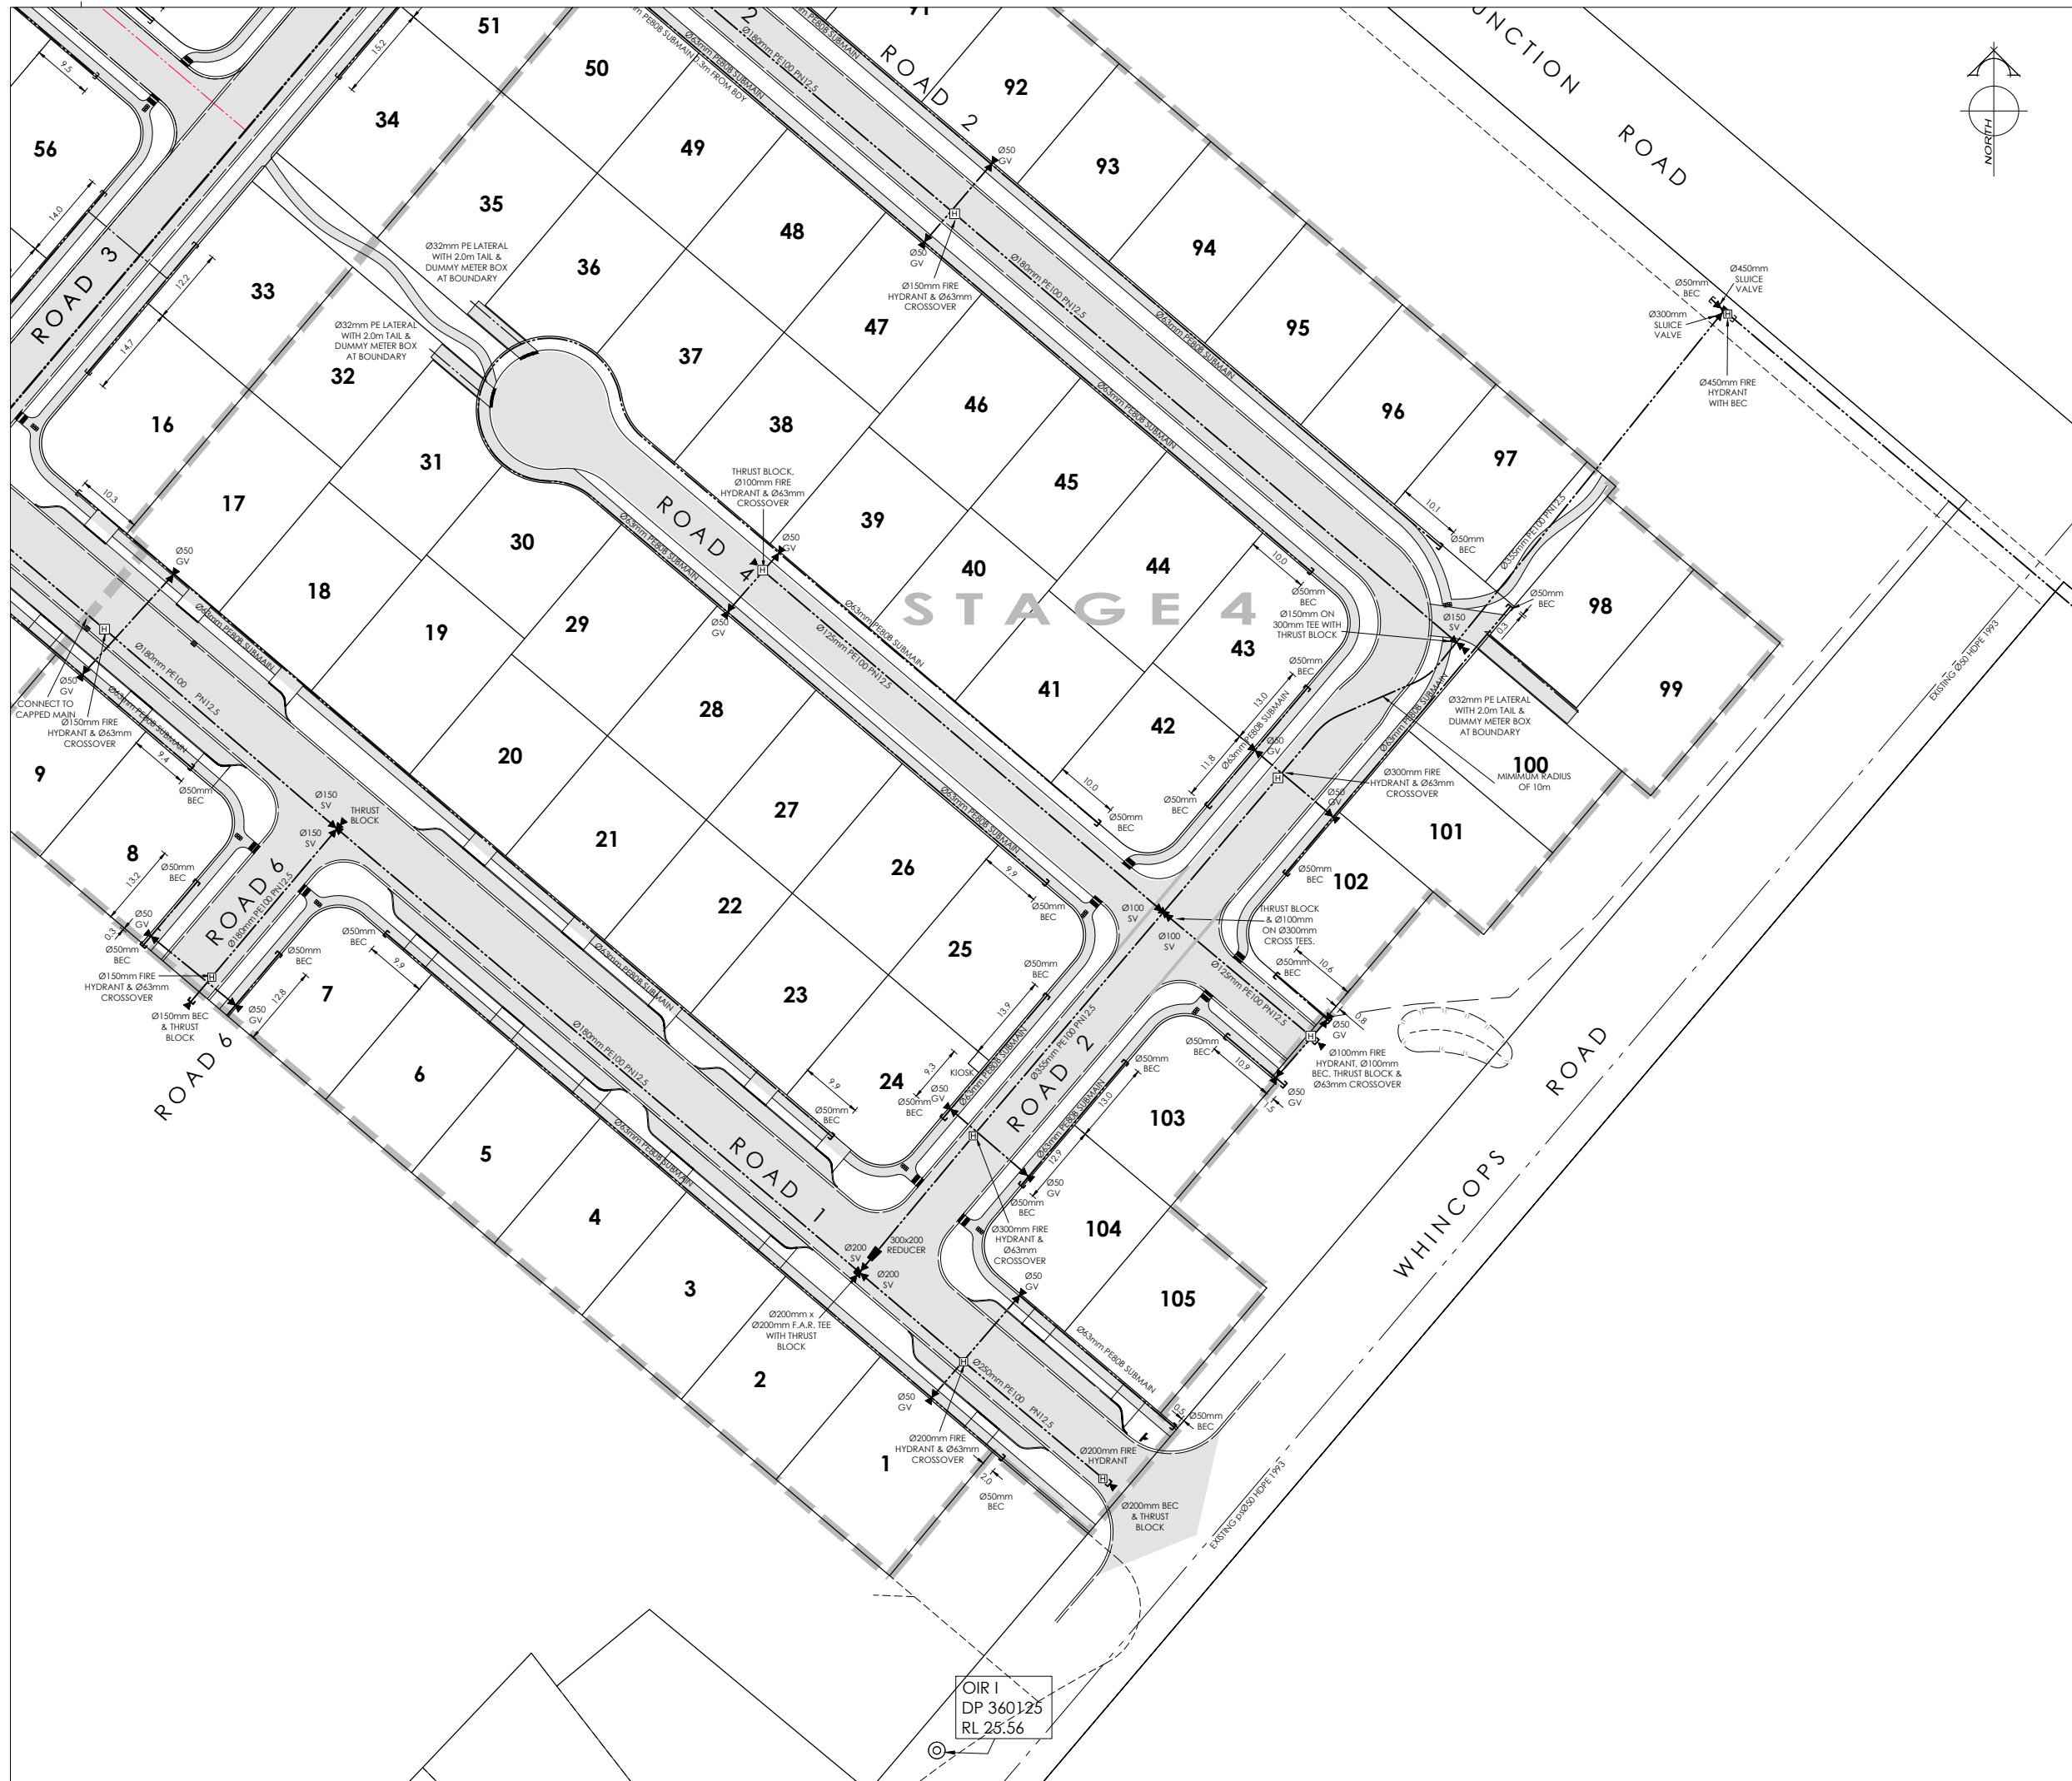


AMENDMENT	DATE	DESCRIPTION
R1	12.2.13	RAFTING ADDED


NOTES:

- 1) ALL AS BUILT INFORMATION WAS PROVIDED BY FULTON HOGAN LIMITED & CITY CARE LIMITED AND NO LIABILITY IS ACCEPTED FOR THE ACCURACY OF THIS INFORMATION.
- 2) THIS PLAN HAS BEEN PREPARED FOR ASBUILT PURPOSES ONLY. NO LIABILITY IS ACCEPTED IF THE PLAN IS USED FOR ANY OTHER PURPOSE.
- 3) ANY MEASUREMENTS TAKEN FROM INFORMATION WHICH IS NOT DIMENSIONED ON THE ELECTRONIC COPY ARE AT THE RISK OF THE RECIPIENT.
- 4) ORIGIN OF LEVELS
BM.EHC 6 RL=28.99
CORNER OF AWATEA & WIGRAM ROADS

LEVELS IN TERMS OF CHRISTCHURCH DRAINAGE DATUM.
JANUARY 2012 ISSUE

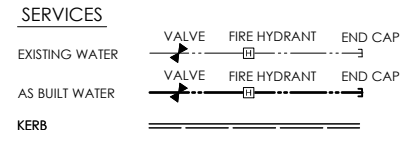

DESIGNED BY	NAME	SIGNED	DATE
DESIGNED BY	MATTHEW WENBORN		
CHECKED BY	ANDY HALL		

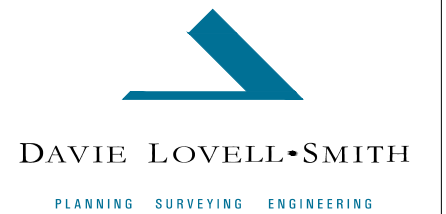

79 Cambridge Terrace P O Box 679 Christchurch 8140, New Zealand
Telephone: 03 379-0793 Fax: 03 379-5664 E-mail: office@dls.co.nz

JOB TITLE:
Fulton Hogan Land Development Ltd
Knights Stream


SHEET TITLE:
Water - Asbuilt
RMA.92018802

DRAWING STATUS:
Asbuilt

SCALE: 1:500@A1 DATE: March 2013
1:1000@A3


DRAWING No:	SHEET No:	REVISION:
S.16011	ABW02	R.1

2
D.P.360125

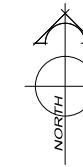

AMENDMENTS:		
AMENDMENT	DATE	DESCRIPTION
R1	12.2.13	RAFTING ADDED

- NOTES:
- 1) ALL AS BUILT INFORMATION WAS PROVIDED BY FULTON HOGAN LIMITED & CITY CARE LIMITED AND NO LIABILITY IS ACCEPTED FOR THE ACCURACY OF THIS INFORMATION.
 - 2) THIS PLAN HAS BEEN PREPARED FOR ASBUILT PURPOSES ONLY. NO LIABILITY IS ACCEPTED IF THE PLAN IS USED FOR ANY OTHER PURPOSE.
 - 3) ANY MEASUREMENTS TAKEN FROM INFORMATION WHICH IS NOT DIMENSIONED ON THE ELECTRONIC COPY ARE AT THE RISK OF THE RECIPIENT.
 - 4) ORIGIN OF LEVELS
BM.EHC6 RL=28.99
CORNER OF AWATEA & WIGRAM ROADS
- LEVELS IN TERMS OF CHRISTCHURCH DRAINAGE DATUM.
JANUARY 2012 ISSUE

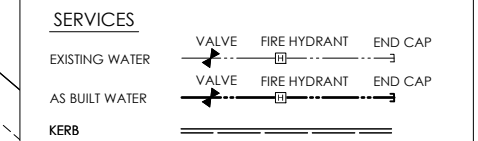

NAME	SIGNED	DATE
DESIGNED BY: MATTHEW WENBORN		
CHECKED BY: ANDY HALL		

DAVIE LOVELL • SMITH
PLANNING SURVEYING ENGINEERING

79 Cambridge Terrace P O Box 679 Christchurch 8140, New Zealand
Telephone: 03 379-0793 Fax: 03 379-5664 E-mail: office@dls.co.nz

JOB TITLE:
Fulton Hogan Land Development Ltd Knights Stream

SHEET TITLE:
Water - Asbuilt RMA.92018802

DRAWING STATUS:
Asbuilt

SCALE: 1:500@A1 DATE: March 2013
1:1000@A3

CAD FILE:
DRAWING No: **S.16011 ABW03** SHEET No: **R.1**

