



AMENDMENTS:		
AMENDMENT	DATE	DESCRIPTION

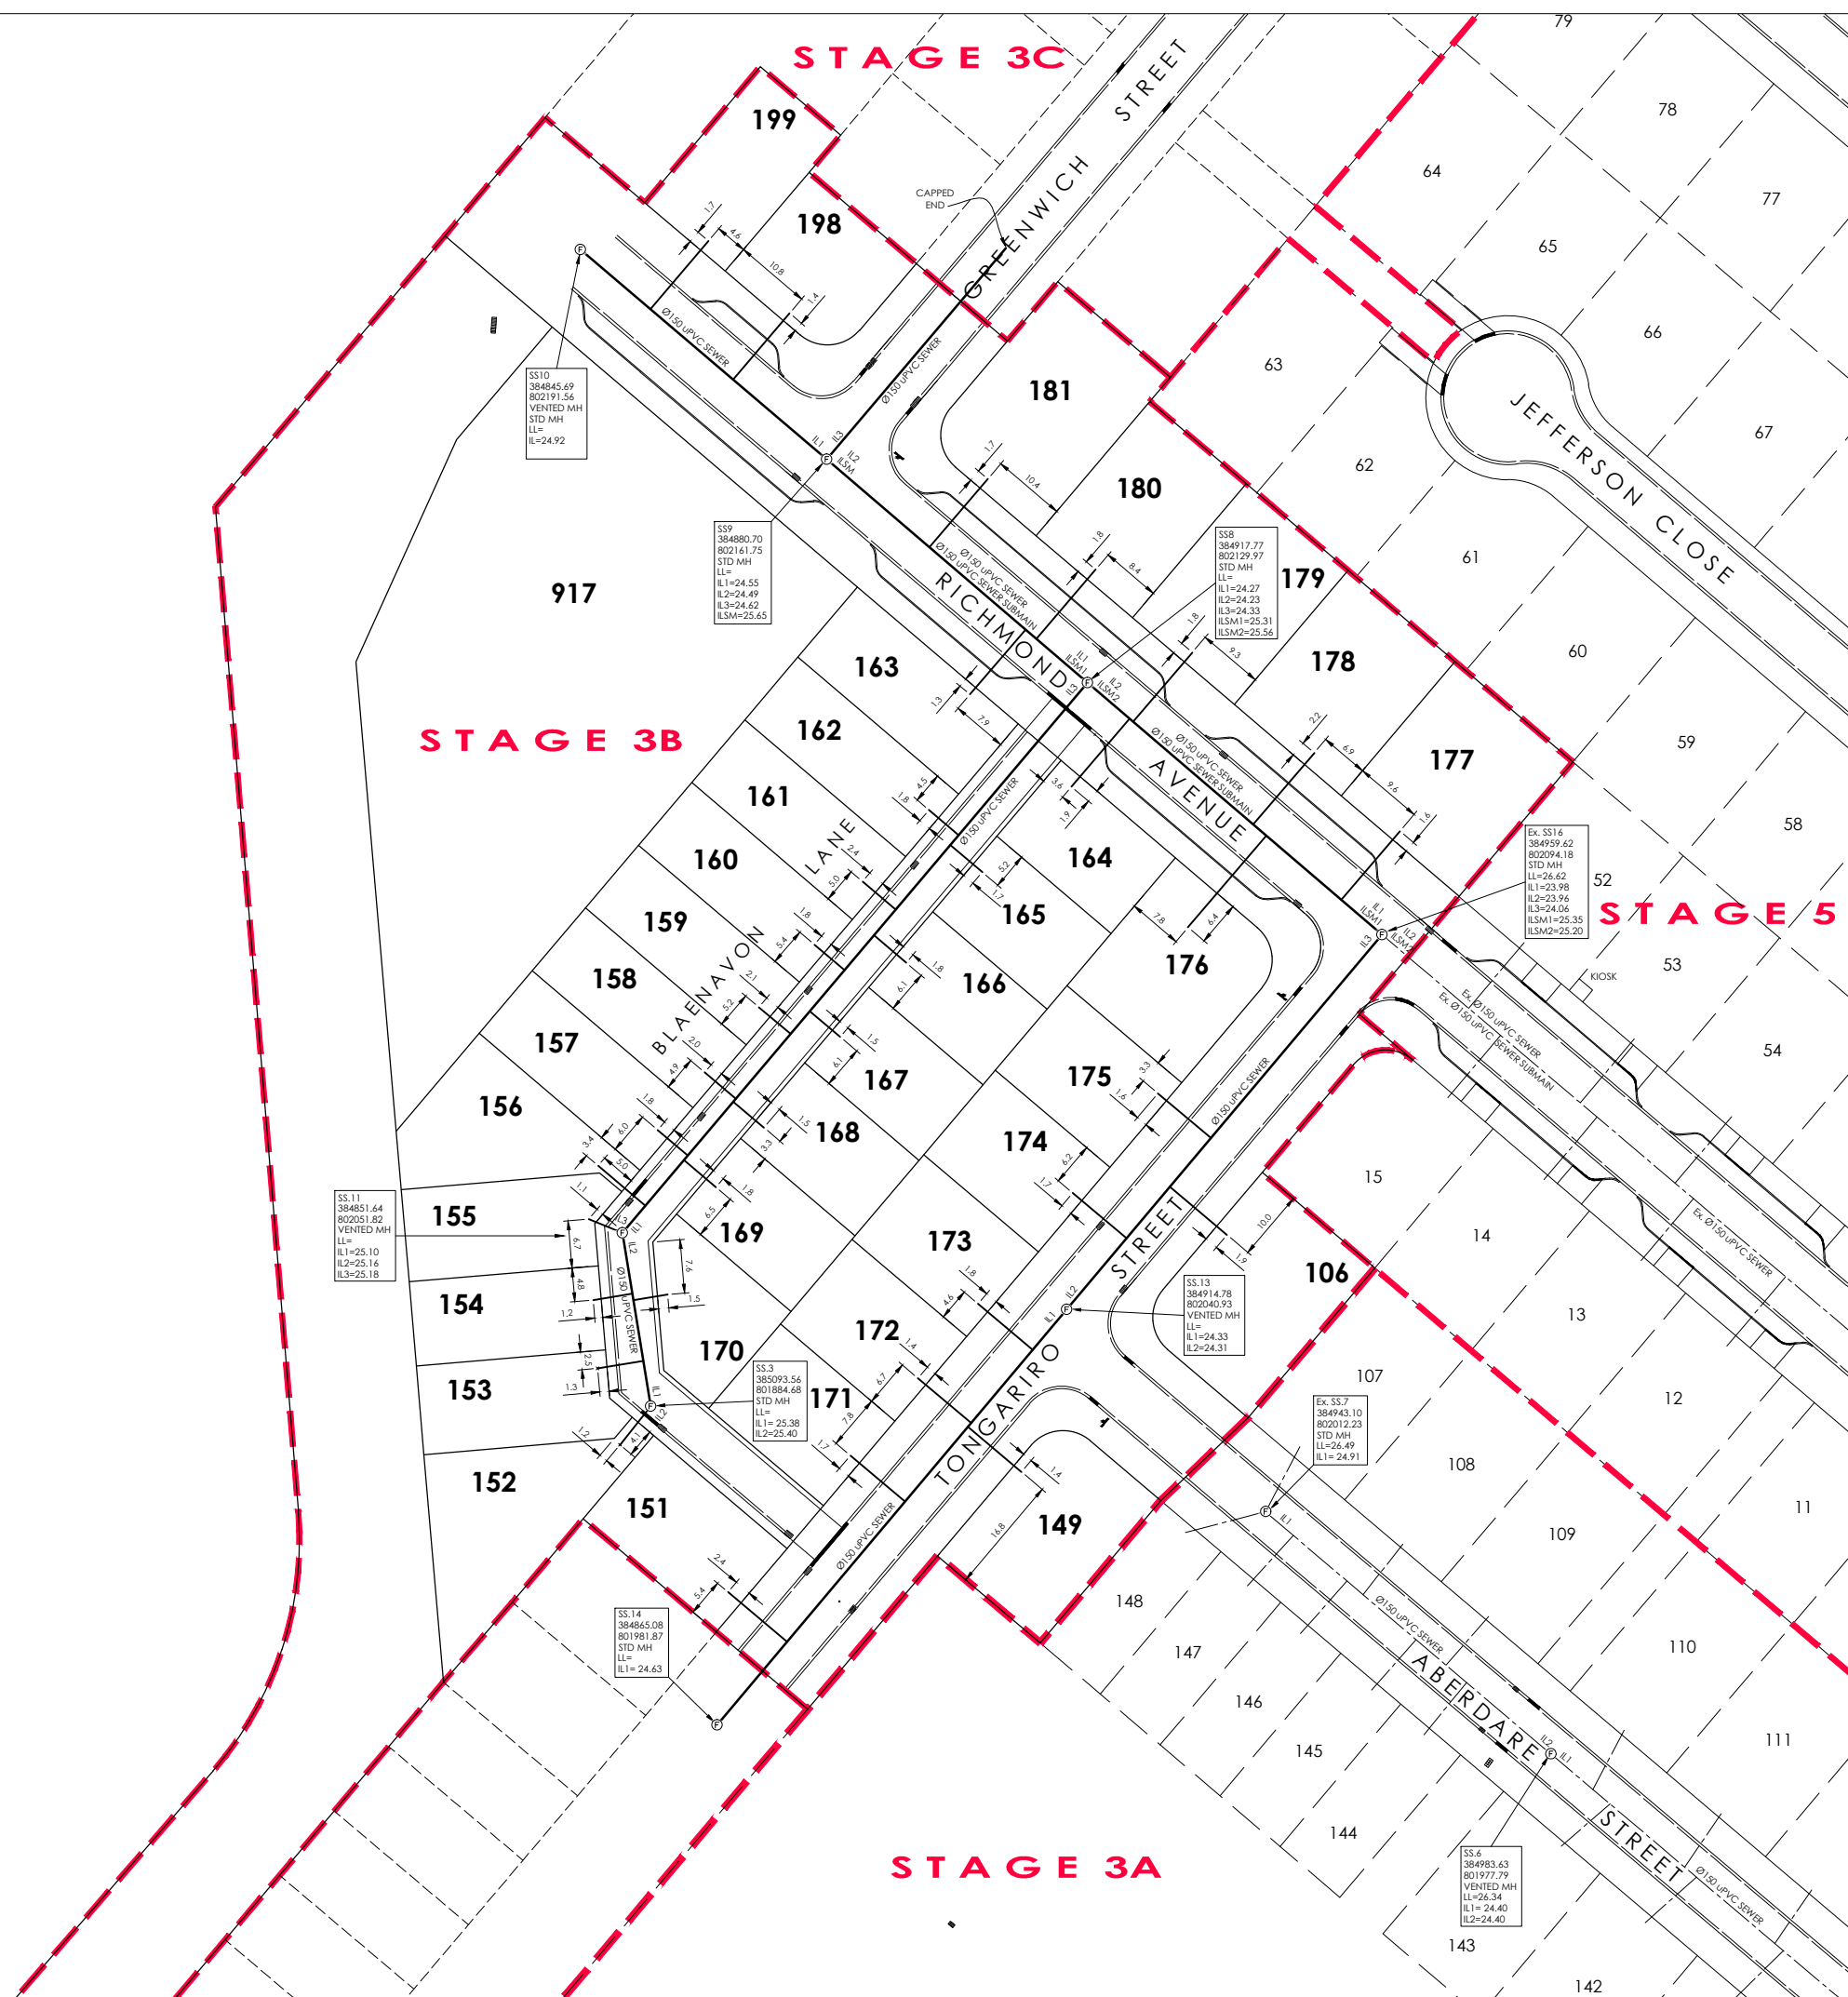

SERVICES

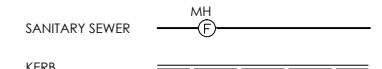

NOTES:

- 1) ALL LATERAL AND SEWER PRESSURE MAIN AS BUILT INFORMATION WAS PROVIDED BY FULTON HOGAN LIMITED & CITY CARE LIMITED AND NO LIABILITY IS ACCEPTED FOR THE ACCURACY OF THIS INFORMATION.
- 2) THIS PLAN HAS BEEN PREPARED FOR ASBUILT PURPOSES ONLY. NO LIABILITY IS ACCEPTED IF THE PLAN IS USED FOR ANY OTHER PURPOSE.
- 3) ANY MEASUREMENTS TAKEN FROM INFORMATION WHICH IS NOT DIMENSIONED ON THE ELECTRONIC COPY ARE AT THE RISK OF THE RECIPIENT.
- 4) ORIGIN OF LEVELS
 BM.EHC6 RL=28.99
 CORNER OF AWATEA & WIGRAM ROADS
 LEVELS IN TERMS OF CHRISTCHURCH DRAINAGE DATUM, JANUARY 2012 ISSUE



79 Cambridge Terrace P O Box 679 Christchurch 8140 New Zealand
 Telephone: 03 379-0793 Fax: 03 379-5664 E-mail: office@ds.co.nz


JOB TITLE:
**Fulton Hogan Land Development
 Knights Stream Park**

SHEET TITLE:
Sewer Asbuilt


DRAWING STATUS:
Stage 3B - Asbuilt

SCALE: 1:500@A1 DATE: January 2013
 1:1000@A3


CAD FILE: J:\18022\Eng\CIVIL\3B\Asbuilt\18022.3B.AB01.R0.dwg REVISION:
 DRAWING No: SHEET No:
E.18022.3B.SS.AB01 **R0**

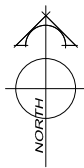

AMENDMENTS:		
AMENDMENT	DATE	DESCRIPTION

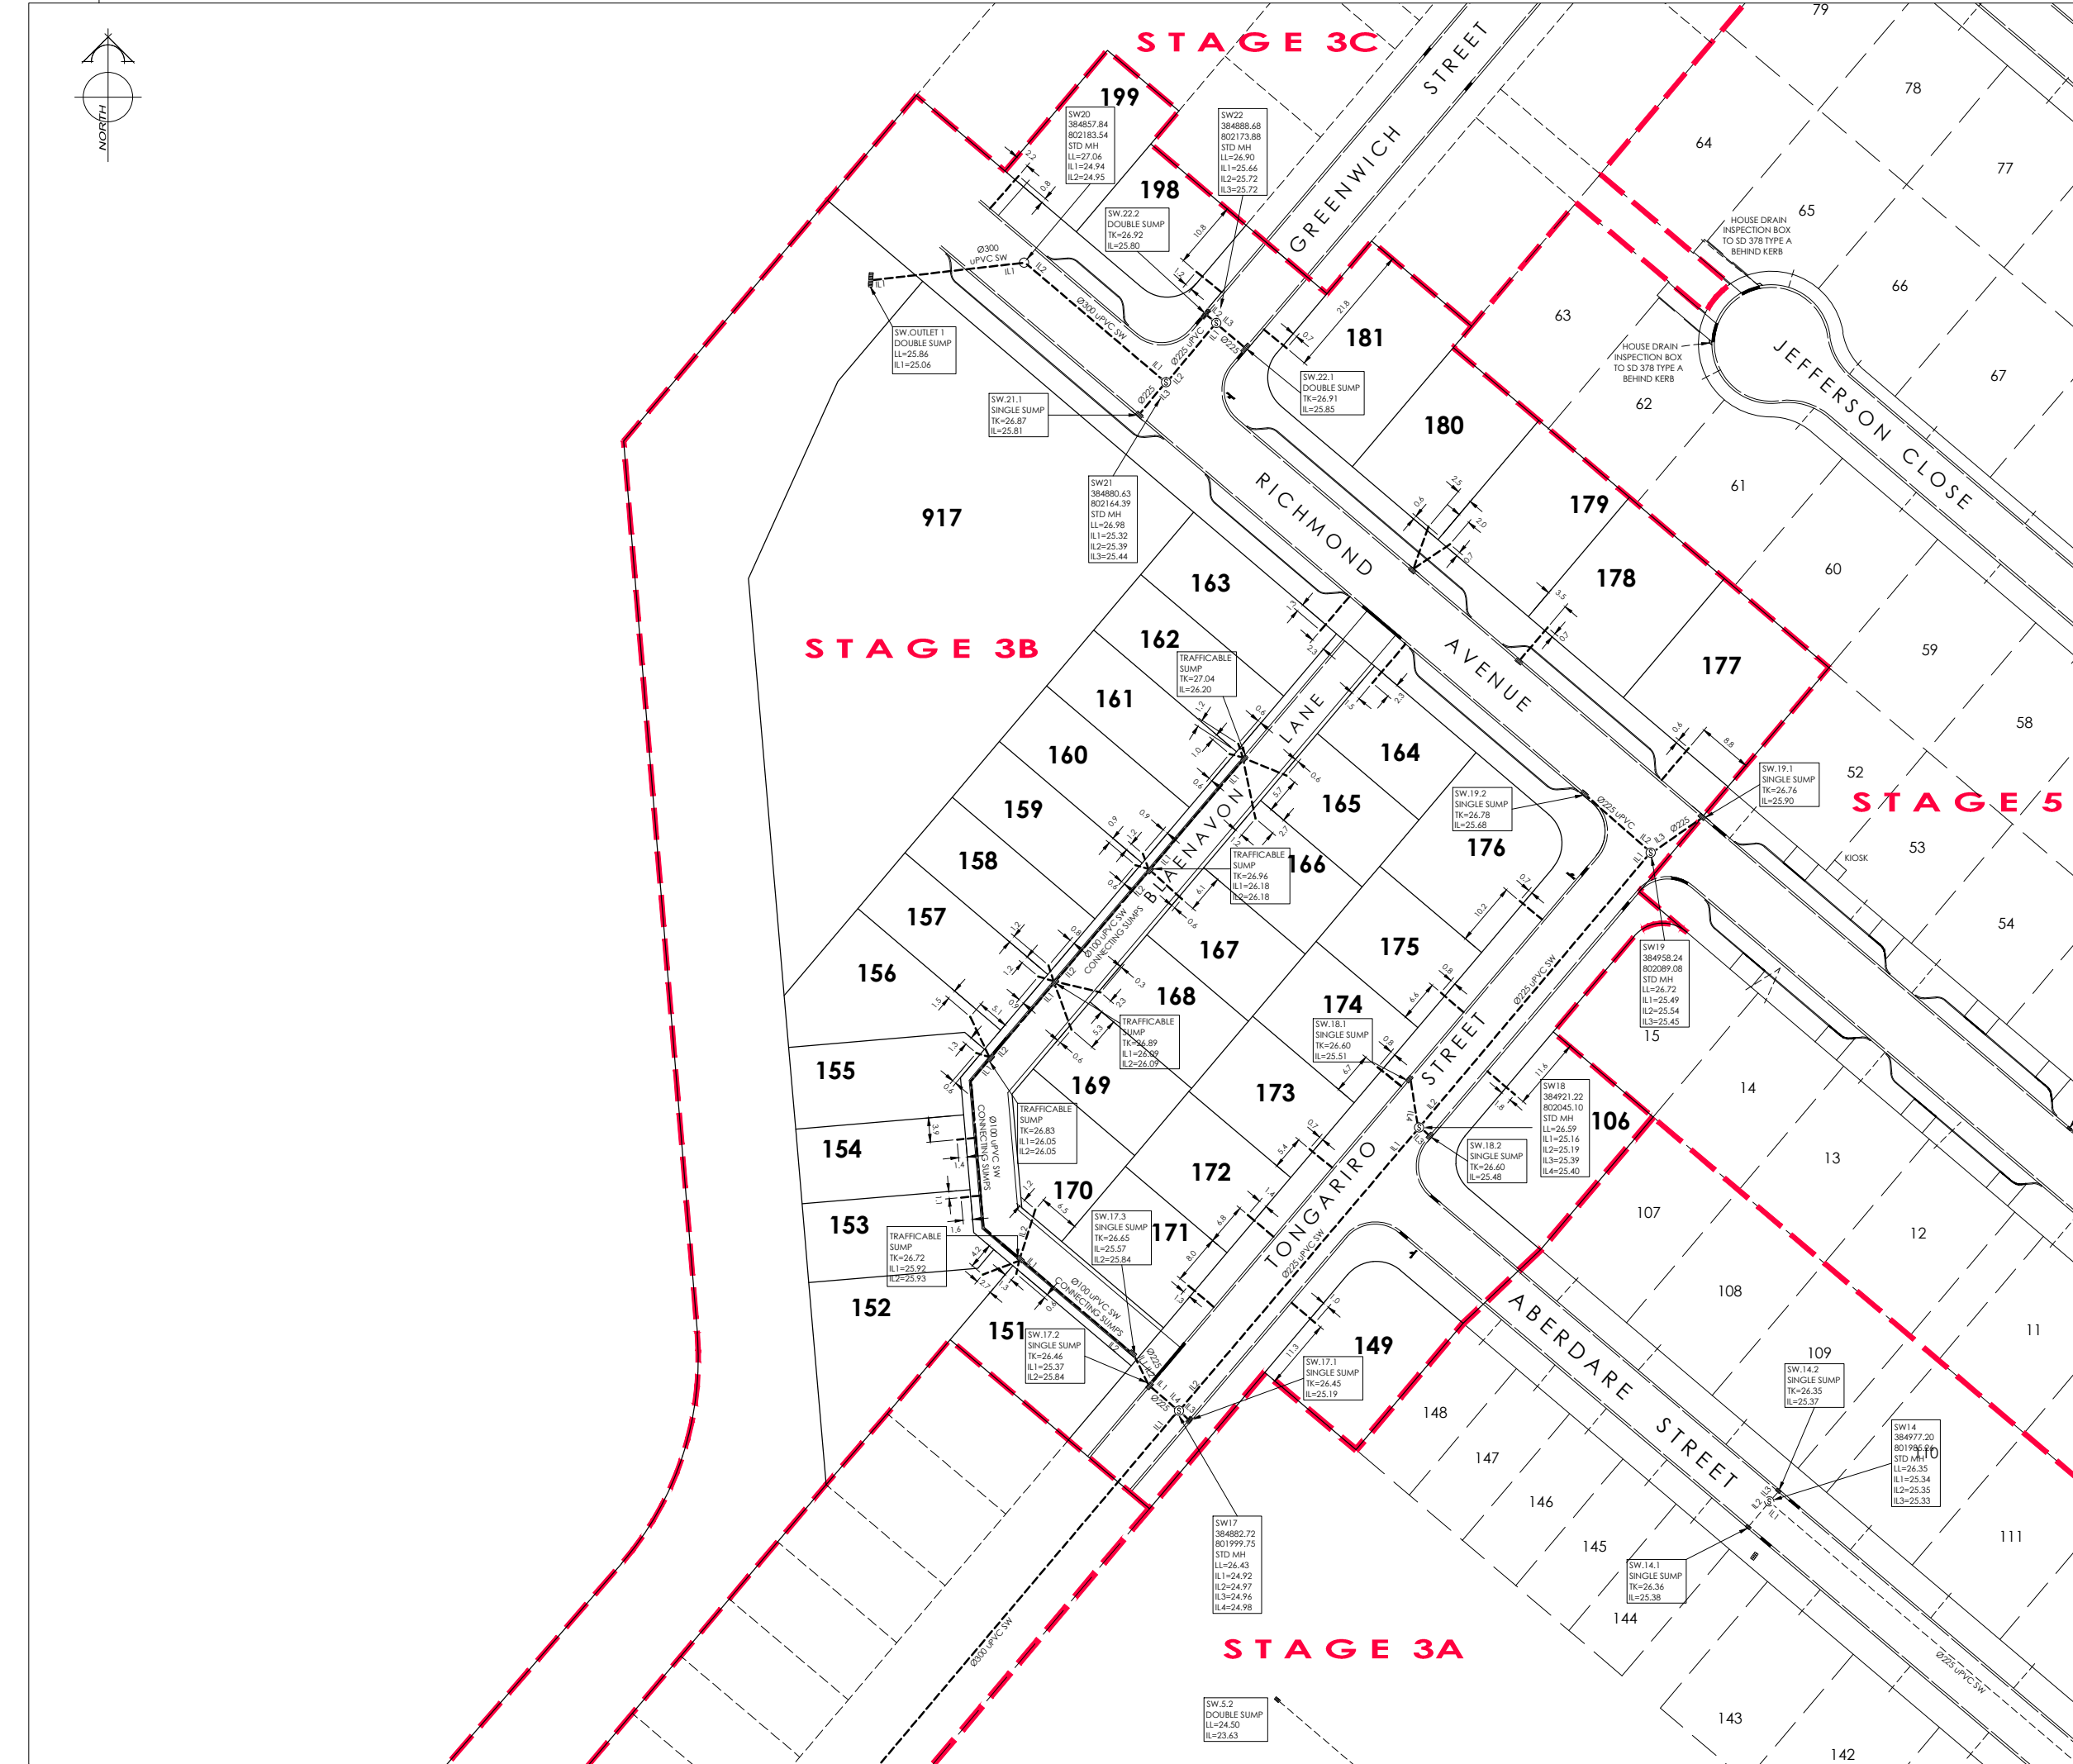

- NOTES:**
- 1) ALL LATERAL AS BUILT INFORMATION WAS PROVIDED BY FULTON HOGAN LIMITED & CITY CARE LIMITED AND NO LIABILITY IS ACCEPTED FOR THE ACCURACY OF THIS INFORMATION.
 - 2) THIS PLAN HAS BEEN PREPARED FOR ASBUILT PURPOSES ONLY. NO LIABILITY IS ACCEPTED IF THE PLAN IS USED FOR ANY OTHER PURPOSE.
 - 3) ANY MEASUREMENTS TAKEN FROM INFORMATION WHICH IS NOT DIMENSIONED ON THE ELECTRONIC COPY ARE AT THE RISK OF THE RECIPIENT.
 - 4) ORIGIN OF LEVELS
BM.EHC6 RL=28.99
CORNER OF AWATEA & WIGRAM ROADS
LEVELS IN TERMS OF CHRISTCHURCH DRAINAGE DATUM, JANUARY 2012 ISSUE

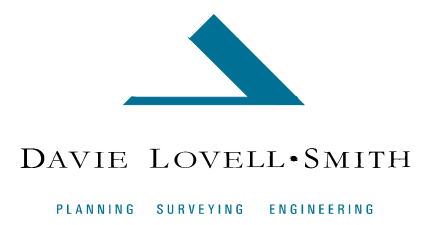

79 Cambridge Terrace P O Box 679 Christchurch 8140. New Zealand
Telephone: 03 379-0793 Fax: 03 379-5664 E-mail: office@ds.co.nz


JOB TITLE:
Fulton Hogan Land Development
Knights Stream Park

SHEET TITLE:
Stormwater Asbuilt


DRAWING STATUS:
Stage 3B - Asbuilt

SCALE: 1:500@A1
1:1000@A3 **DATE:** January 2013

CAD FILE: J:\18022\Eng\CIVIL 3B\Asbuilt\18022.3B.AB01.R0.dwg **REVISION:**
DRAWING No: **SHEET No:**
E.18022.3B.SW.AB01 **RO**

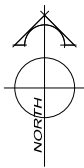

AMENDMENTS:		
AMENDMENT	DATE	DESCRIPTION
R1	20.6.13	AS BUILT STORMWATER BASINS UPDATED

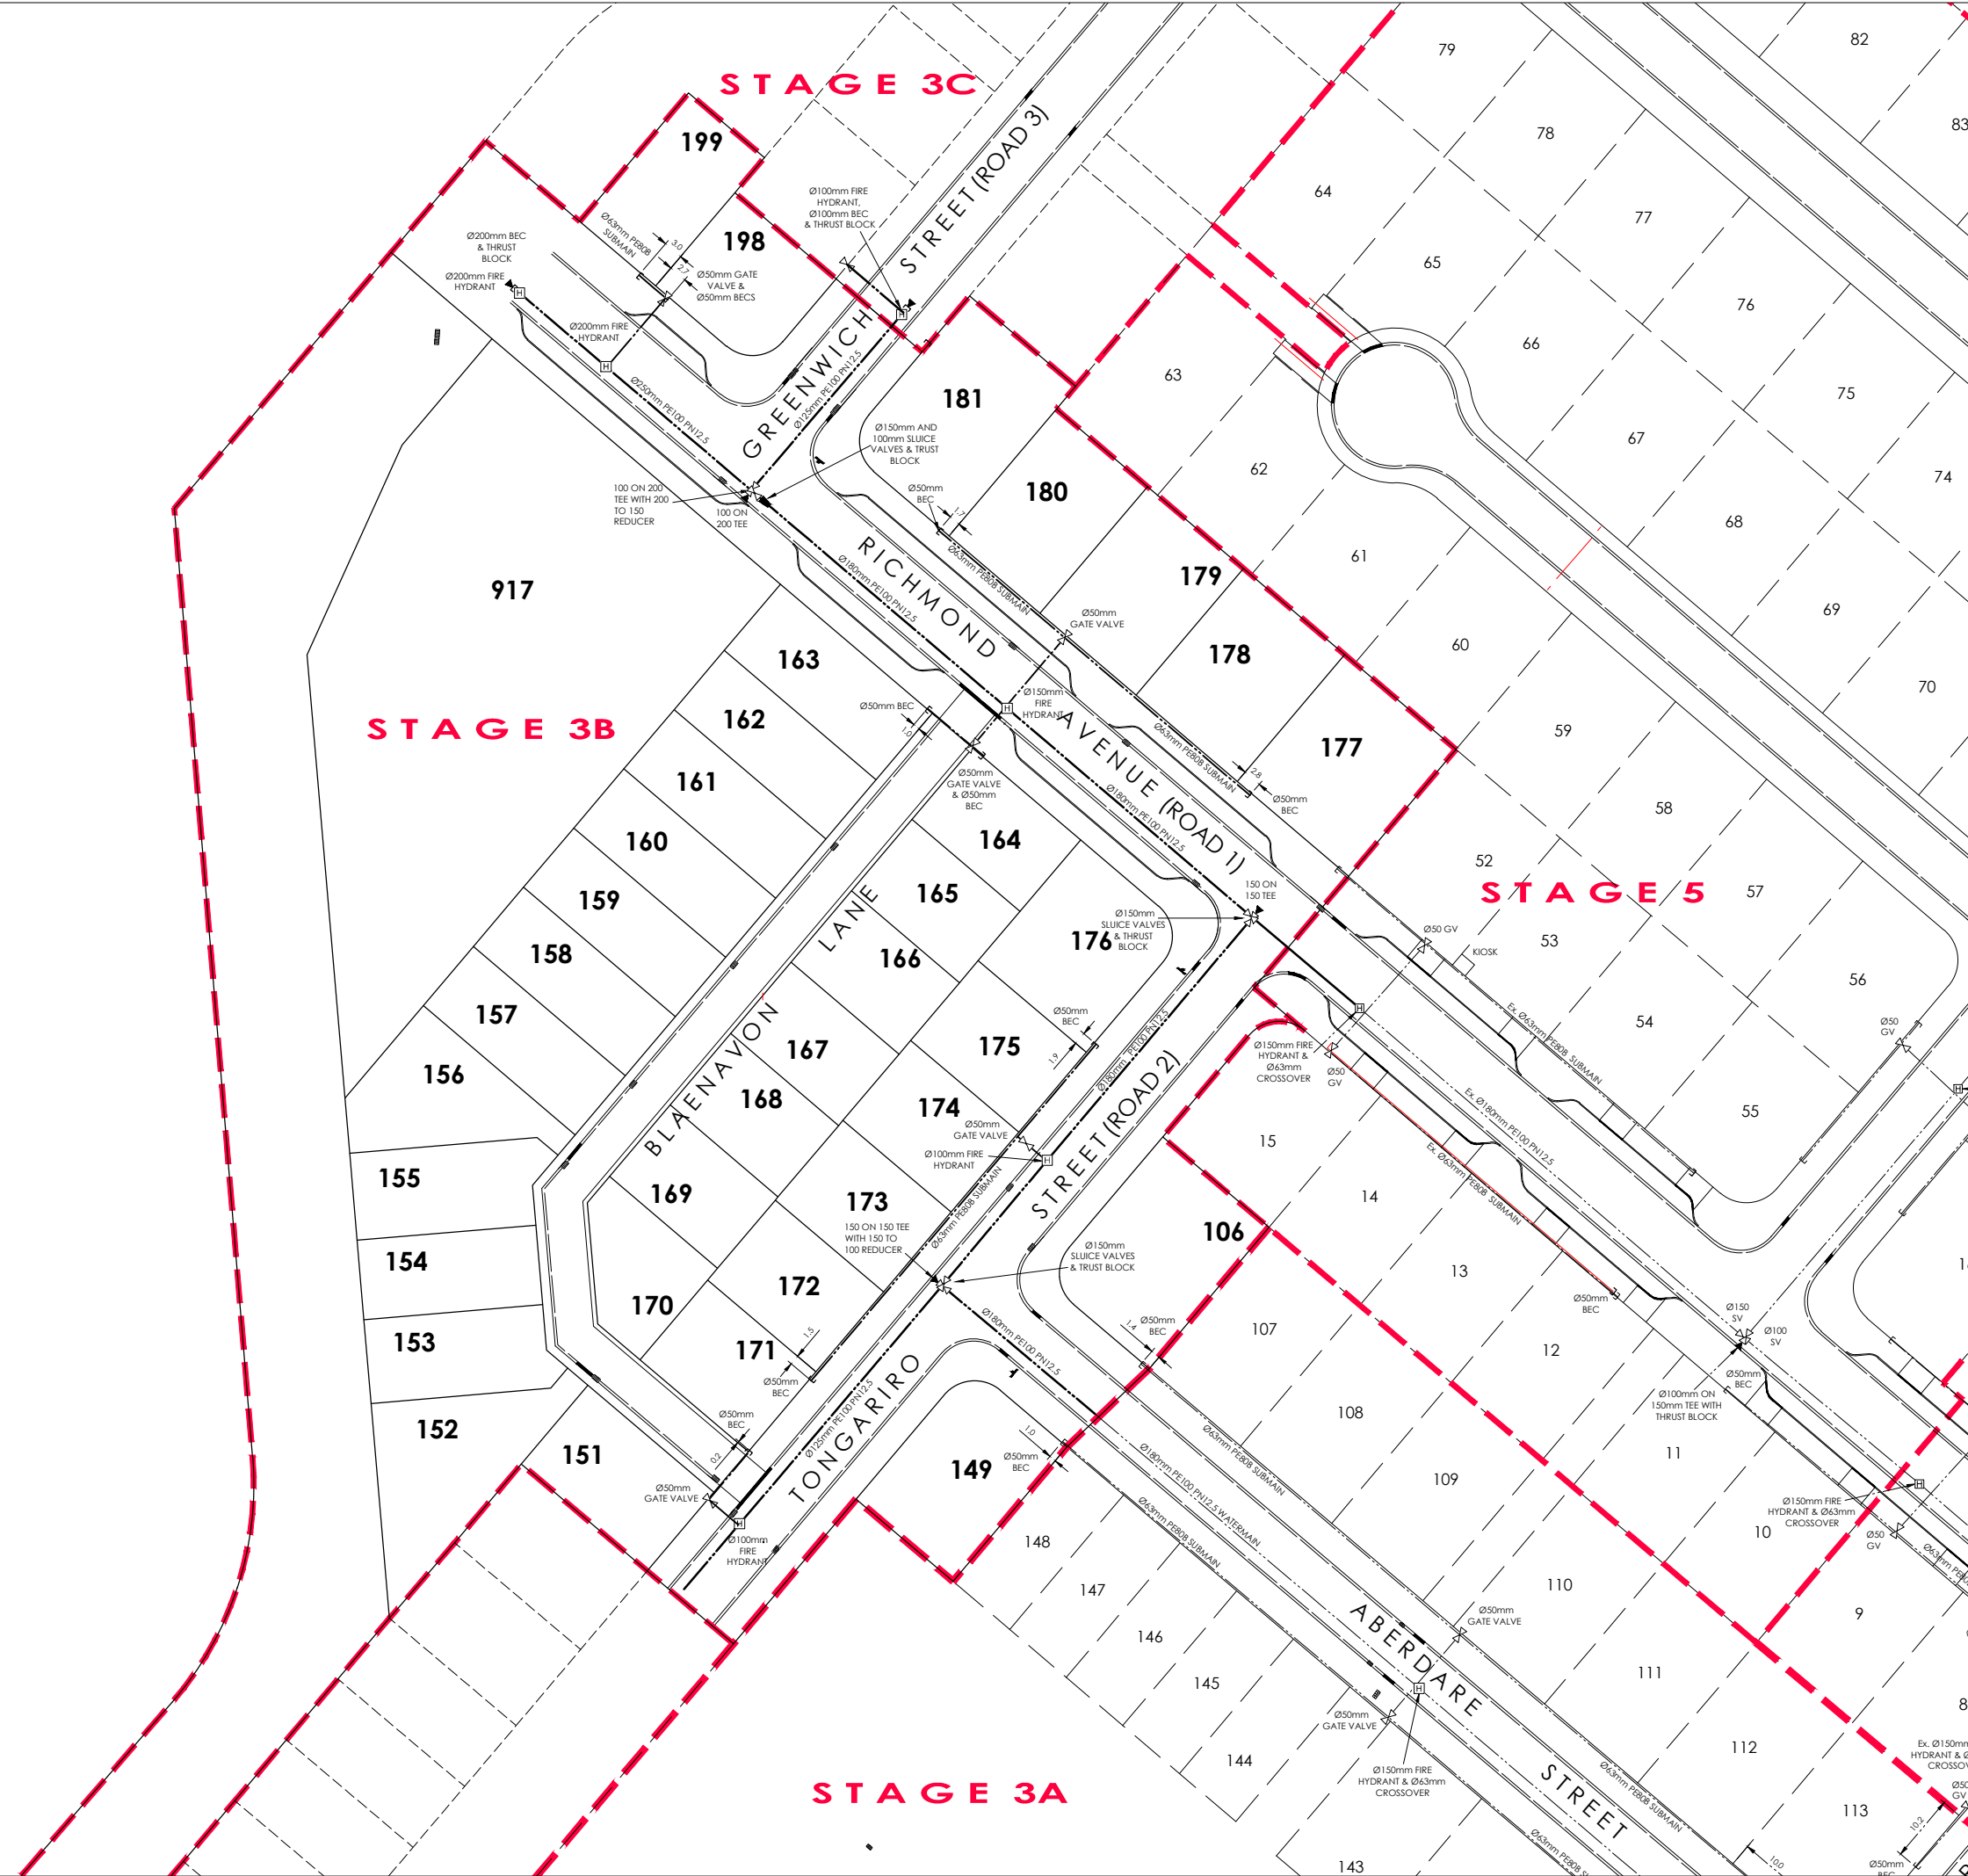

- NOTES:**
- 1) ALL AS BUILT INFORMATION WAS PROVIDED BY FULTON HOGAN LIMITED & CITY CARE LIMITED AND NO LIABILITY IS ACCEPTED FOR THE ACCURACY OF THIS INFORMATION.
 - 2) THIS PLAN HAS BEEN PREPARED FOR ASBUILT PURPOSES ONLY. NO LIABILITY IS ACCEPTED IF THE PLAN IS USED FOR ANY OTHER PURPOSE.
 - 3) ANY MEASUREMENTS TAKEN FROM INFORMATION WHICH IS NOT DIMENSIONED ON THE ELECTRONIC COPY ARE AT THE RISK OF THE RECIPIENT.
 - 4) ORIGIN OF LEVELS
 BM.EHC6 RL=28.99
 CORNER OF AWATEA & WIGRAM ROADS
 LEVELS IN TERMS OF CHRISTCHURCH DRAINAGE DATUM, JANUARY 2012 ISSUE



79 Cambridge Terrace P O Box 679 Christchurch 8140, New Zealand
 Telephone: 03 379-0793 Fax: 03 379-5664 E-mail: office@dls.co.nz

JOB TITLE:		Fulton Hogan Land Development Knights Stream Park
SHEET TITLE:		Water Asbuilt
DRAWING STATUS:		Stage 3B - Asbuilt
SCALE:	1:500@A1 1:1000@A3	DATE: April 2014
CAD FILE:	J:\18022\Eng\CIVIL\3B\Asbuilt\18022.3B.AB01 R0.dwg	REVISION:
DRAWING No:	E.18022.3B.W.AB01	SHEET No:
		R0