



AMENDMENTS		
AMENDMENT	DATE	DESCRIPTION

**SERVICES**

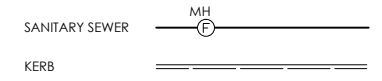

**NOTES:**

- 1) ALL LATERAL AND SEWER PRESSURE MAIN AS BUILT INFORMATION WAS PROVIDED BY FULTON HOGAN LIMITED & CITY CARE LIMITED AND NO LIABILITY IS ACCEPTED FOR THE ACCURACY OF THIS INFORMATION.
- 2) THIS PLAN HAS BEEN PREPARED FOR ASBUILT PURPOSES ONLY. NO LIABILITY IS ACCEPTED IF THE PLAN IS USED FOR ANY OTHER PURPOSE.
- 3) ANY MEASUREMENTS TAKEN FROM INFORMATION WHICH IS NOT DIMENSIONED ON THE ELECTRONIC COPY ARE AT THE RISK OF THE RECIPIENT.
- 4) ORIGIN OF LEVELS  
 BM.EHC6 RL=28.99  
 CORNER OF AWATEA & WIGRAM ROADS  
 LEVELS IN TERMS OF CHRISTCHURCH DRAINAGE DATUM, JANUARY 2012 ISSUE

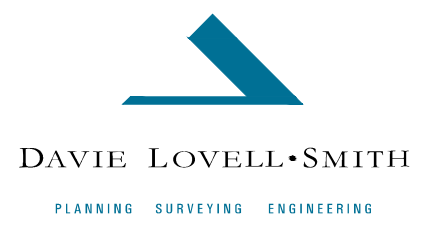

79 Cambridge Terrace P O Box 679 Christchurch 8140, New Zealand  
 Telephone: 03 379-0793 Fax: 03 379-5664 E-mail: office@dls.co.nz


JOB TITLE:  
**Fulton Hogan Land Development  
 Knights Stream Park**

SHEET TITLE:  
**Sewer Asbuilt**

DRAWING STATUS:  
**Stage 3A - Asbuilt**


SCALE: 1:500@A1 DATE: May 2013  
 1:1000@A3


CAD FILE: J:\18022\Eng\CIVIL 3A\ASBUILT\E18022.AB01.dwg REVISION:  
 DRAWING No: SHEET No:  
**E.18022.SS.AB01** **R0**

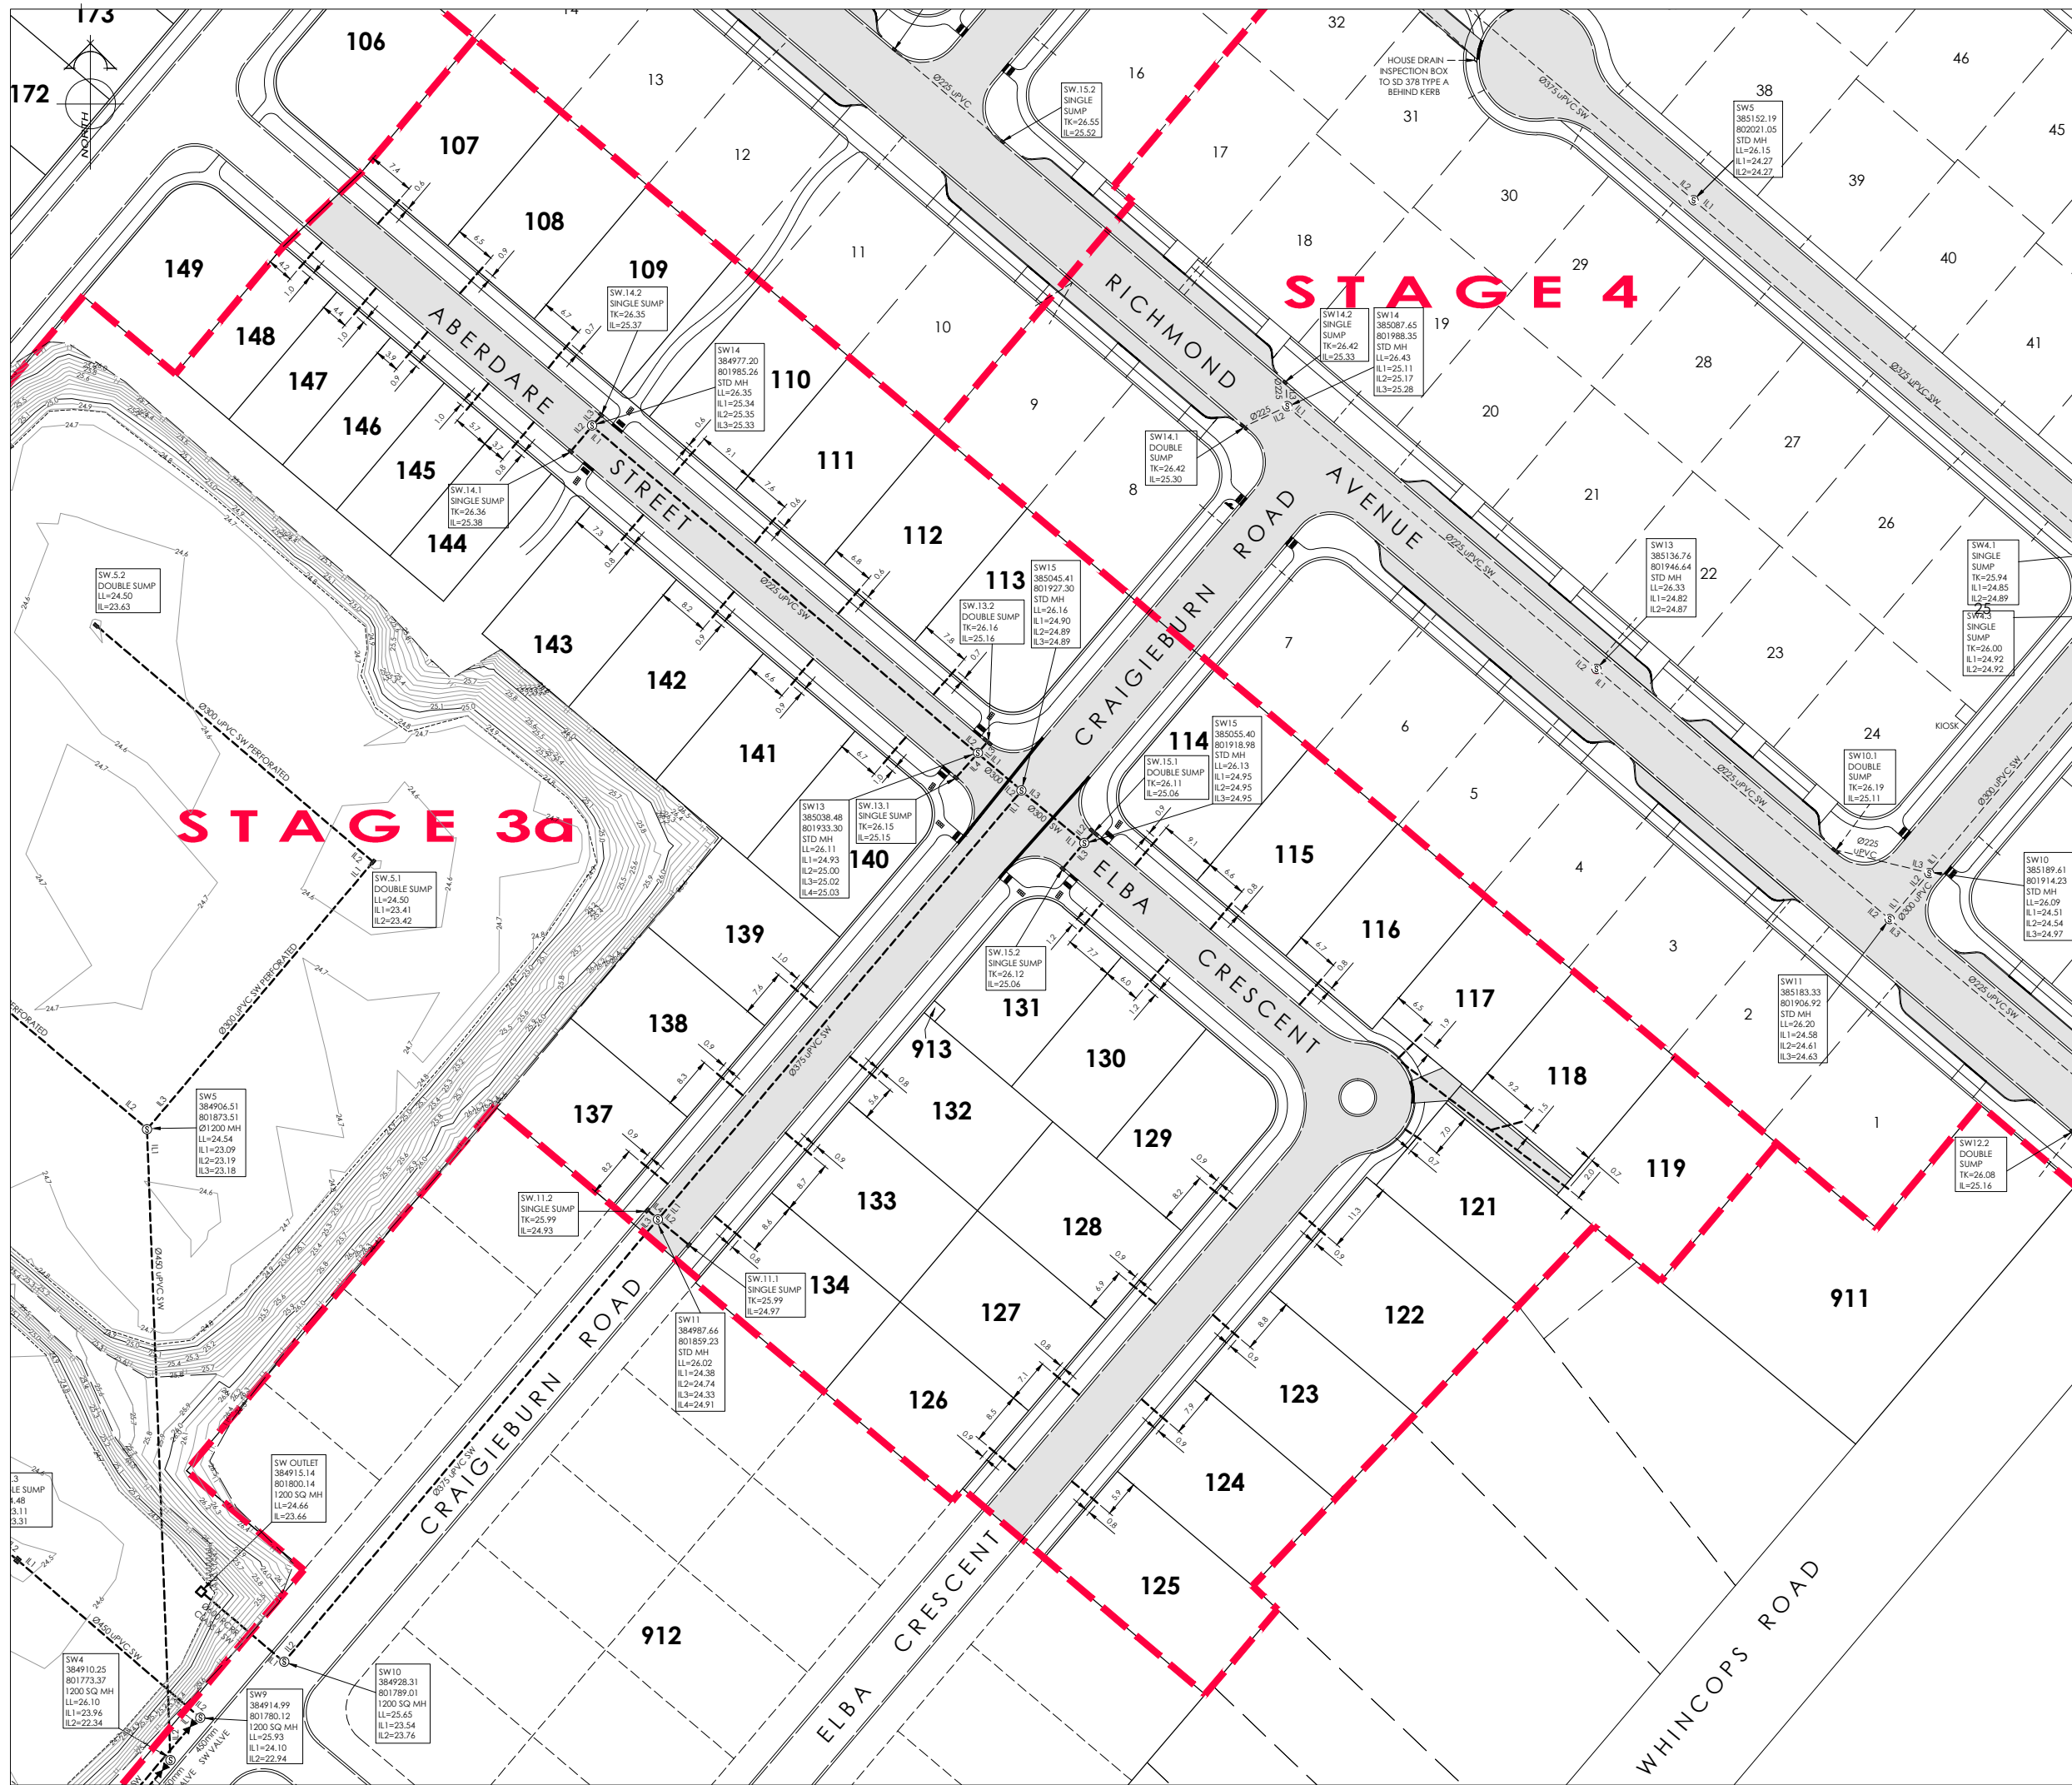

AMENDMENT	DATE	DESCRIPTION

**SERVICES**

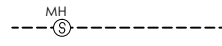
STORMWATER 

KERB 

**NOTES:**

- 1) ALL LATERAL AS BUILT INFORMATION WAS PROVIDED BY FULTON HOGAN LIMITED & CITY CARE LIMITED AND NO LIABILITY IS ACCEPTED FOR THE ACCURACY OF THIS INFORMATION.
- 2) THIS PLAN HAS BEEN PREPARED FOR ASBUILT PURPOSES ONLY. NO LIABILITY IS ACCEPTED IF THE PLAN IS USED FOR ANY OTHER PURPOSE.
- 3) ANY MEASUREMENTS TAKEN FROM INFORMATION WHICH IS NOT DIMENSIONED ON THE ELECTRONIC COPY ARE AT THE RISK OF THE RECIPIENT.
- 4) **ORIGIN OF LEVELS**  
 BM.EHC6 RL=28.99  
 CORNER OF AWATEA & WIGRAM ROADS  
 LEVELS IN TERMS OF CHRISTCHURCH DRAINAGE DATUM.  
 JANUARY 2012 ISSUE

**Fulton Hogan**  
LAND DEVELOPMENT LTD.

  
**DAVIE LOVELL • SMITH**  
 PLANNING SURVEYING ENGINEERING

79 Cambridge Terrace P O Box 679 Christchurch 8140, New Zealand  
 Telephone: 03 379-0793 Fax: 03 379-5664 E-mail: office@dls.co.nz

**JOB TITLE:**  
 Fulton Hogan Land Development  
 Knights Stream Park

**SHEET TITLE:**  
 Stormwater Asbuilt

**DRAWING STATUS:**  
 Stage 3A - Asbuilt

**SCALE:** 1:500@A1  
 1:1000@A3



**DATE:** May 2013

**CAD FILE:** J:\18022\Eng\CIVIL\ASBUILT\E18022.AB01.dwg

**DRAWING No.:** E.18022.SW.AB01


**SHEET No.:** R0

**REVISION:**

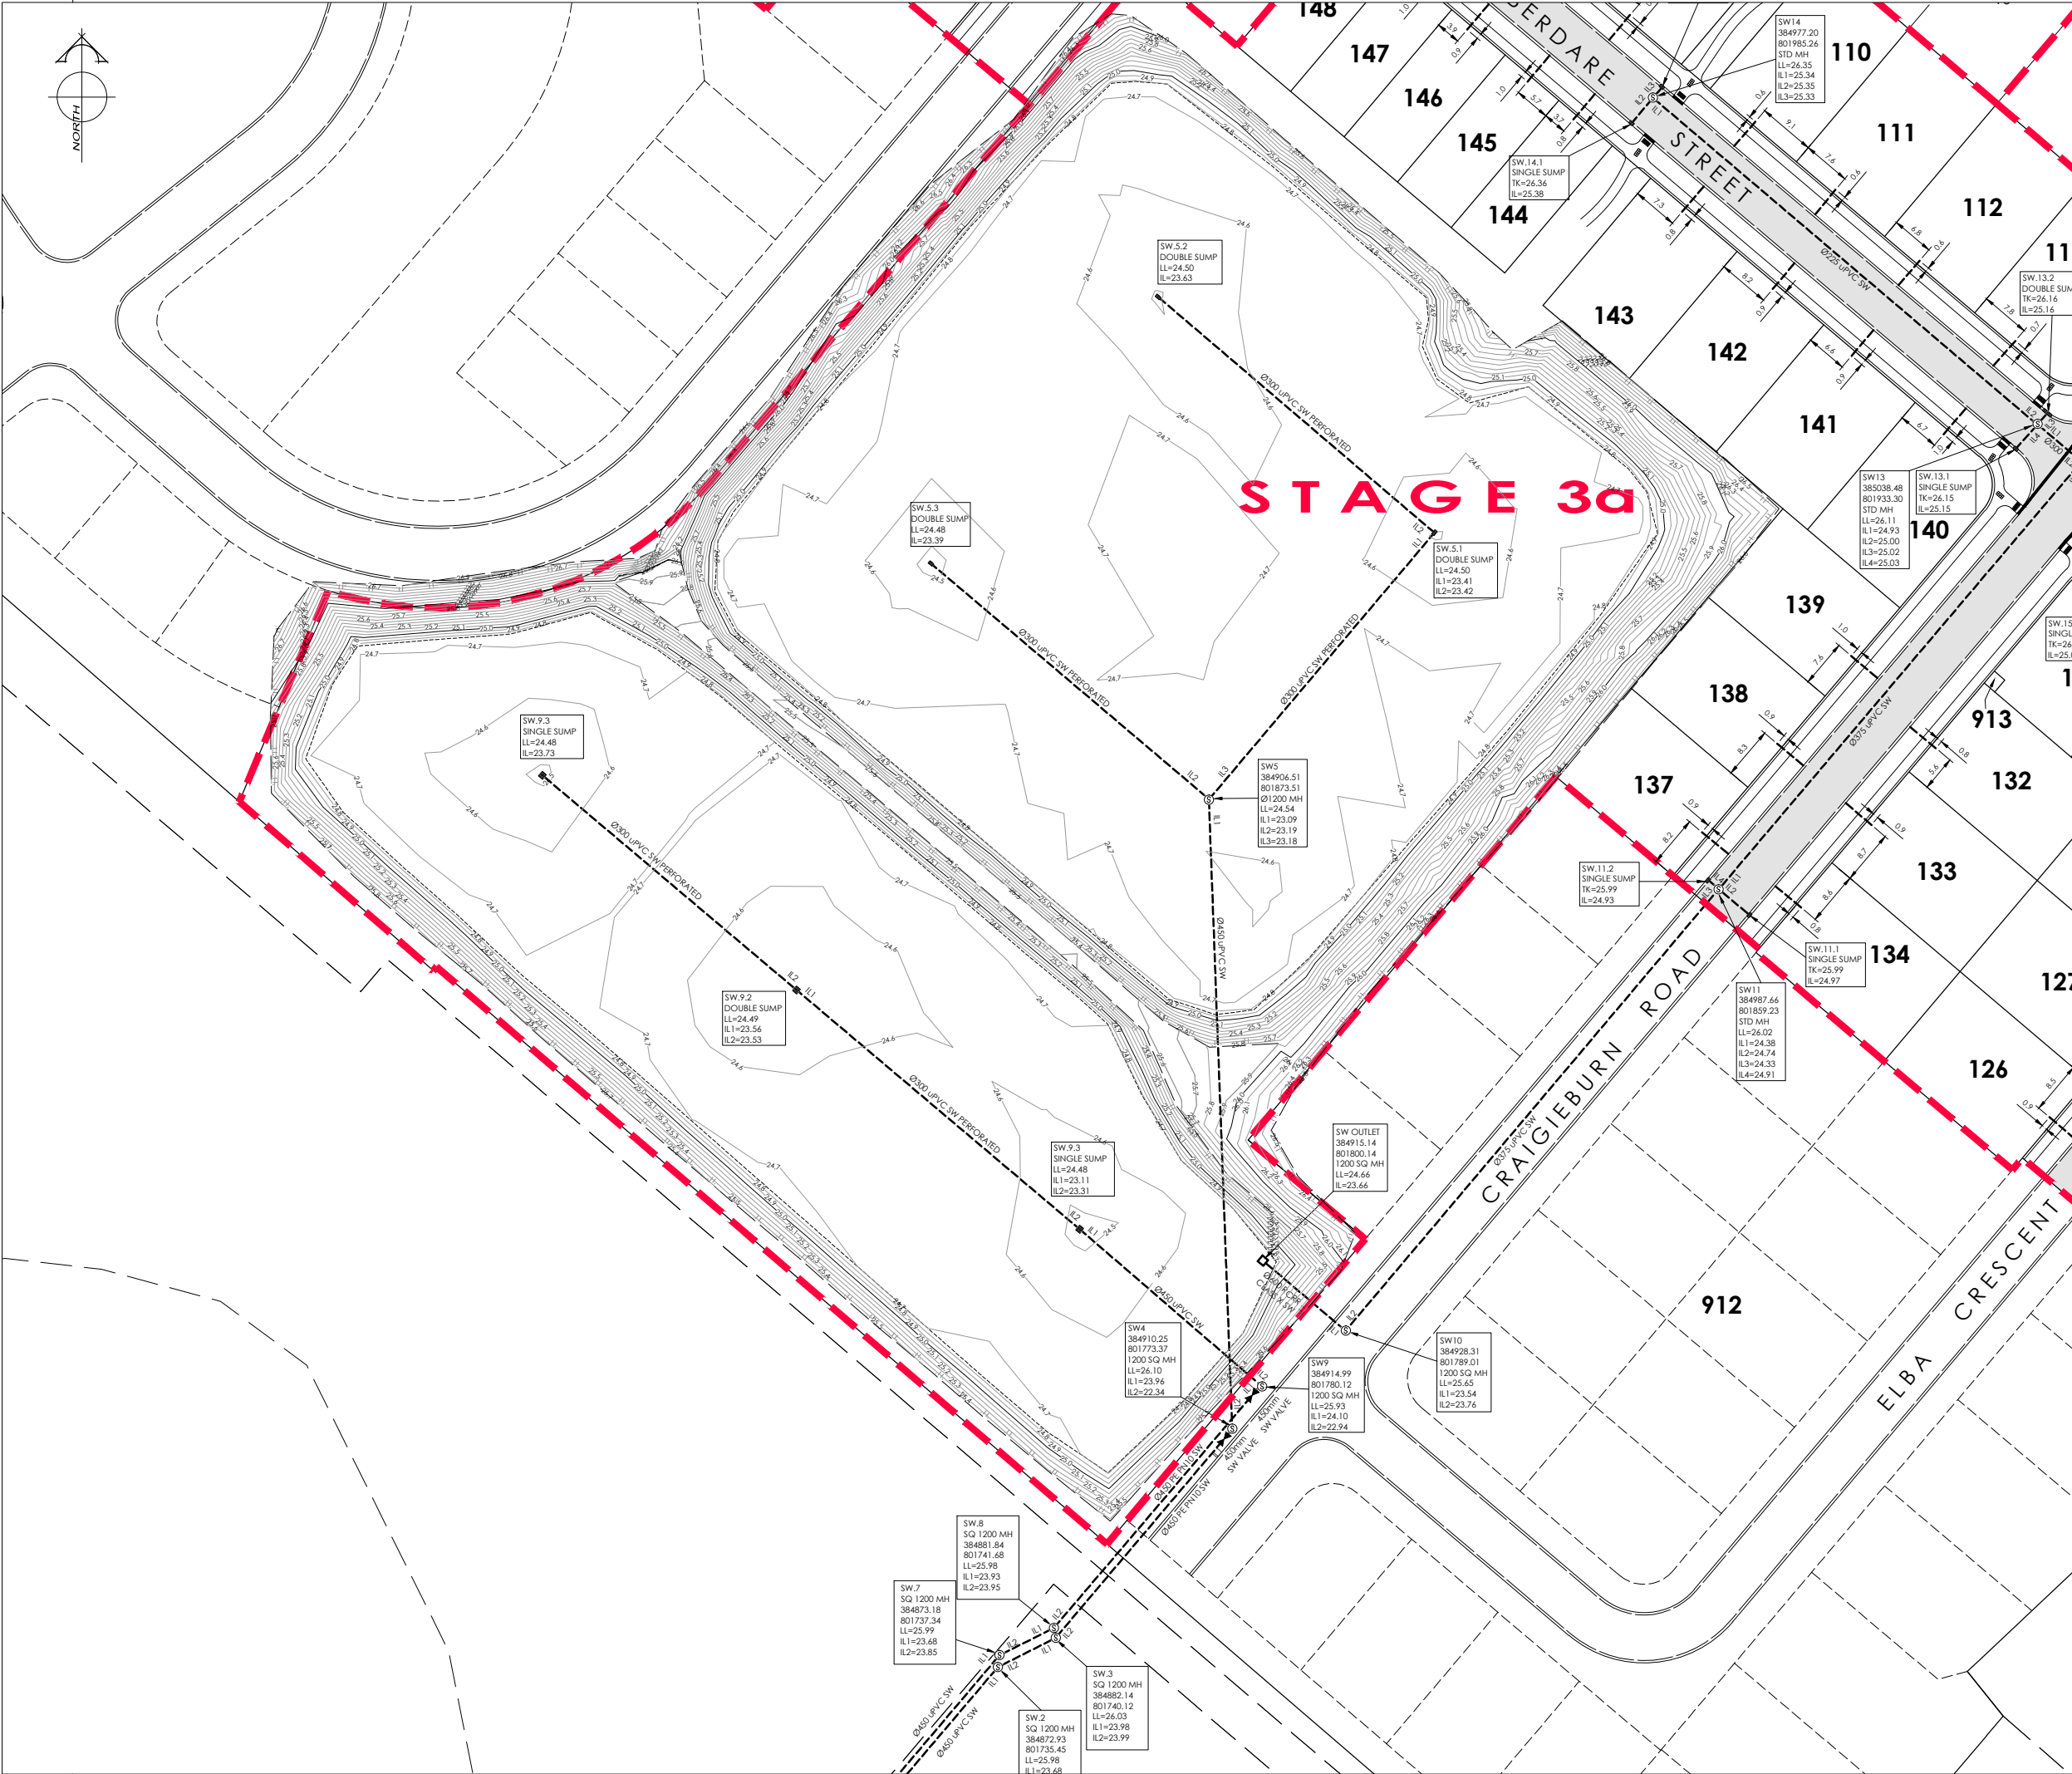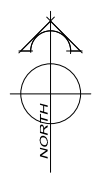

AMENDMENT	DATE	DESCRIPTION

**SERVICES**

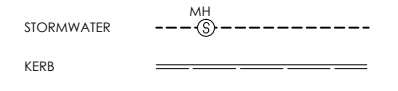

**NOTES:**

- 1) ALL LATERAL AS BUILT INFORMATION WAS PROVIDED BY FULTON HOGAN LIMITED & CITY CARE LIMITED AND NO LIABILITY IS ACCEPTED FOR THE ACCURACY OF THIS INFORMATION.
- 2) THIS PLAN HAS BEEN PREPARED FOR ASBUILT PURPOSES ONLY. NO LIABILITY IS ACCEPTED IF THE PLAN IS USED FOR ANY OTHER PURPOSE.
- 3) ANY MEASUREMENTS TAKEN FROM INFORMATION WHICH IS NOT DIMENSIONED ON THE ELECTRONIC COPY ARE AT THE RISK OF THE RECIPIENT.
- 4) ORIGIN OF LEVELS  
 BM.EHC6 RL=28.99  
 CORNER OF AWATEA & WIGRAM ROADS  
 LEVELS IN TERMS OF CHRISTCHURCH DRAINAGE DATUM,  
 JANUARY 2012 ISSUE





79 Cambridge Terrace P O Box 679 Christchurch 8140, New Zealand  
 Telephone: 03 379-0793 Fax: 03 379-5664 E-mail: office@dls.co.nz

**JOB TITLE:**  
 Fulton Hogan Land Development  
 Knights Stream Park

**SHEET TITLE:**  
 Stormwater Asbuilt


**DRAWING STATUS:**  
 Stage 3A - Asbuilt

**SCALE:** 1:500@A1 DATE: May 2013  
 1:1000@A3  
**CAD FILE:** J:\18022\Eng\CIVIL 3A\ASBUILT\E18022.AB01.dwg  
**DRAWING No:** E.18022.SW.AB01.1 **SHEET No:** RO

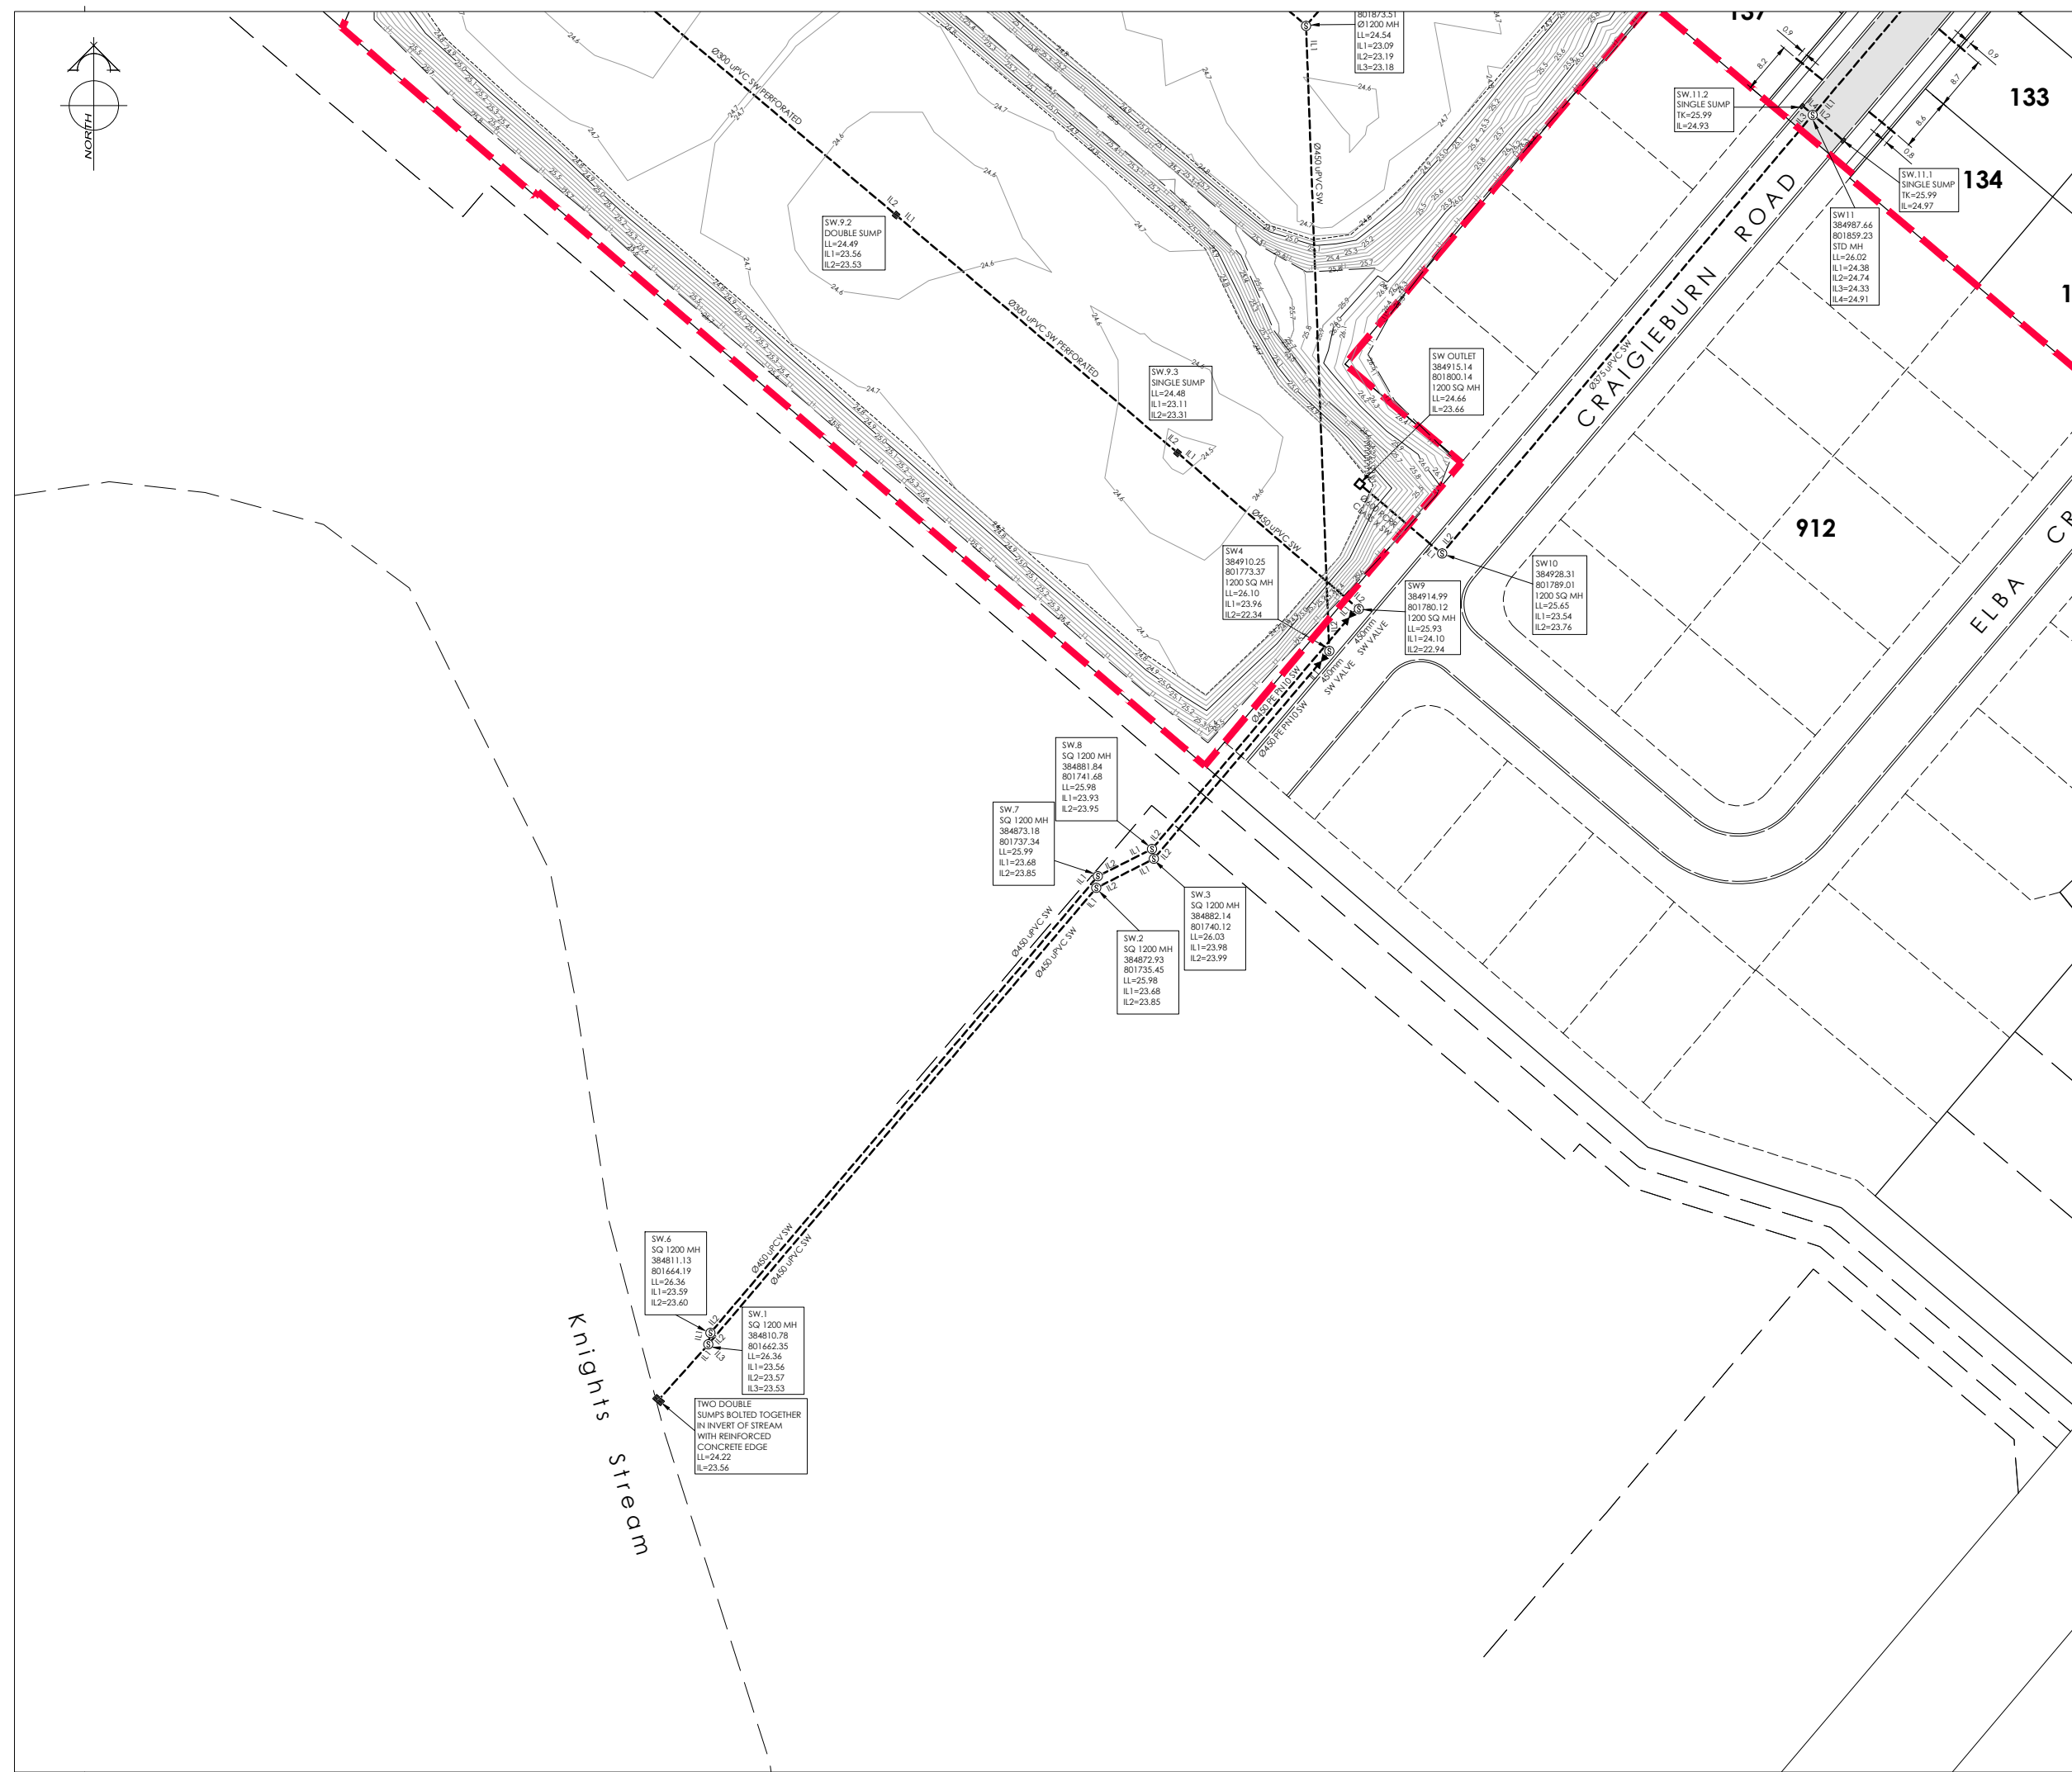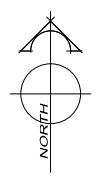

AMENDMENTS:		
AMENDMENT	DATE	DESCRIPTION

**SERVICES**

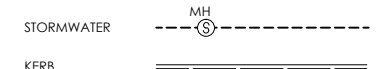

**NOTES:**

- 1) ALL LATERAL AS BUILT INFORMATION WAS PROVIDED BY FULTON HOGAN LIMITED & CITY CARE LIMITED AND NO LIABILITY IS ACCEPTED FOR THE ACCURACY OF THIS INFORMATION.
- 2) THIS PLAN HAS BEEN PREPARED FOR ASBUILT PURPOSES ONLY. NO LIABILITY IS ACCEPTED IF THE PLAN IS USED FOR ANY OTHER PURPOSE.
- 3) ANY MEASUREMENTS TAKEN FROM INFORMATION WHICH IS NOT DIMENSIONED ON THE ELECTRONIC COPY ARE AT THE RISK OF THE RECIPIENT.
- 4) ORIGIN OF LEVELS  
BM.EHC6 RL=28.99  
CORNER OF AWATEA & WIGRAM ROADS  
  
LEVELS IN TERMS OF CHRISTCHURCH DRAINAGE DATUM.  
JANUARY 2012 ISSUE



**DAVIE LOVELL • SMITH**  
PLANNING SURVEYING ENGINEERING

79 Cambridge Terrace P O Box 679 Christchurch 8140, New Zealand  
Telephone: 03 379-0793 Fax: 03 379-5664 E-mail: office@dls.co.nz


JOB TITLE:  
**Fulton Hogan Land Development  
Knights Stream Park**

SHEET TITLE:  
**Stormwater Asbuilt**

DRAWING STATUS:  
**Stage 3A - Asbuilt**

SCALE: 1:500@A1 DATE: May 2013  
1:1000@A3

CAD FILE: J:\18022\Eng\CIVIL 3A\ASBUILT\E18022.AB01.dwg REVISION:  
DRAWING No: SHEET No:  
**E.18022.SW.AB01.2** **RO**

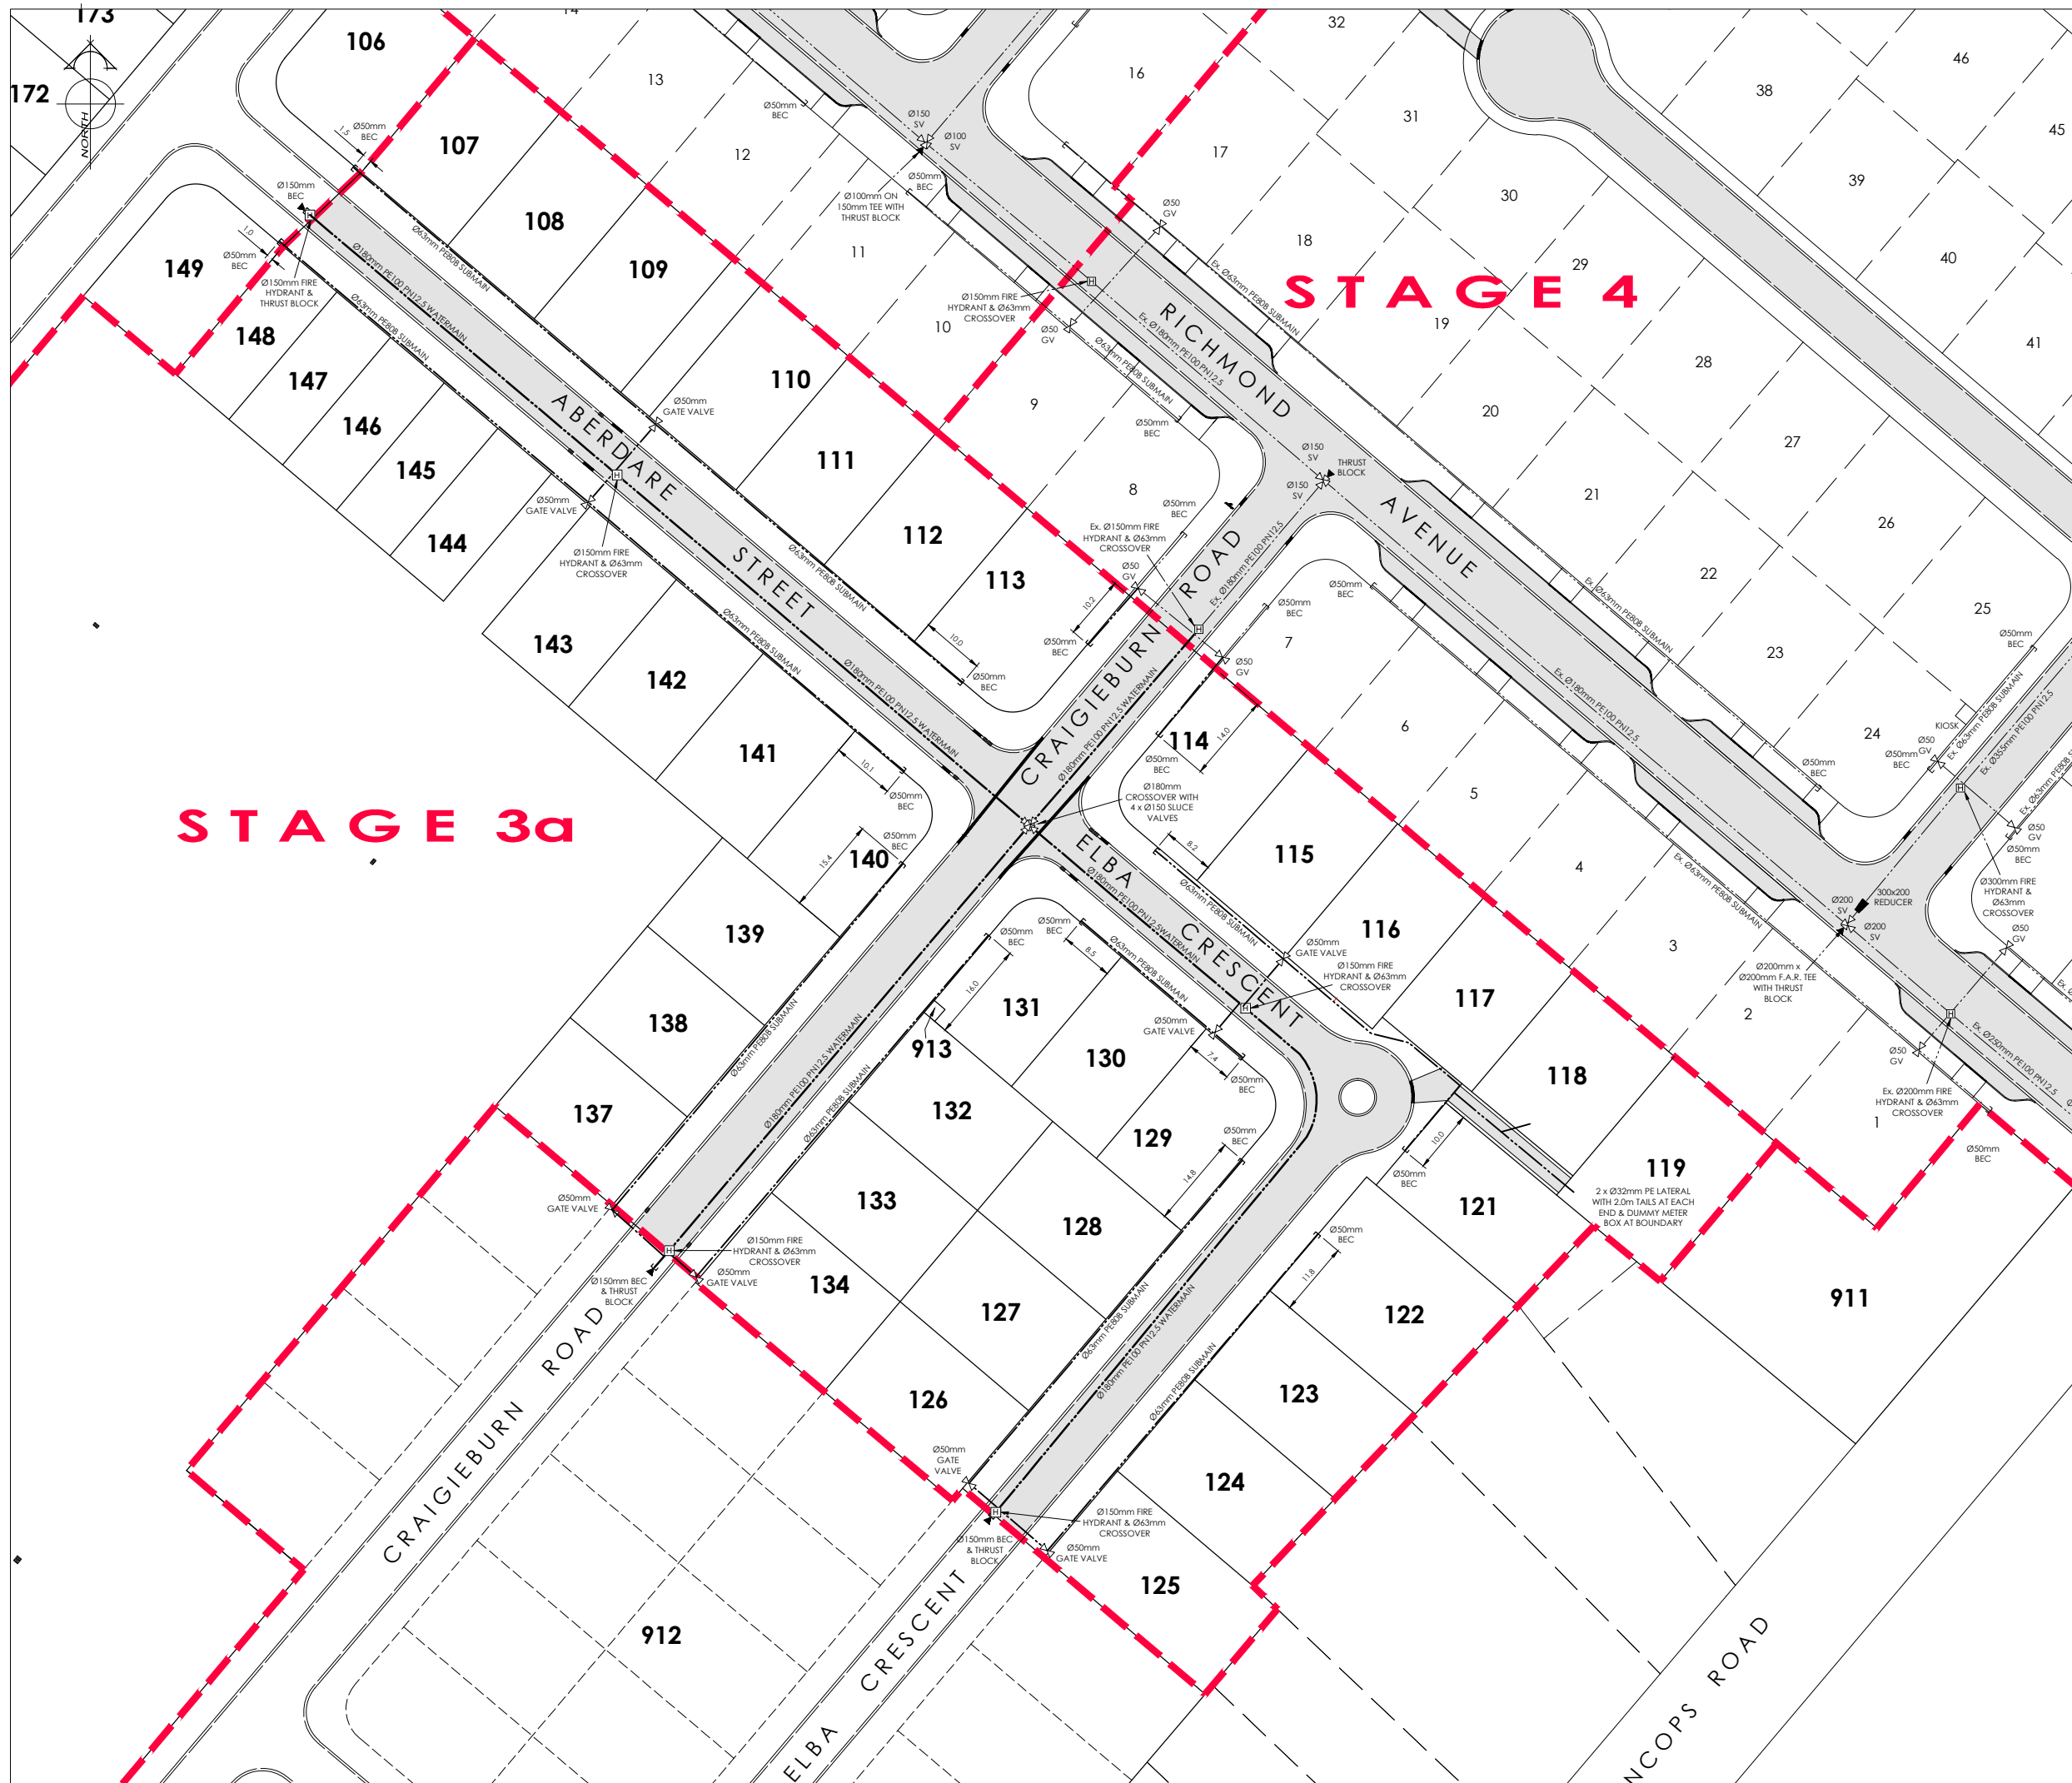

**STAGE 3a**

**STAGE 4**

AMENDMENT	DATE	DESCRIPTION

**SERVICES**



**NOTES:**

- 1) ALL AS BUILT INFORMATION WAS PROVIDED BY FULTON HOGAN LIMITED & CITY CARE LIMITED AND NO LIABILITY IS ACCEPTED FOR THE ACCURACY OF THIS INFORMATION.
- 2) THIS PLAN HAS BEEN PREPARED FOR ASBUILT PURPOSES ONLY. NO LIABILITY IS ACCEPTED IF THE PLAN IS USED FOR ANY OTHER PURPOSE.
- 3) ANY MEASUREMENTS TAKEN FROM INFORMATION WHICH IS NOT DIMENSIONED ON THE ELECTRONIC COPY ARE AT THE RISK OF THE RECIPIENT.
- 4) **ORIGIN OF LEVELS**  
 BM.EHC6 RL=28.99  
 CORNER OF AWATEA & WIGRAM ROADS  
 LEVELS IN TERMS OF CHRISTCHURCH DRAINAGE DATUM, JANUARY 2012 ISSUE



79 Cambridge Terrace P O Box 679 Christchurch 8140, New Zealand  
 Telephone: 03 379-0793 Fax: 03 379-5664 E-mail: office@dls.co.nz

**JOB TITLE:**  
 Fulton Hogan Land Development  
 Knights Stream Park

**SHEET TITLE:**  
 Water Asbuilt

**DRAWING STATUS:**  
 Stage 3A - Asbuilt

**SCALE:** 1:500@A1  
 1:1000@A3 **DATE:** May 2013

**CAD FILE:** J:\18022\Eng\Civil\_3A\ASBUILT\E18022.AB01.dwg **REVISION:**  
**DRAWING No:** E.18022.SS.AB01 **SHEET No:** R0