

AMENDMENTS:		
AMENDMENT	DATE	DESCRIPTION

NOTES:

- 1) This plan has been prepared for sewer asbuilt purposes only. No liability is accepted if the plan is used for any other purpose.
- 2) Any measurements taken from information which is not dimensioned on the electronic copy are at the risk of the recipient.
- 3) All roading and foot path information is not asbuilt and is for context purposes only.

SERVICES

SANITARY SEWER SEWER LATERAL MH KERB

NOTES:

- 1) ALL LATERAL POSITIONS HAVE BEEN PROVIDED BY CITY CARE LIMITED AND HAVE NOT BEEN VERIFIED.



116 Wrights Road P O Box 679 Christchurch 8140, New Zealand
 Telephone: 03 379-0793 Website: www.dls.co.nz E-mail: office@dls.co.nz


JOB TITLE:
**Fulton Hogan Land Development
 Knights Stream Park Stage 7**

SHEET TITLE:
Sewer - Asbuilt



DRAWING STATUS:
Stages 7 Asbuilt

SCALE: 1:500@A1 DATE: March 2015
 1:1000@A3

CAD FILE: J:\18447\ASBUILT\KSP7_AB.dwg REVISION:
 DRAWING No: SHEET No:
E.18447.AB01.SS01 **RO**

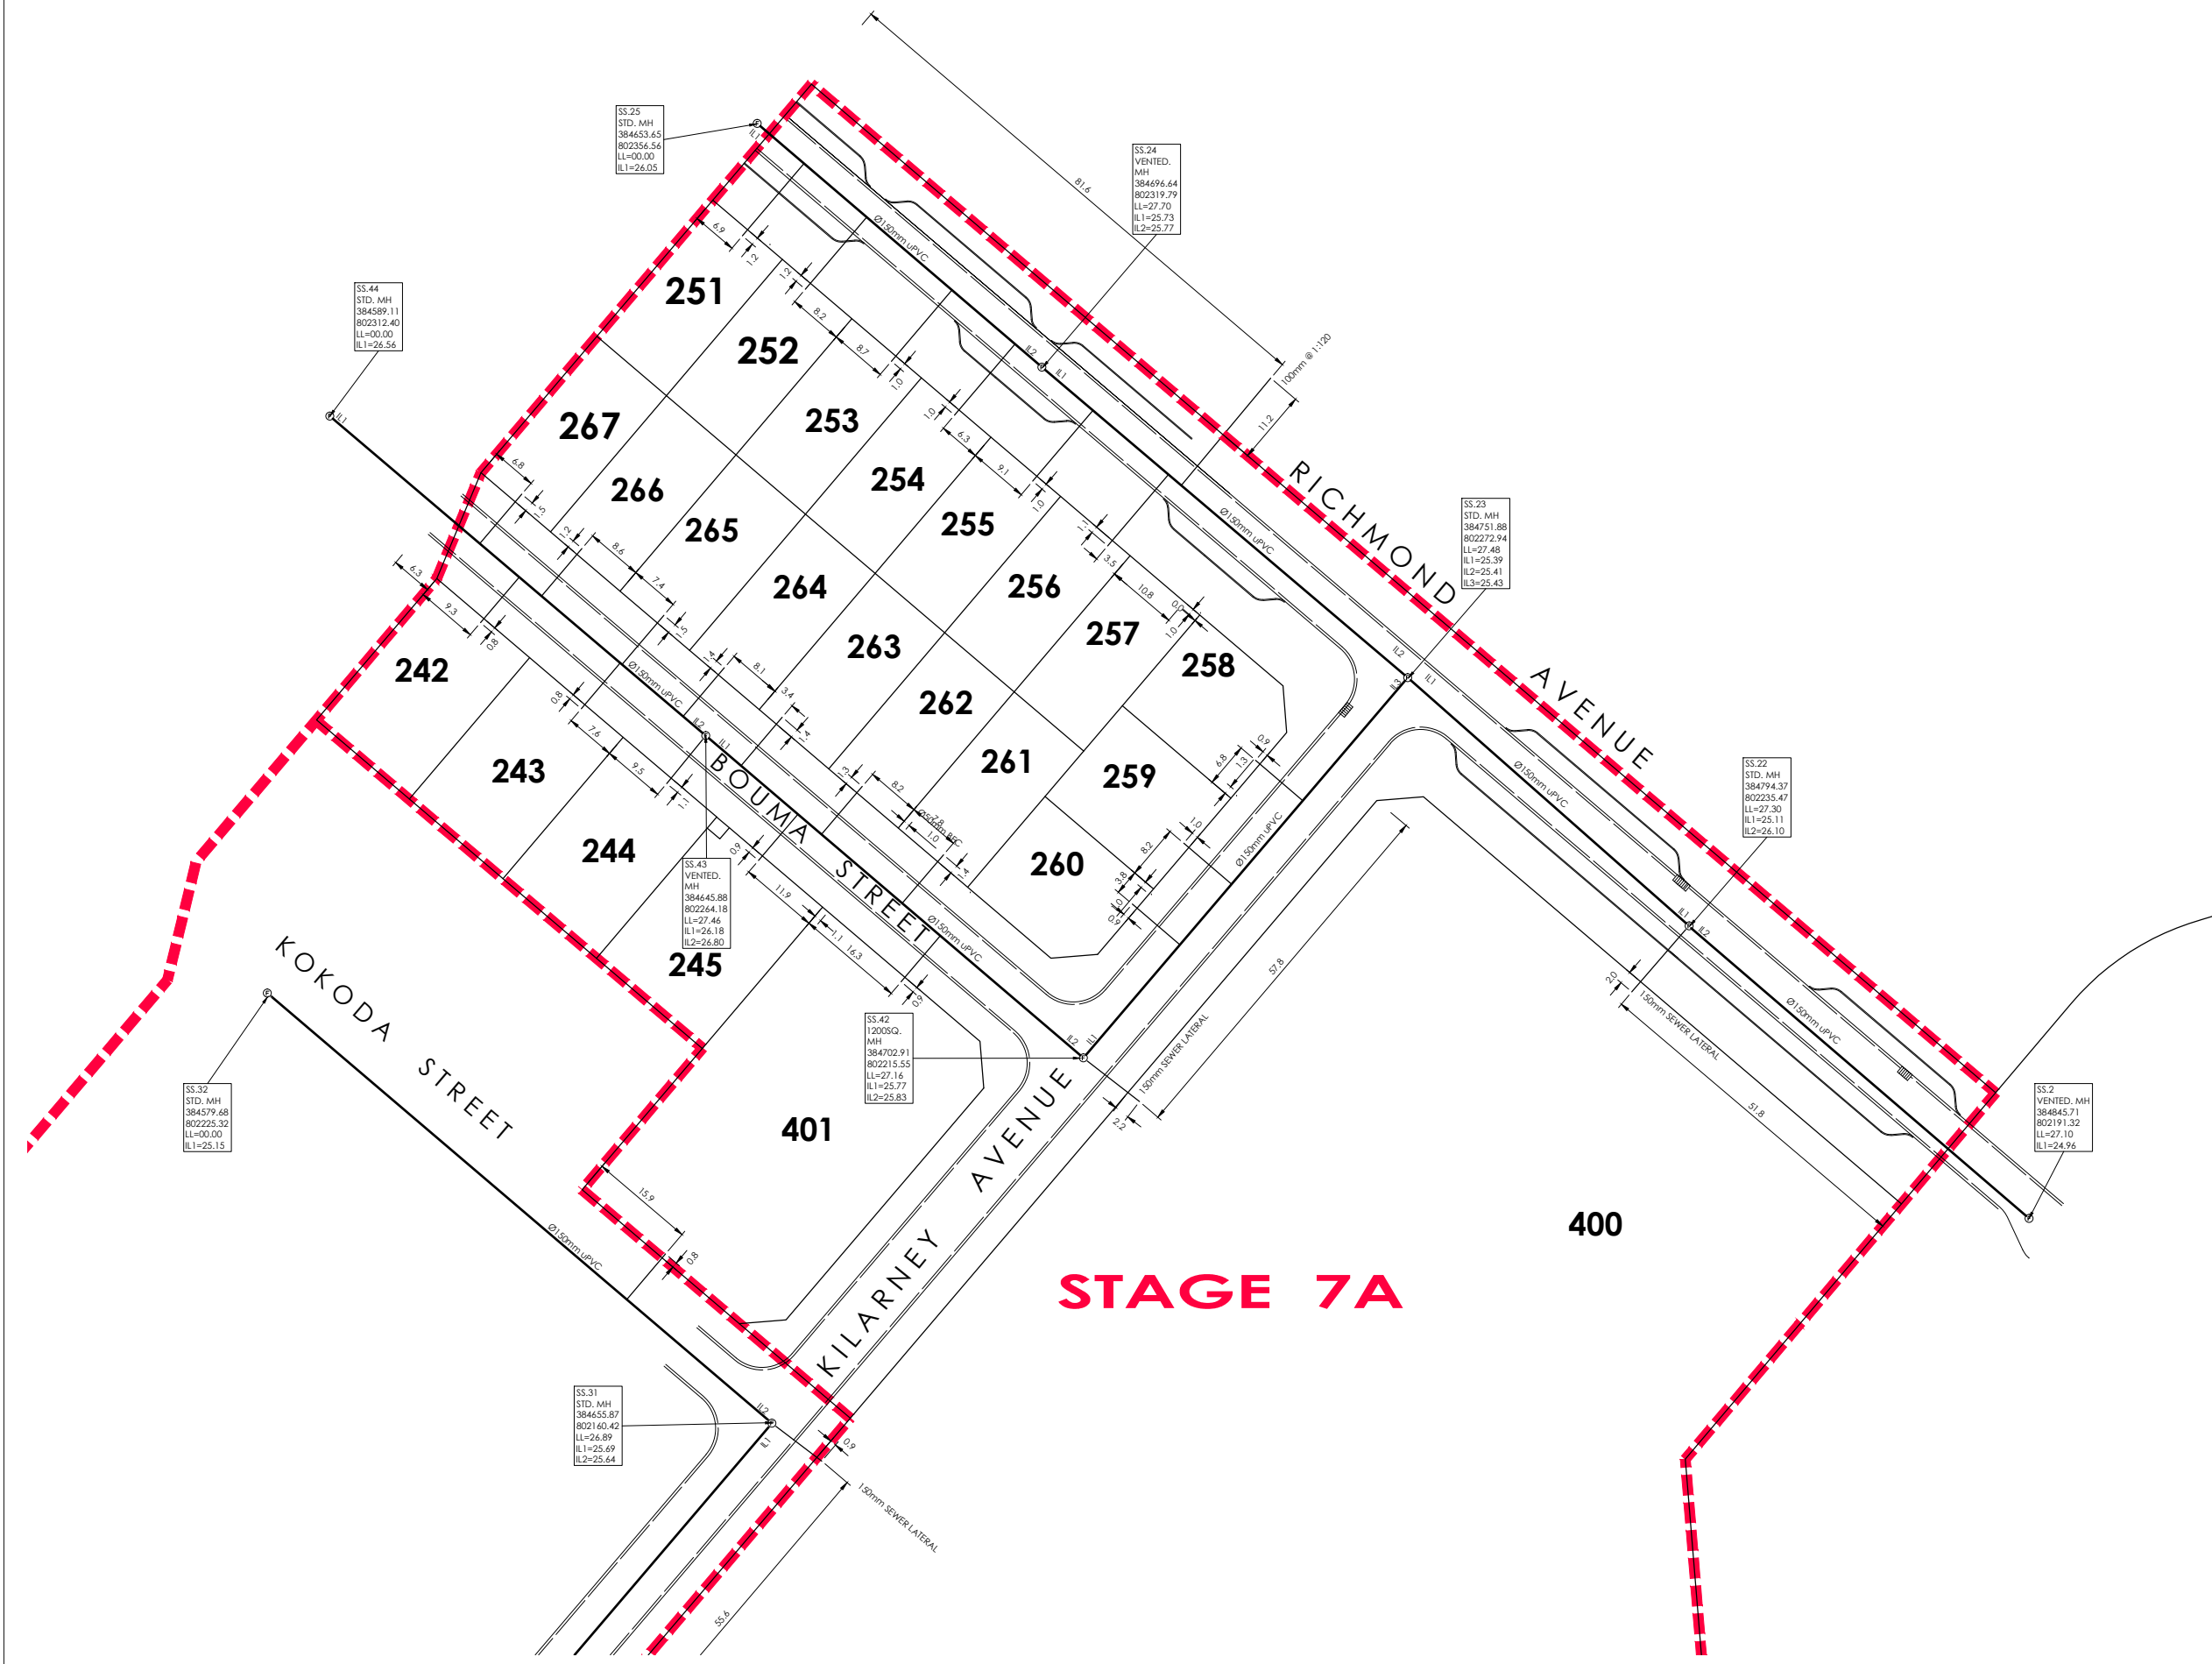


STAGE 7A

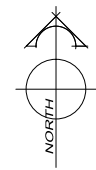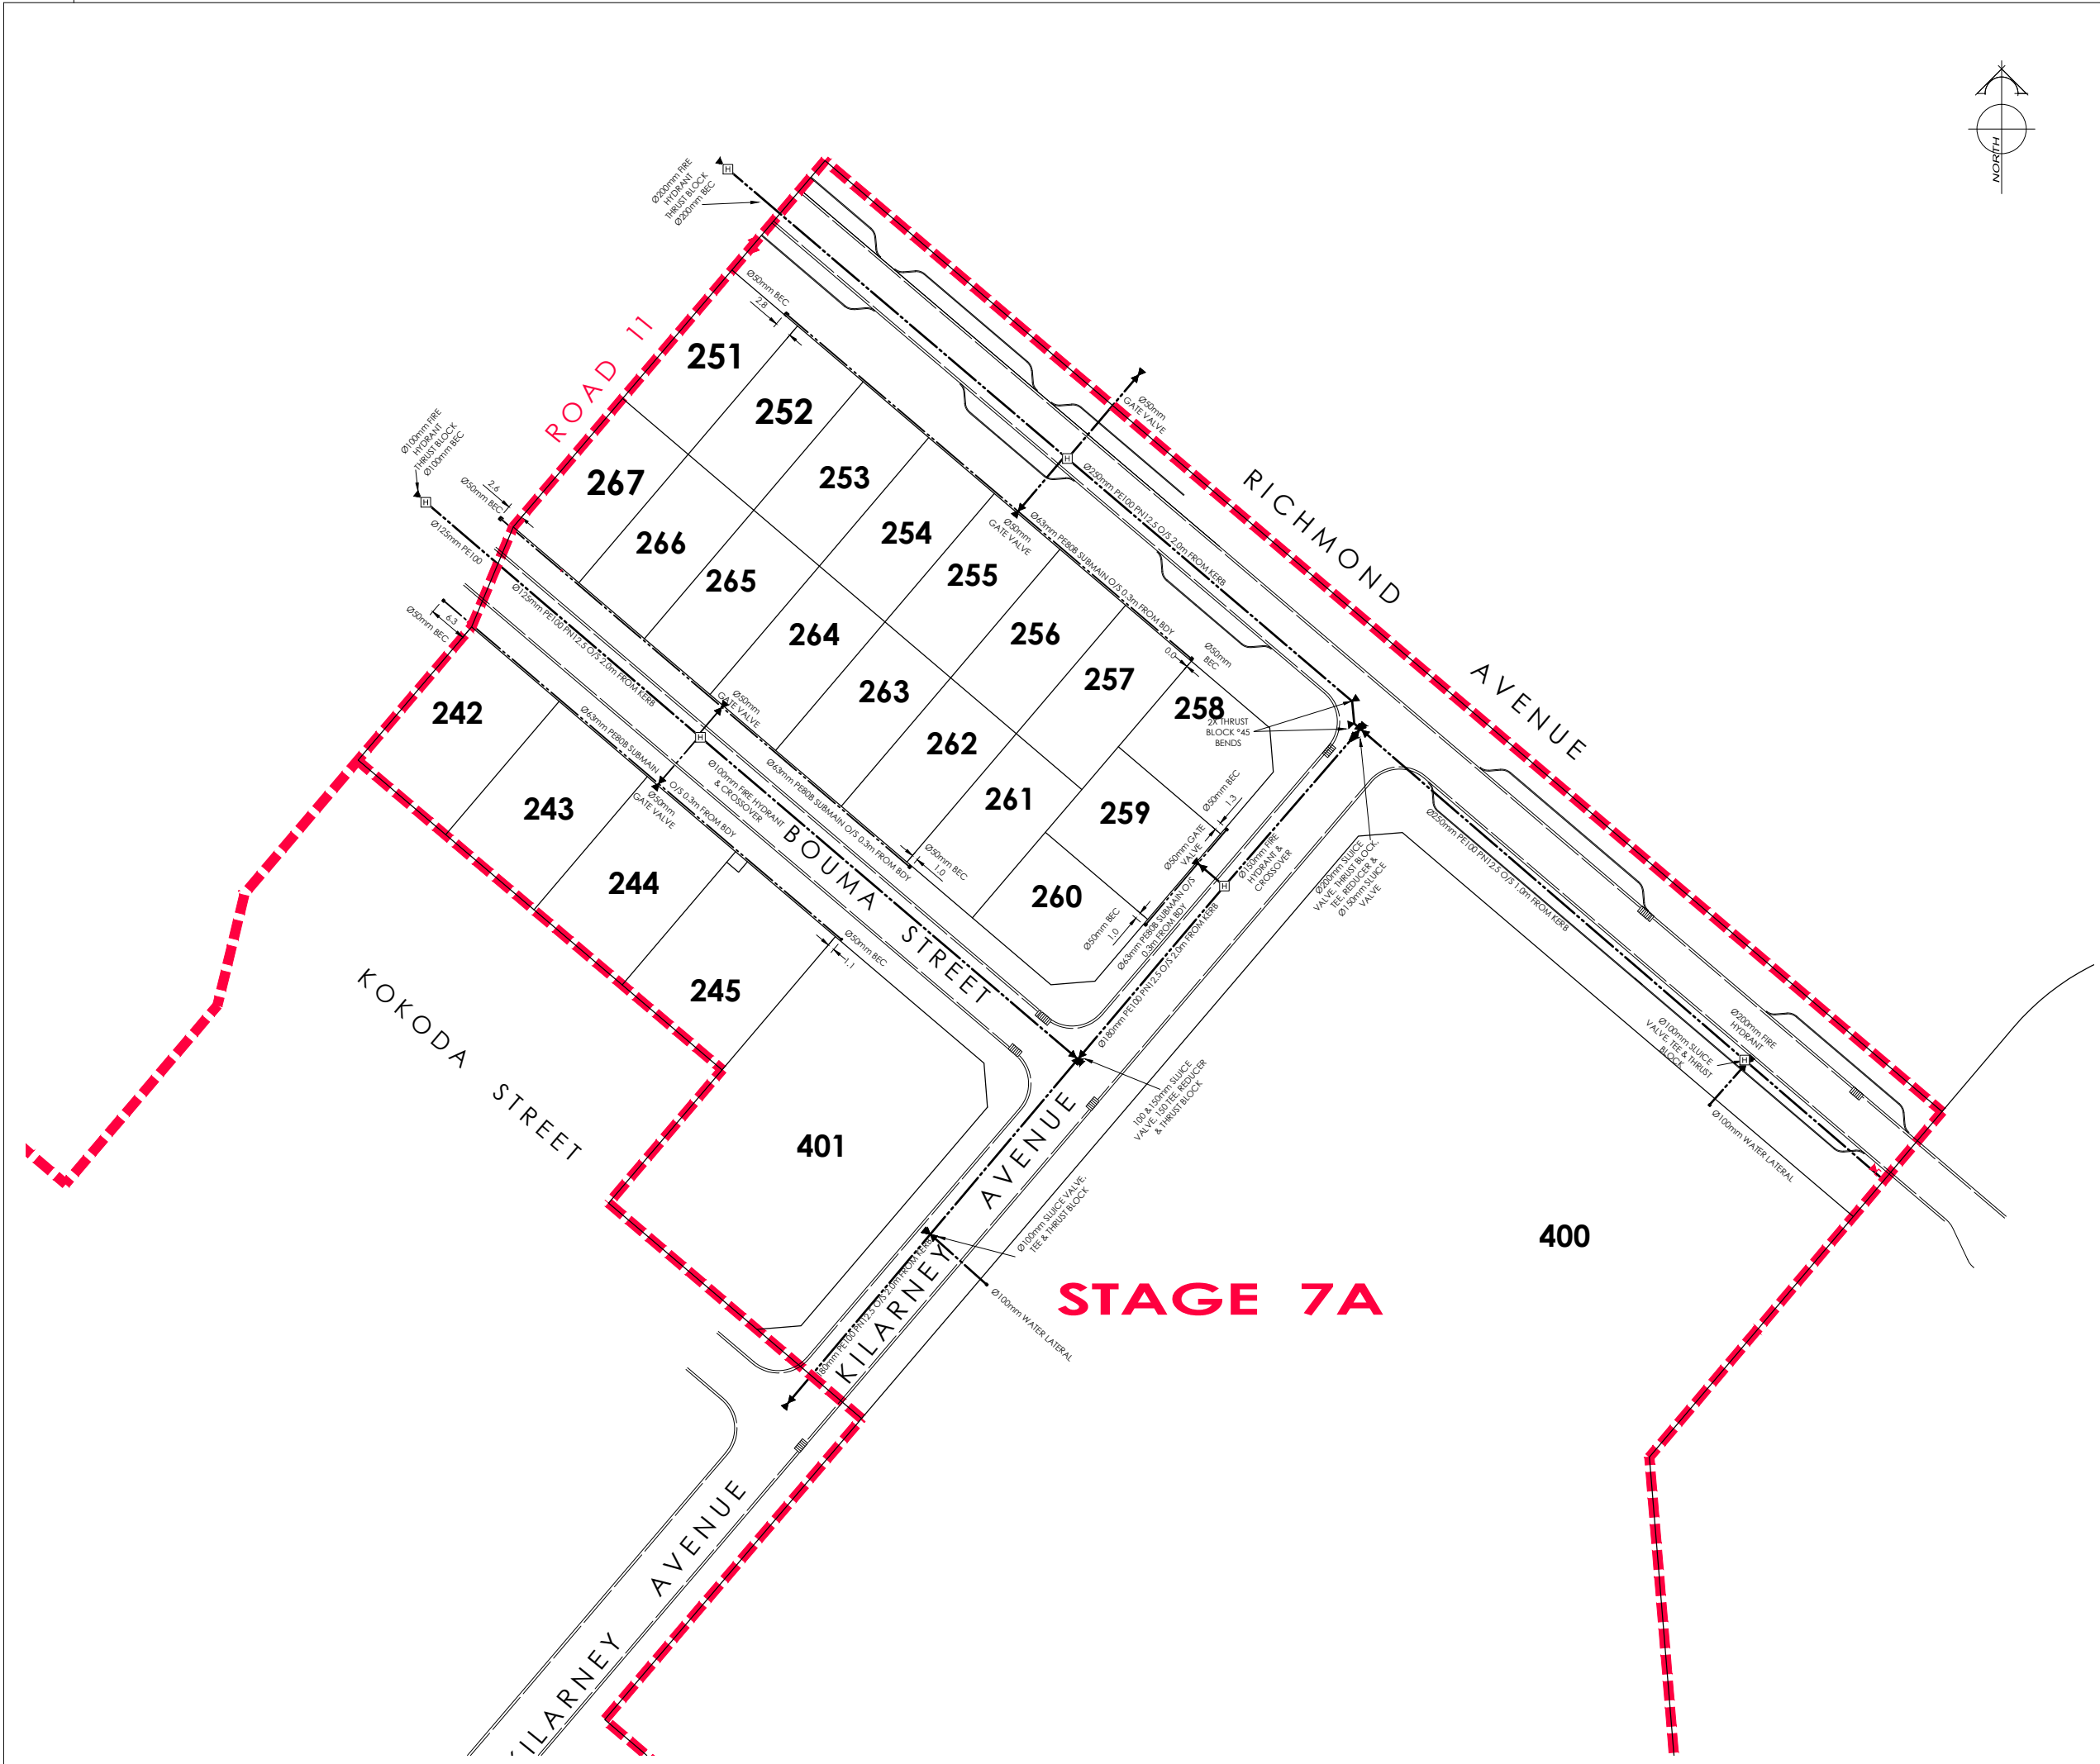

AMENDMENTS:		
AMENDMENT	DATE	DESCRIPTION

- NOTES:
- 1) This plan has been prepared for water asbuilt purposes only. No liability is accepted if the plan is used for any other purpose.
 - 2) Any measurements taken from information which is not dimensioned on the electronic copy are at the risk of the recipient.
 - 3) All roading and foot path information is not asbuilt and is for context purposes only.

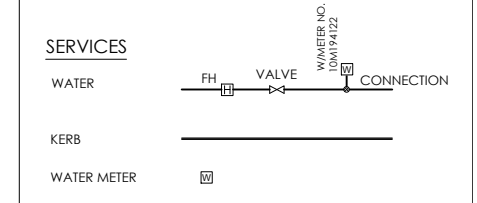

116 Wrights Road P O Box 679 Christchurch 8140. New Zealand
 Telephone: 03 379-0793 Website: www.dls.co.nz E-mail: office@dls.co.nz



JOB TITLE: **Fulton Hogan Land Development Knights Stream Park Stage 7**

SHEET TITLE: **Water - Asbuilt**

DRAWING STATUS: **Stages 7 Asbuilt**

SCALE: 1:500@A1 DATE: March 2015
 1:1000@A3

CAD FILE: J:\18447\ASBUILT\KSP7_AB.dwg REVISION:
 DRAWING No: SHEET No:
E.18447.AB01.W01 **RO**

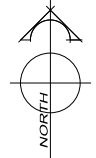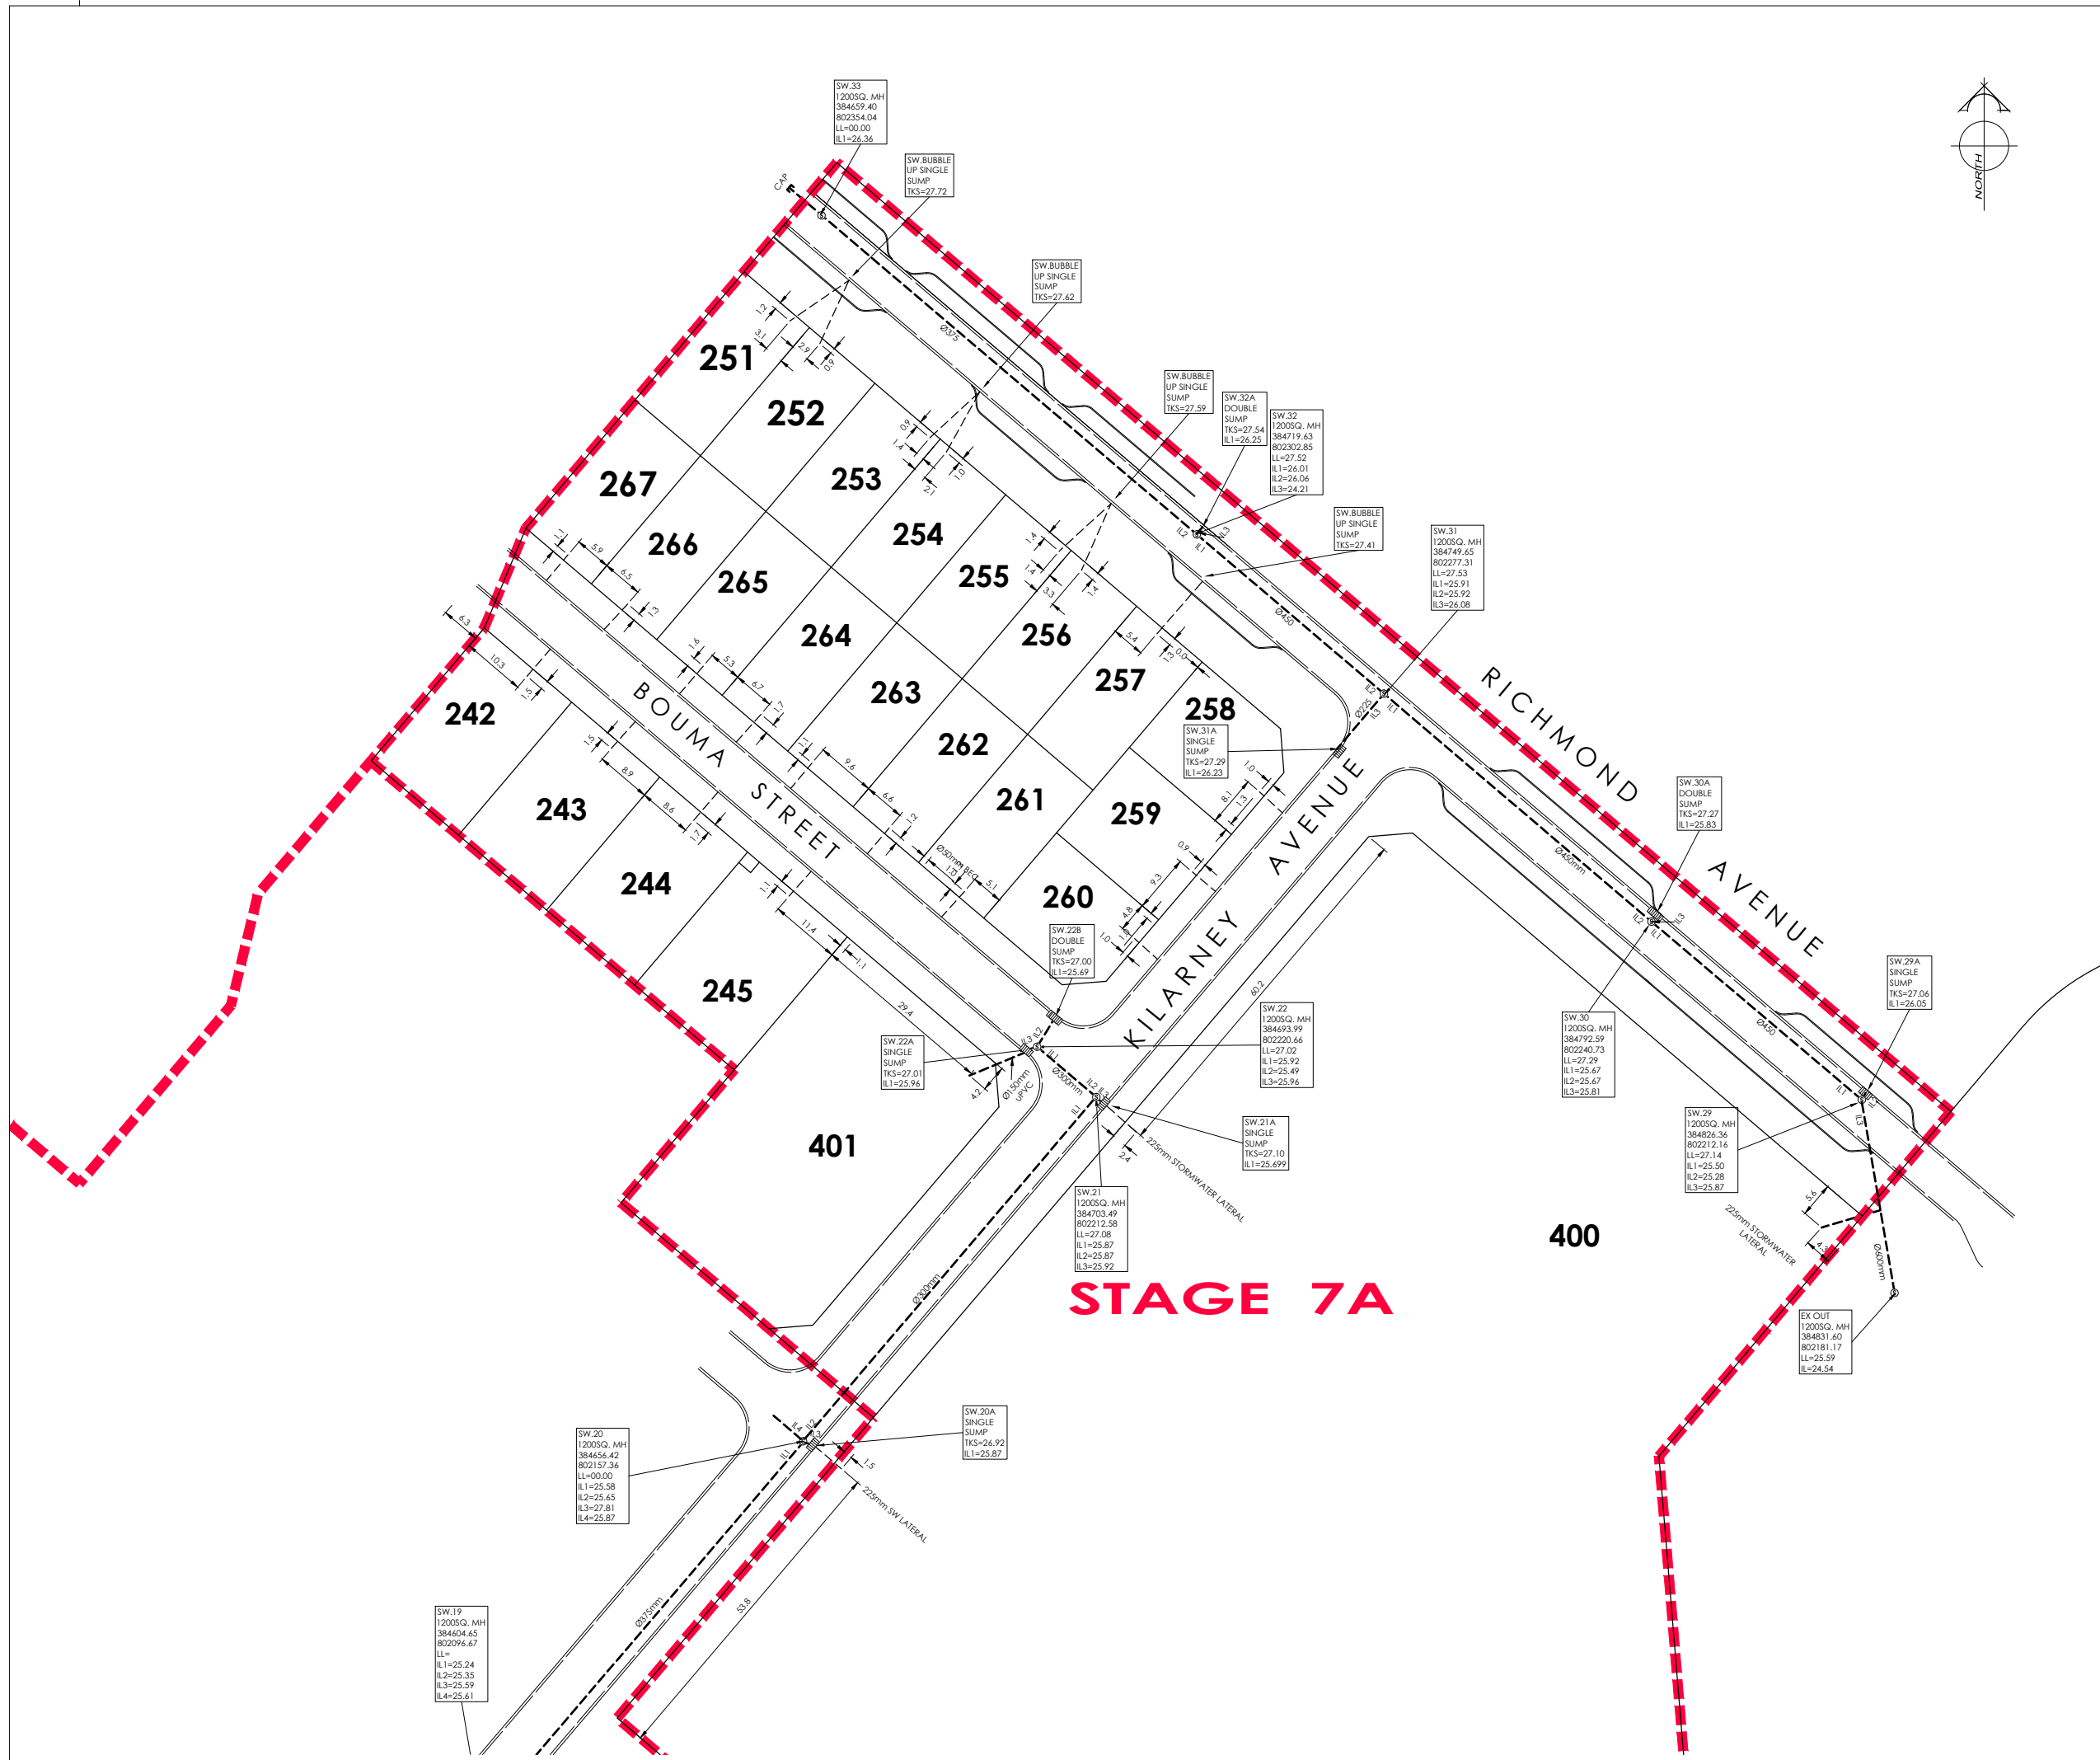

AMENDMENTS:		
AMENDMENT	DATE	DESCRIPTION

- NOTES:
- 1) This plan has been prepared for storm water asbuilt purposes only. No liability is accepted if the plan is used for any other purpose.
 - 2) Any measurements taken from information which is not dimensioned on the electronic copy are at the risk of the recipient.
 - 3) All roading and foot path information is not asbuilt and is for context purposes only.

SERVICES

STORMWATER MH

KERB

NOTES:

- 1) CONTOUR INTERVAL:
0.20m MINOR
1.00m MAJOR



116 Wrights Road P O Box 679 Christchurch 8140, New Zealand
Telephone: 03 379-0793 Website: www.dls.co.nz E-mail: office@dls.co.nz


JOB TITLE:
**Fulton Hogan Land Development
Knights Stream Park Stage 7**

SHEET TITLE:
Stormwater - Asbuilt

DRAWING STATUS:
Stages 7 Asbuilt

SCALE: 1:500@A1
1:1000@A3 DATE: March 2015

CAD FILE: J:\18447\ASBUILT\KSP7_AB.dwg REVISION:
DRAWING No: SHEET No:
E.18447.AB01.SW01 **RO**

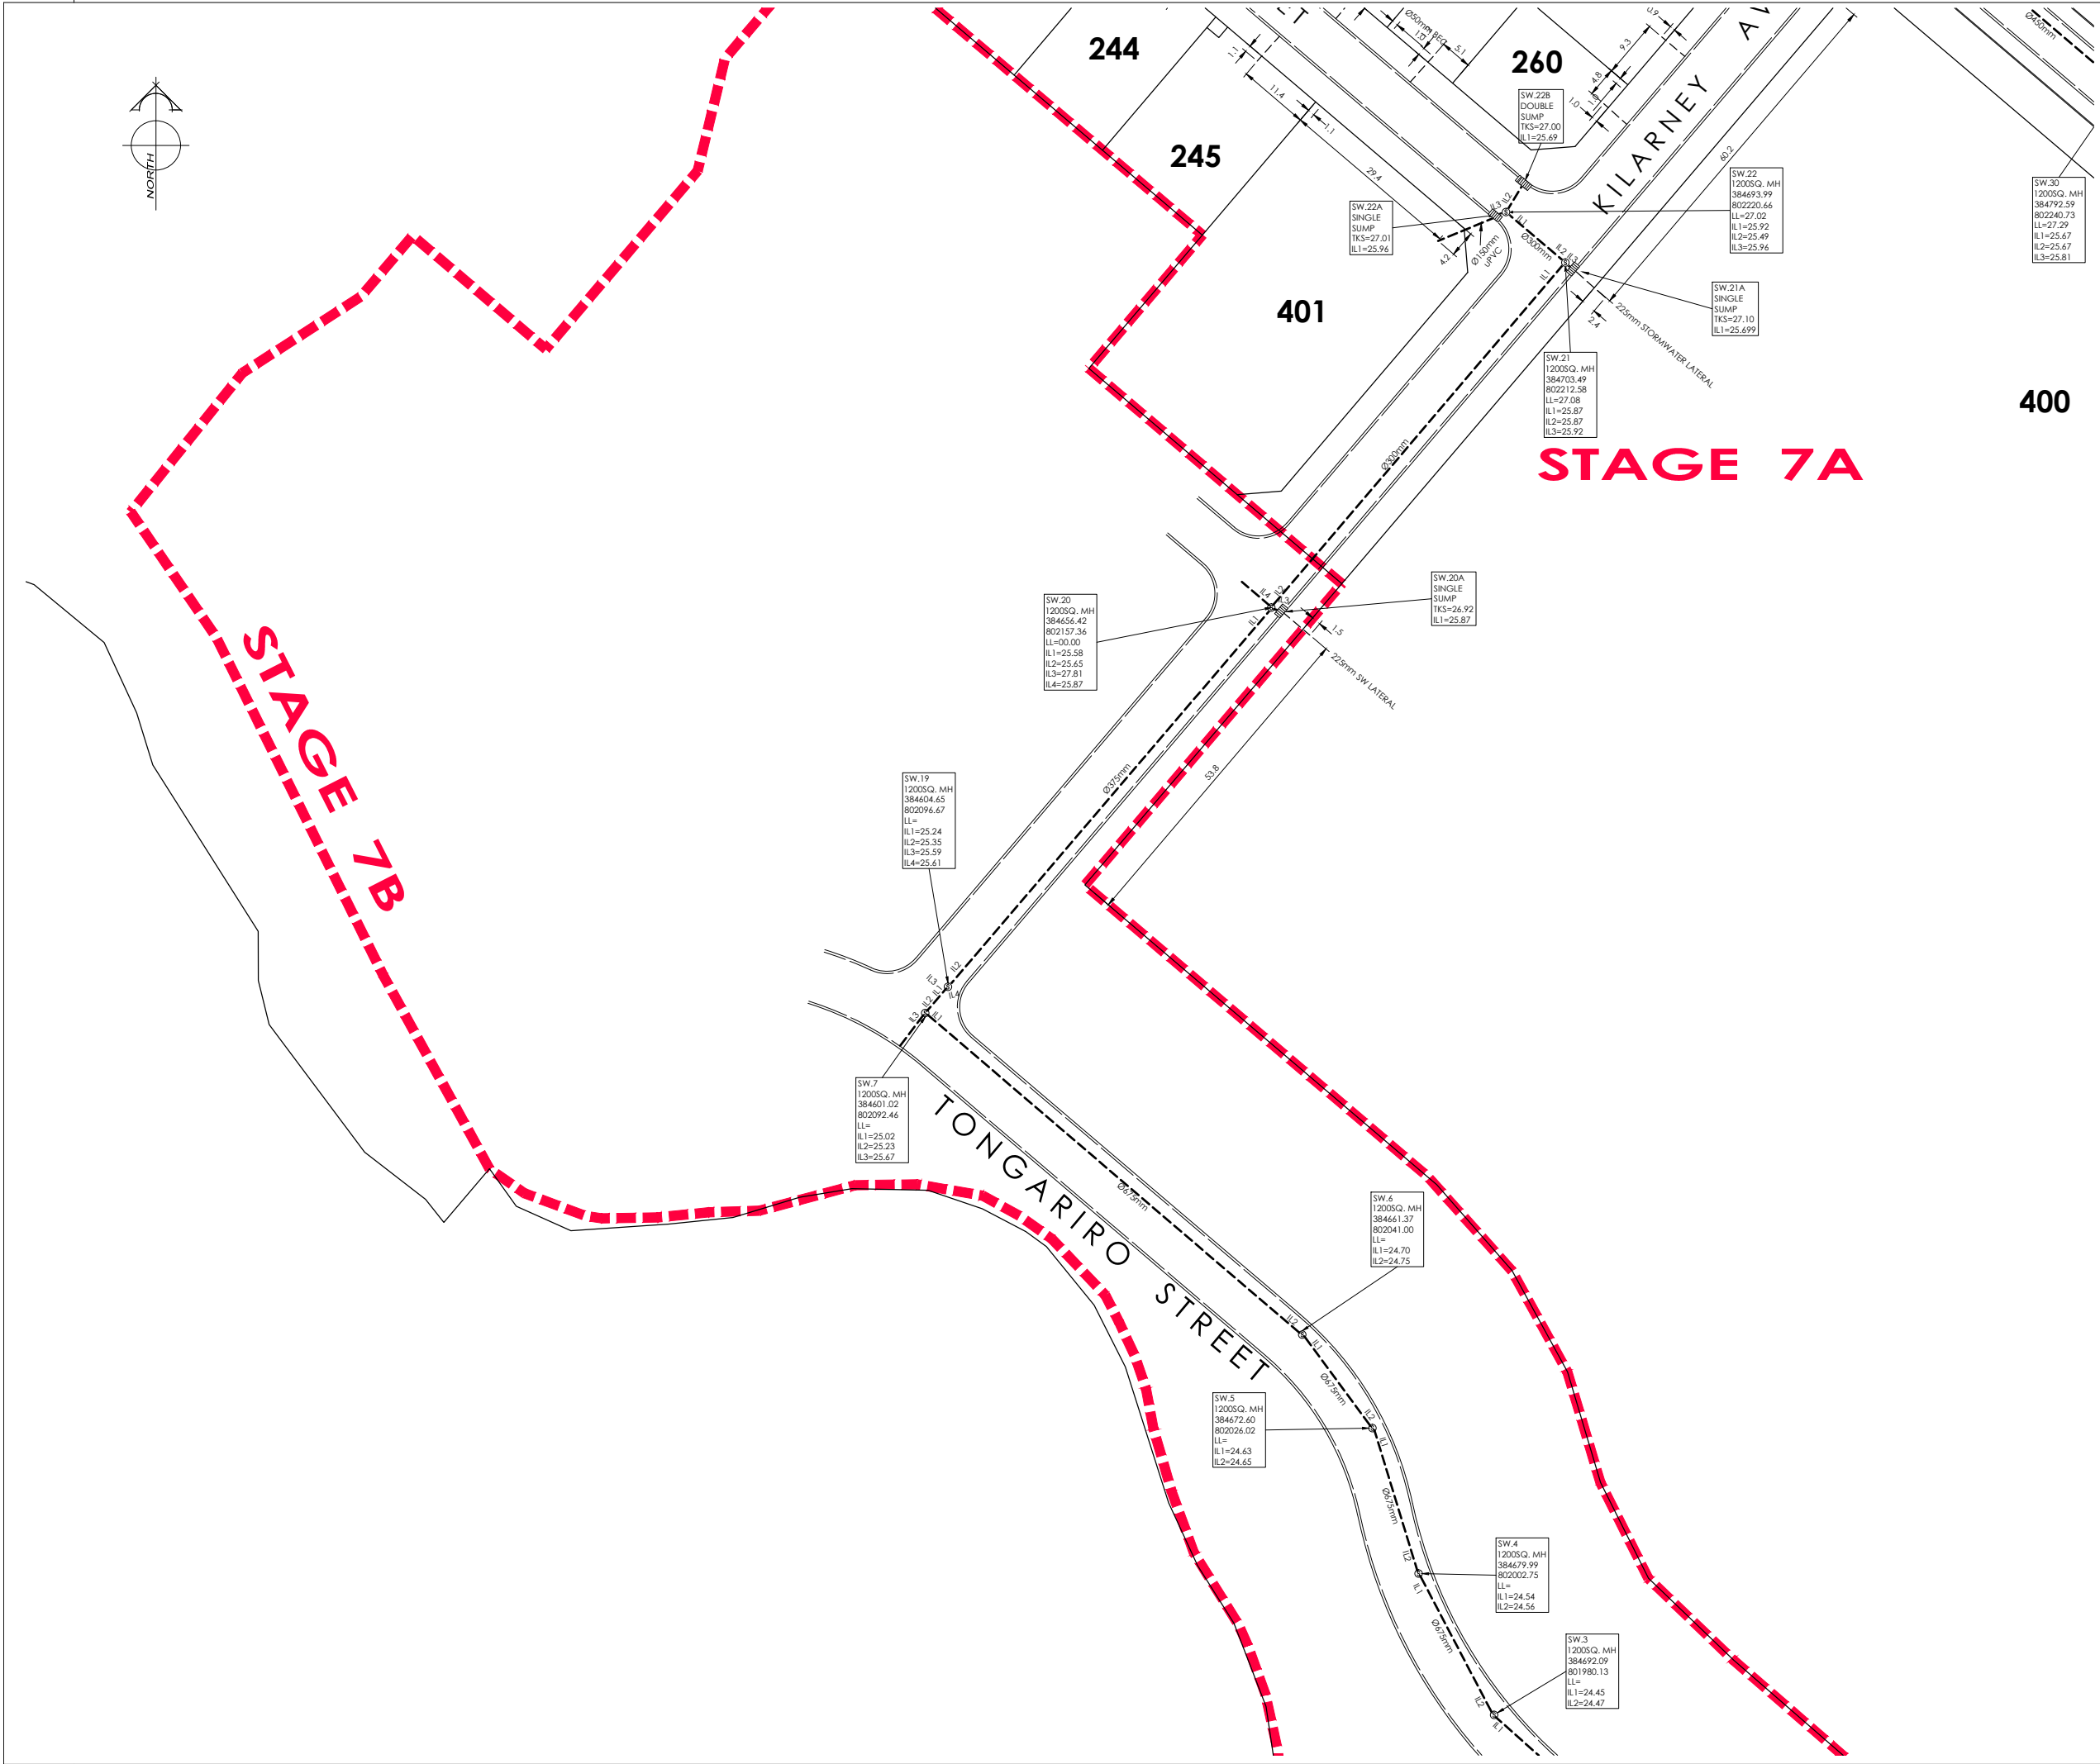

AMENDMENTS:

AMENDMENT	DATE	DESCRIPTION

- NOTES:
- 1) This plan has been prepared for storm water asbuilt purposes only. No liability is accepted if the plan is used for any other purpose.
 - 2) Any measurements taken from information which is not dimensioned on the electronic copy are at the risk of the recipient.
 - 3) All roading and foot path information is not asbuilt and is for context purposes only.

SERVICES

STORMWATER

KERB

NOTES:

- 1) CONTOUR INTERVAL:
0.20m MINOR
1.00m MAJOR



116 Wrights Road P O Box 679 Christchurch 8140, New Zealand
Telephone: 03 379-0793 Website: www.dls.co.nz E-mail: office@dls.co.nz


JOB TITLE:
**Fulton Hogan Land Development
Knights Stream Park Stage 7**

SHEET TITLE:
Stormwater - Asbuilt

DRAWING STATUS:
Stages 7 Asbuilt

SCALE: 1:500@A1 DATE: March 2015
1:1000@A3


CAD FILE: J:\18447\ASBUILT\KSP7_AB.dwg REVISION:
DRAWING No: SHEET No:
E.18447.AB01.SW02 **RO**

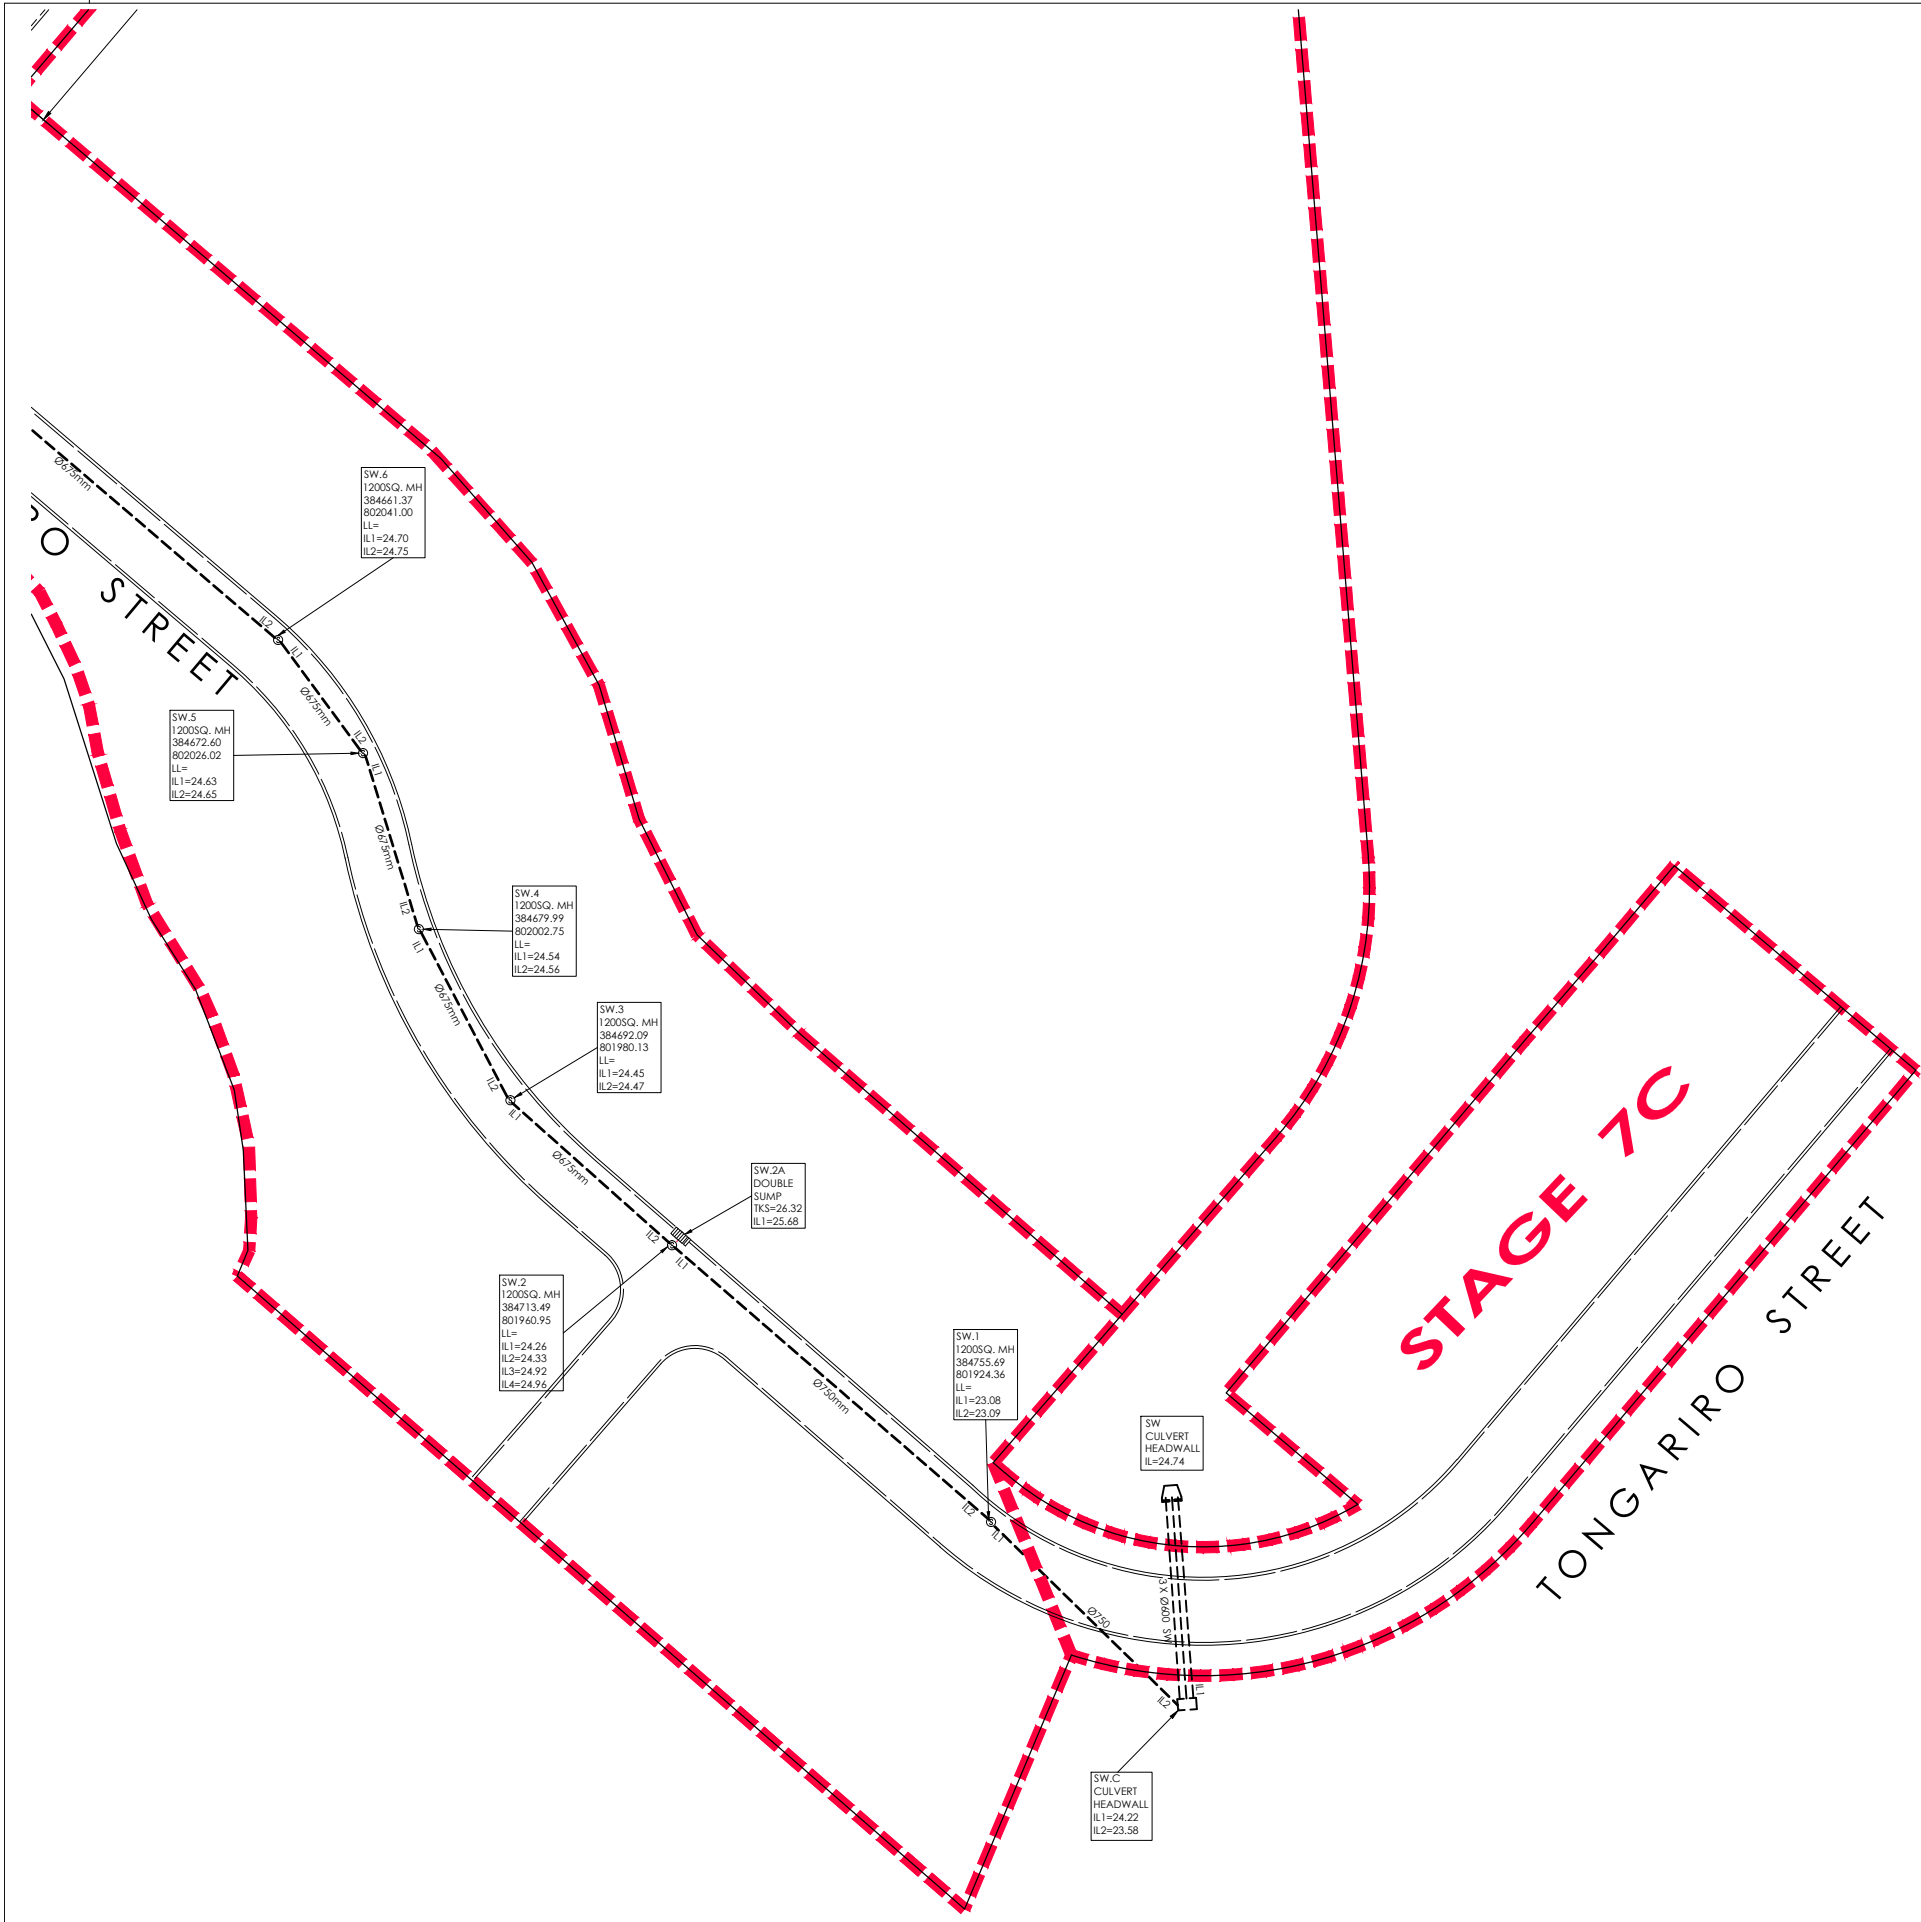

AMENDMENTS:		
AMENDMENT	DATE	DESCRIPTION

- NOTES:
- 1) This plan has been prepared for storm water asbuilt purposes only. No liability is accepted if the plan is used for any other purpose.
 - 2) Any measurements taken from information which is not dimensioned on the electronic copy are at the risk of the recipient.
 - 3) All roading and foot path information is not asbuilt and is for context purposes only.

SERVICES

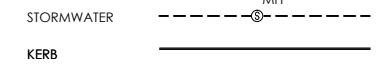

NOTES:

- 1) CONTOUR INTERVAL:
0.20m MINOR
1.00m MAJOR



116 Wrights Road P O Box 679 Christchurch 8140. New Zealand
Telephone: 03 379-0793 Website: www.dls.co.nz E-mail: office@dls.co.nz

JOB TITLE:
**Fulton Hogan Land Development
Knights Stream Park Stage 7**

SHEET TITLE:
Stormwater - Asbuilt

DRAWING STATUS:
Stages 7 Asbuilt

SCALE: 1:500@A1 DATE: March 2015
1:1000@A3

CAD FILE: J:\18447\ASBUILT\KSP7_AB.dwg REVISION:
DRAWING No: SHEET No:
E.18447.AB01.SW03 **RO**