


STAGE 7A

AMENDMENTS:		
AMENDMENT	DATE	DESCRIPTION

- NOTES:
- 1) This plan has been prepared for sewer asbuilt purposes only. No liability is accepted if the plan is used for any other purpose.
 - 2) Any measurements taken from information which is not dimensioned on the electronic copy are at the risk of the recipient.
 - 3) All roading and foot path information is not asbuilt and is for context purposes only.

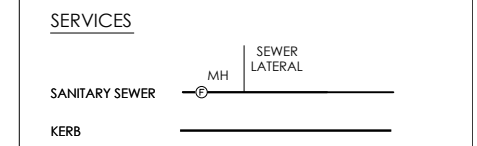

- NOTES:
- 1) ALL LATERAL POSITIONS HAVE BEEN PROVIDED BY CITY CARE LIMITED AND HAVE NOT BEEN VERIFIED.



116 Wrights Road P O Box 679 Christchurch 8140. New Zealand
 Telephone: 03 379-0793 Website: www.dls.co.nz E-mail: office@dls.co.nz


JOB TITLE: **Fulton Hogan Land Development Knights Stream Park Stage 7**

SHEET TITLE: **Sewer - Asbuilt**

DRAWING STATUS: **Stages 7 Asbuilt**

SCALE: 1:500@A1 1:1000@A3 DATE: June 2015

CAD FILE: J:\18447\ASBUILT\KSP7_AB.dwg SHEET No: **E.18447.AB01.SS01** REVISION: **RO**

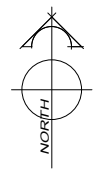

SS.12
STD. MH
384495.83
802202.44
LL=0
IL1=25.95

SS.11
VENTED.
MH
384513.36
802181.61
LL=0
IL1=25.80
IL2=25.77

SS.10
STD. MH
384545.44
802117.31
LL=0
IL1=25.43
IL2=25.43

SS.9
VENTED.
MH
384570.00
802101.07
LL=0
IL1=25.30
IL2=25.31

SS.8
STD. MH
384597.41
802091.84
LL=0
IL1=25.14
IL2=25.17
IL3=25.20

SS.7
STD. MH
384666.33
802031.88
LL=0
IL1=24.82
IL2=24.83

SS.6
VENTED.
MH
384676.72
802005.31
LL=0
IL1=24.71
IL2=24.72


SS.5
STD. MH
384688.78
801980.99
LL=0
IL1=24.57
IL2=24.59

SS.43
VENTED.
MH
384645.88
802264.18
LL=27.46
IL1=26.18
IL2=26.20

SS.42
1200SQ.
MH
384702.91
802215.55
LL=27.16
IL1=25.77
IL2=25.83


SS.31
STD. MH
384655.87
802160.42
LL=26.89
IL1=25.69
IL2=25.64

SS.32
STD. MH
384579.68
802225.32
LL=00.00
IL1=26.15

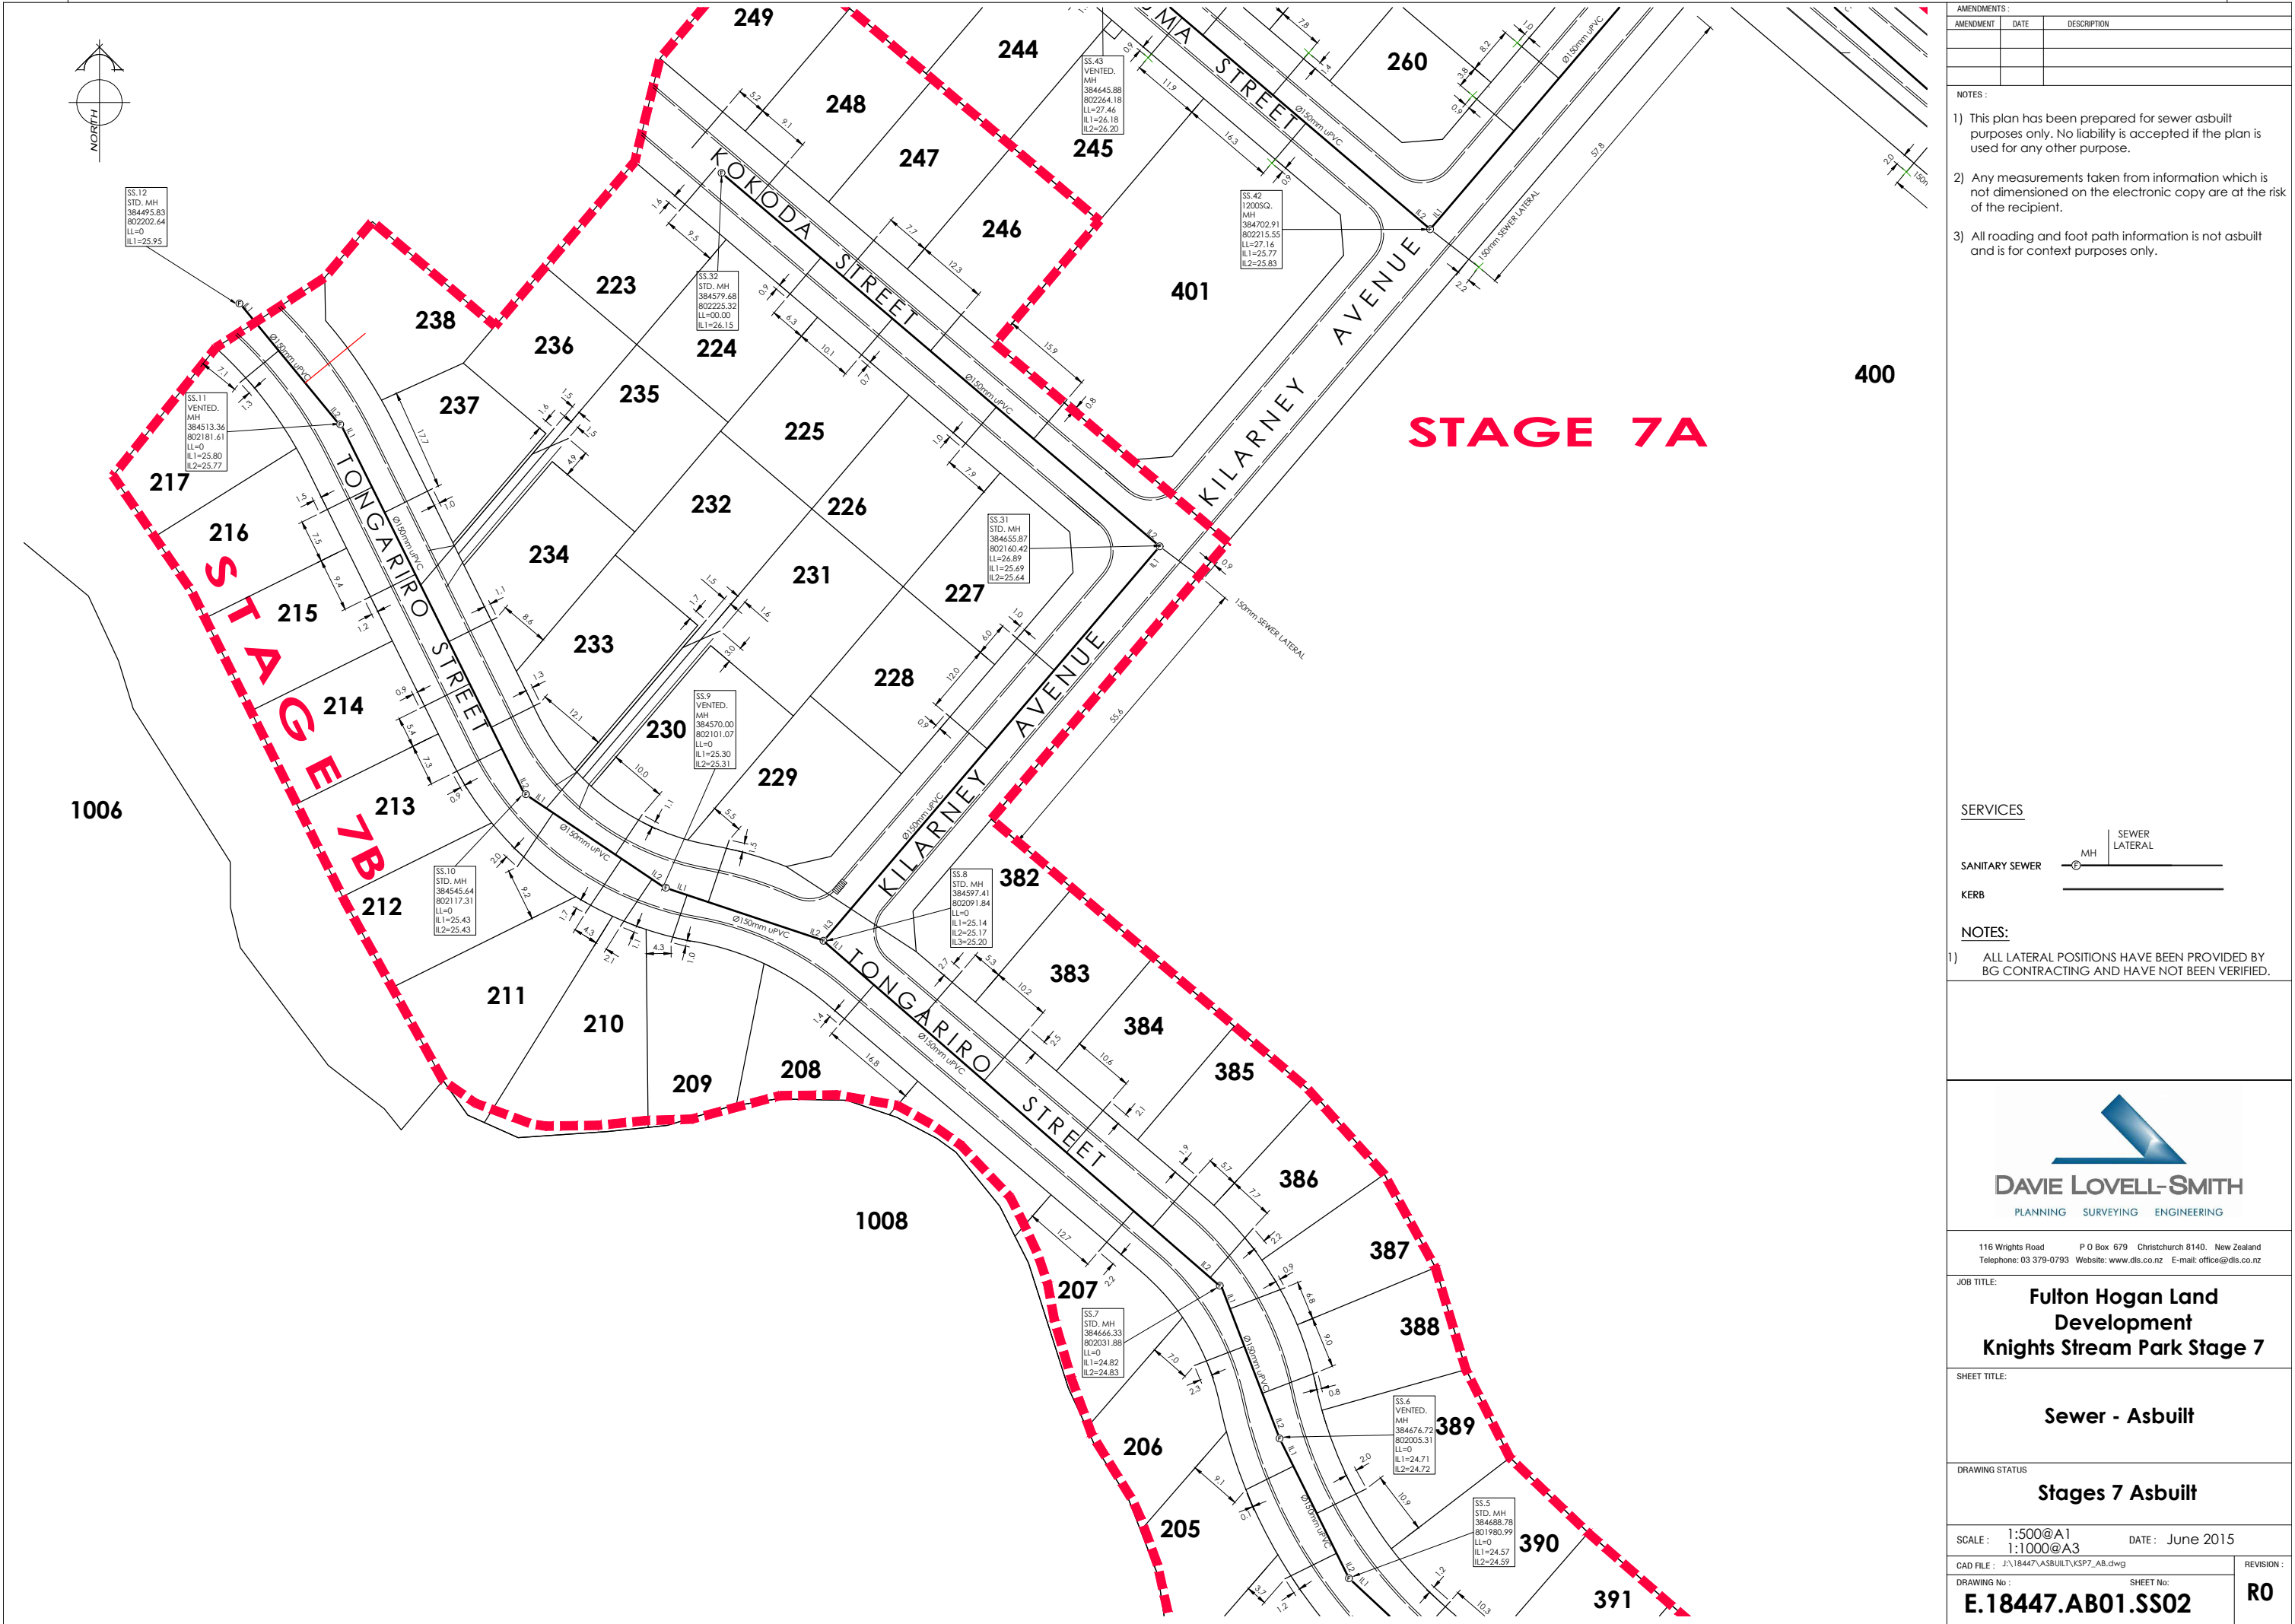

AMENDMENTS:		
AMENDMENT	DATE	DESCRIPTION

- NOTES:
- 1) This plan has been prepared for sewer asbuilt purposes only. No liability is accepted if the plan is used for any other purpose.
 - 2) Any measurements taken from information which is not dimensioned on the electronic copy are at the risk of the recipient.
 - 3) All roading and foot path information is not asbuilt and is for context purposes only.

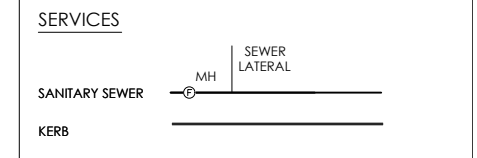

- NOTES:
- 1) ALL LATERAL POSITIONS HAVE BEEN PROVIDED BY BG CONTRACTING AND HAVE NOT BEEN VERIFIED.



116 Wrights Road P O Box 679 Christchurch 8140, New Zealand
Telephone: 03 379-0793 Website: www.dls.co.nz E-mail: office@dls.co.nz


JOB TITLE:
**Fulton Hogan Land Development
Knights Stream Park Stage 7**

SHEET TITLE:
Sewer - Asbuilt

DRAWING STATUS:
Stages 7 Asbuilt


SCALE: 1:500@A1 DATE: June 2015
1:1000@A3

CAD FILE: J:\18447\ASBUILT\KSP7_AB.dwg REVISION:
DRAWING No: SHEET No:
E.18447.AB01.SS02 **RO**

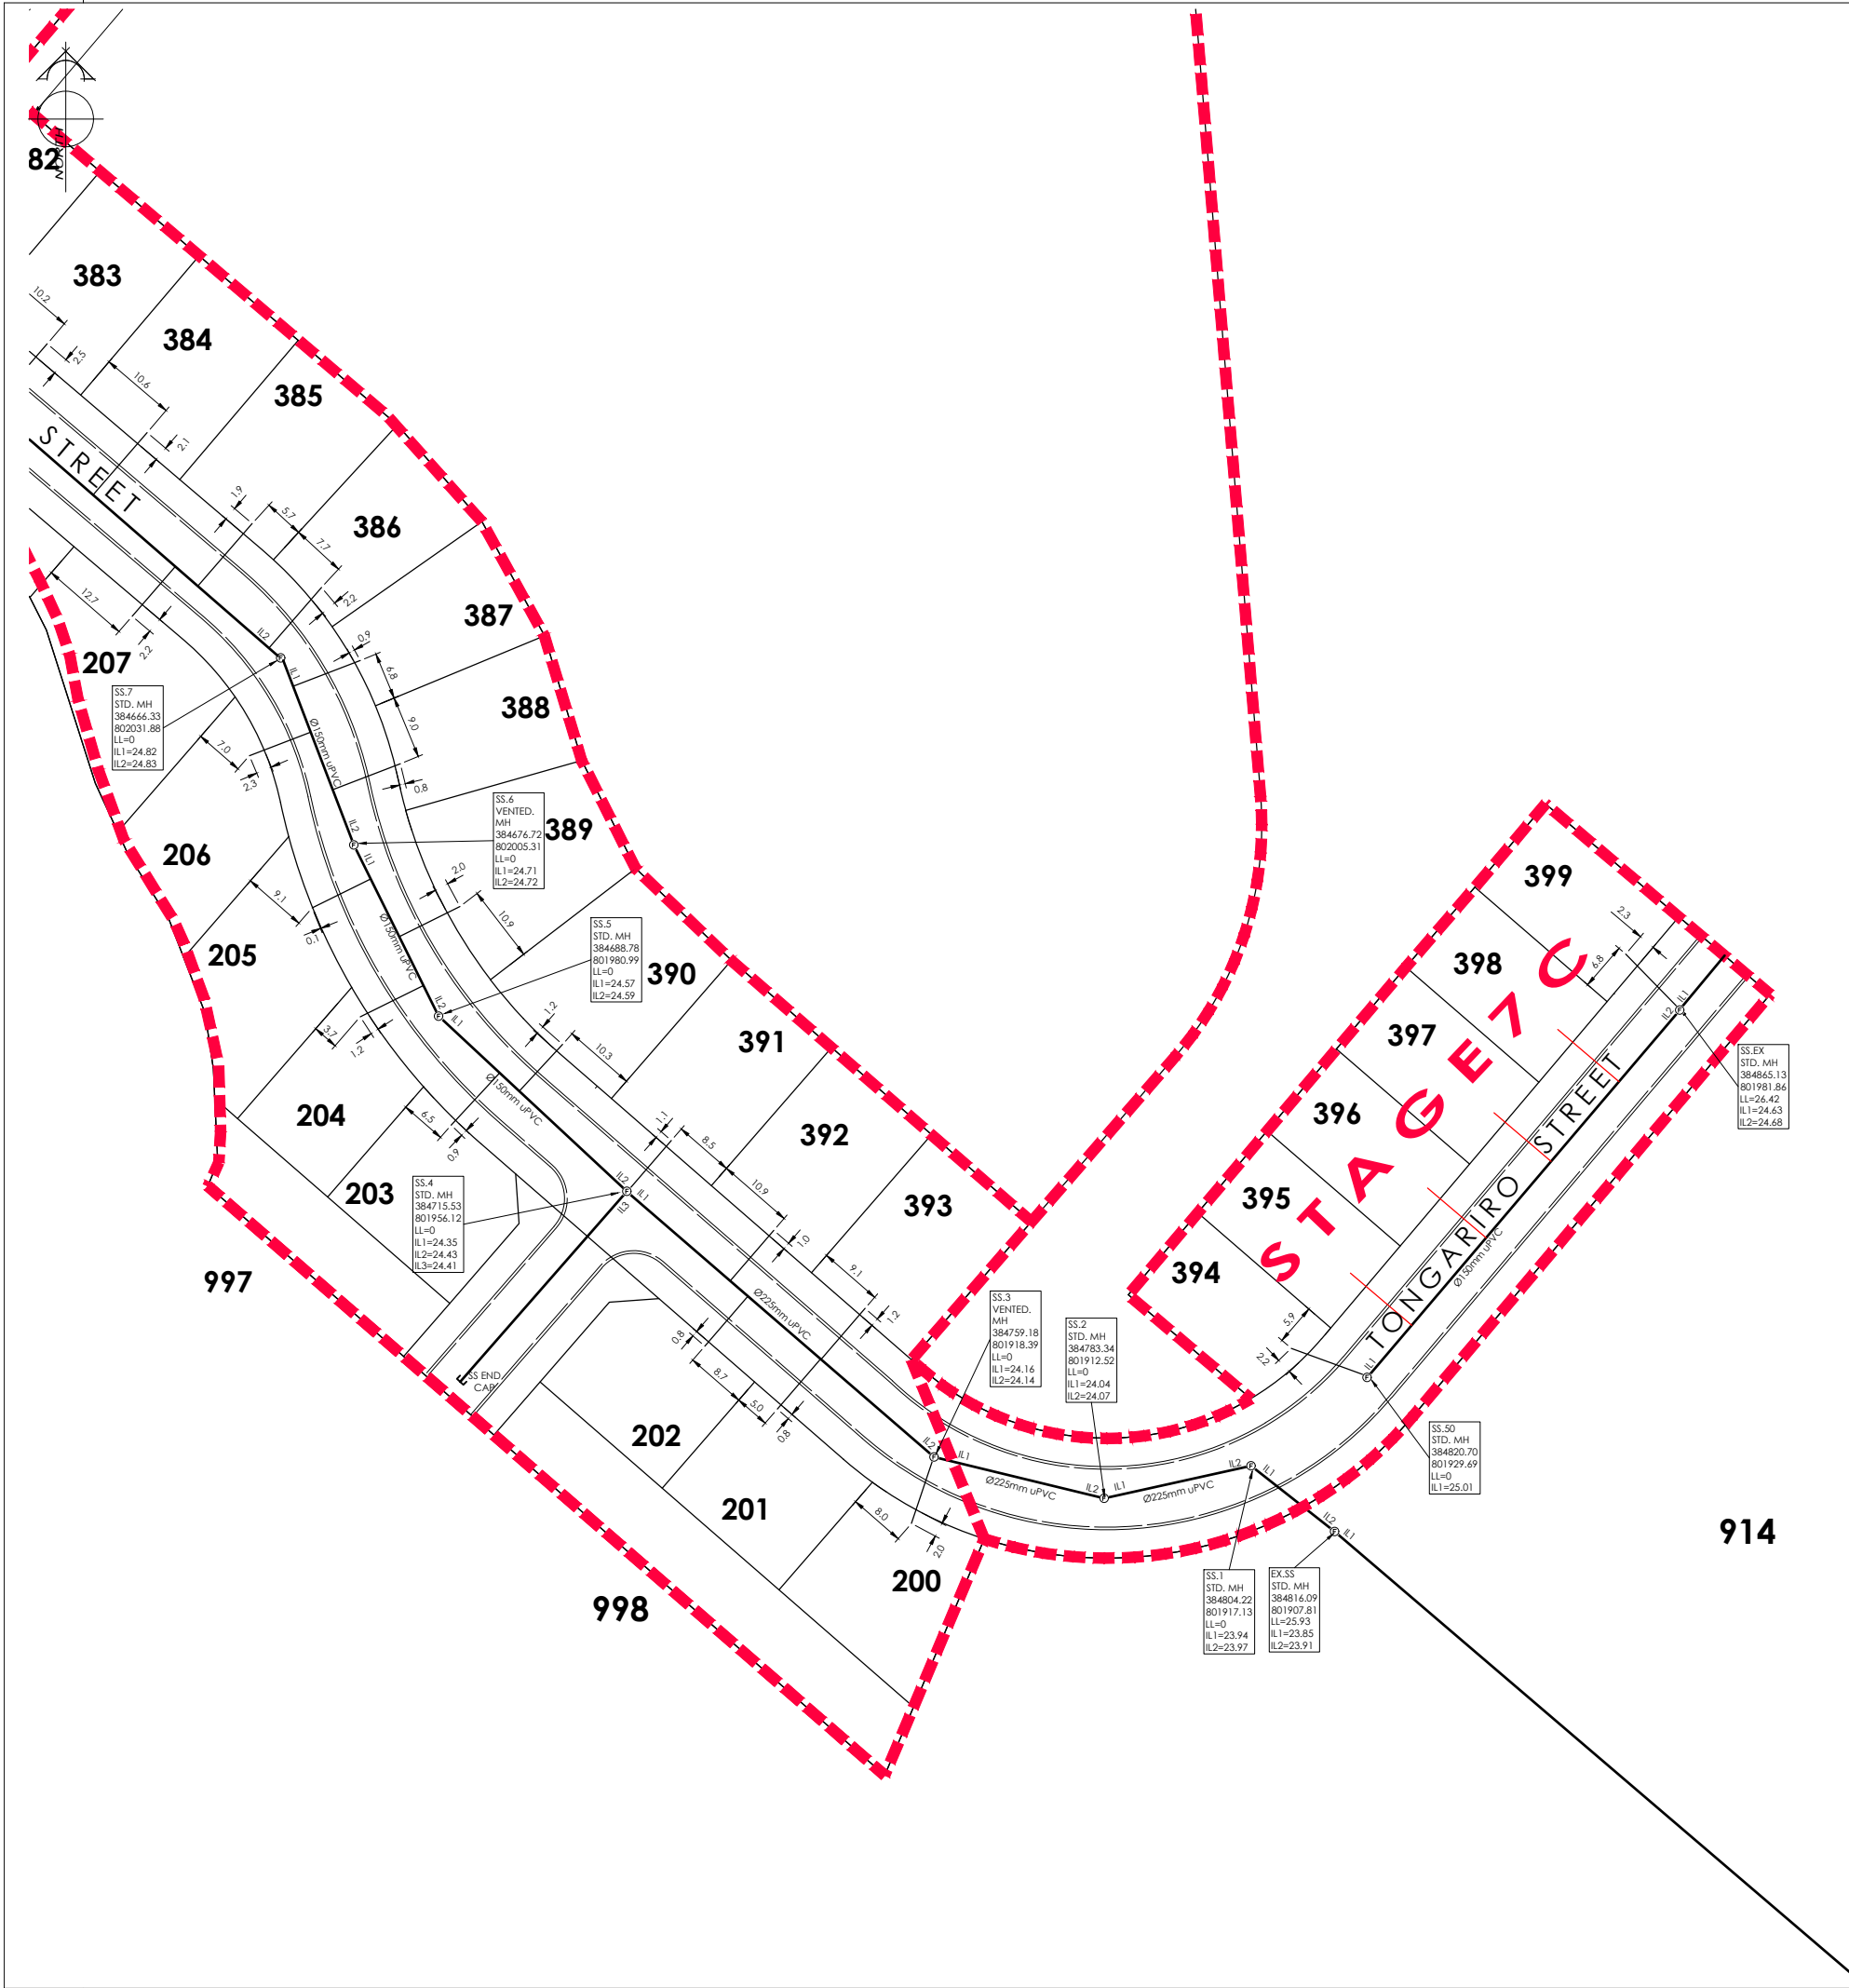

AMENDMENTS:		
AMENDMENT	DATE	DESCRIPTION

- NOTES:
- 1) This plan has been prepared for sewer asbuilt purposes only. No liability is accepted if the plan is used for any other purpose.
 - 2) Any measurements taken from information which is not dimensioned on the electronic copy are at the risk of the recipient.
 - 3) All roading and foot path information is not asbuilt and is for context purposes only.

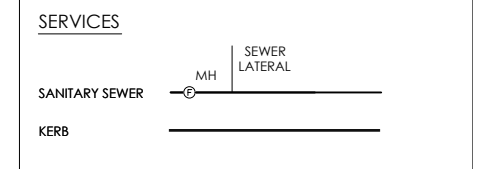

- NOTES:
- 1) ALL LATERAL POSITIONS HAVE BEEN PROVIDED BY BG CONTRACTING AND HAVE NOT BEEN VERIFIED.



116 Wrights Road P O Box 679 Christchurch 8140. New Zealand
 Telephone: 03 379-0793 Website: www.dls.co.nz E-mail: office@dls.co.nz


JOB TITLE:
**Fulton Hogan Land Development
 Knights Stream Park Stage 7**

SHEET TITLE:
Sewer - Asbuilt

DRAWING STATUS:
Stages 7 Asbuilt


SCALE: 1:500@A1 DATE: June 2015
 1:1000@A3

CAD FILE: J:\18447\ASBUILT\KSP7_AB.dwg REVISION:
 DRAWING No: E.18447.AB01.SS03 SHEET No: RO

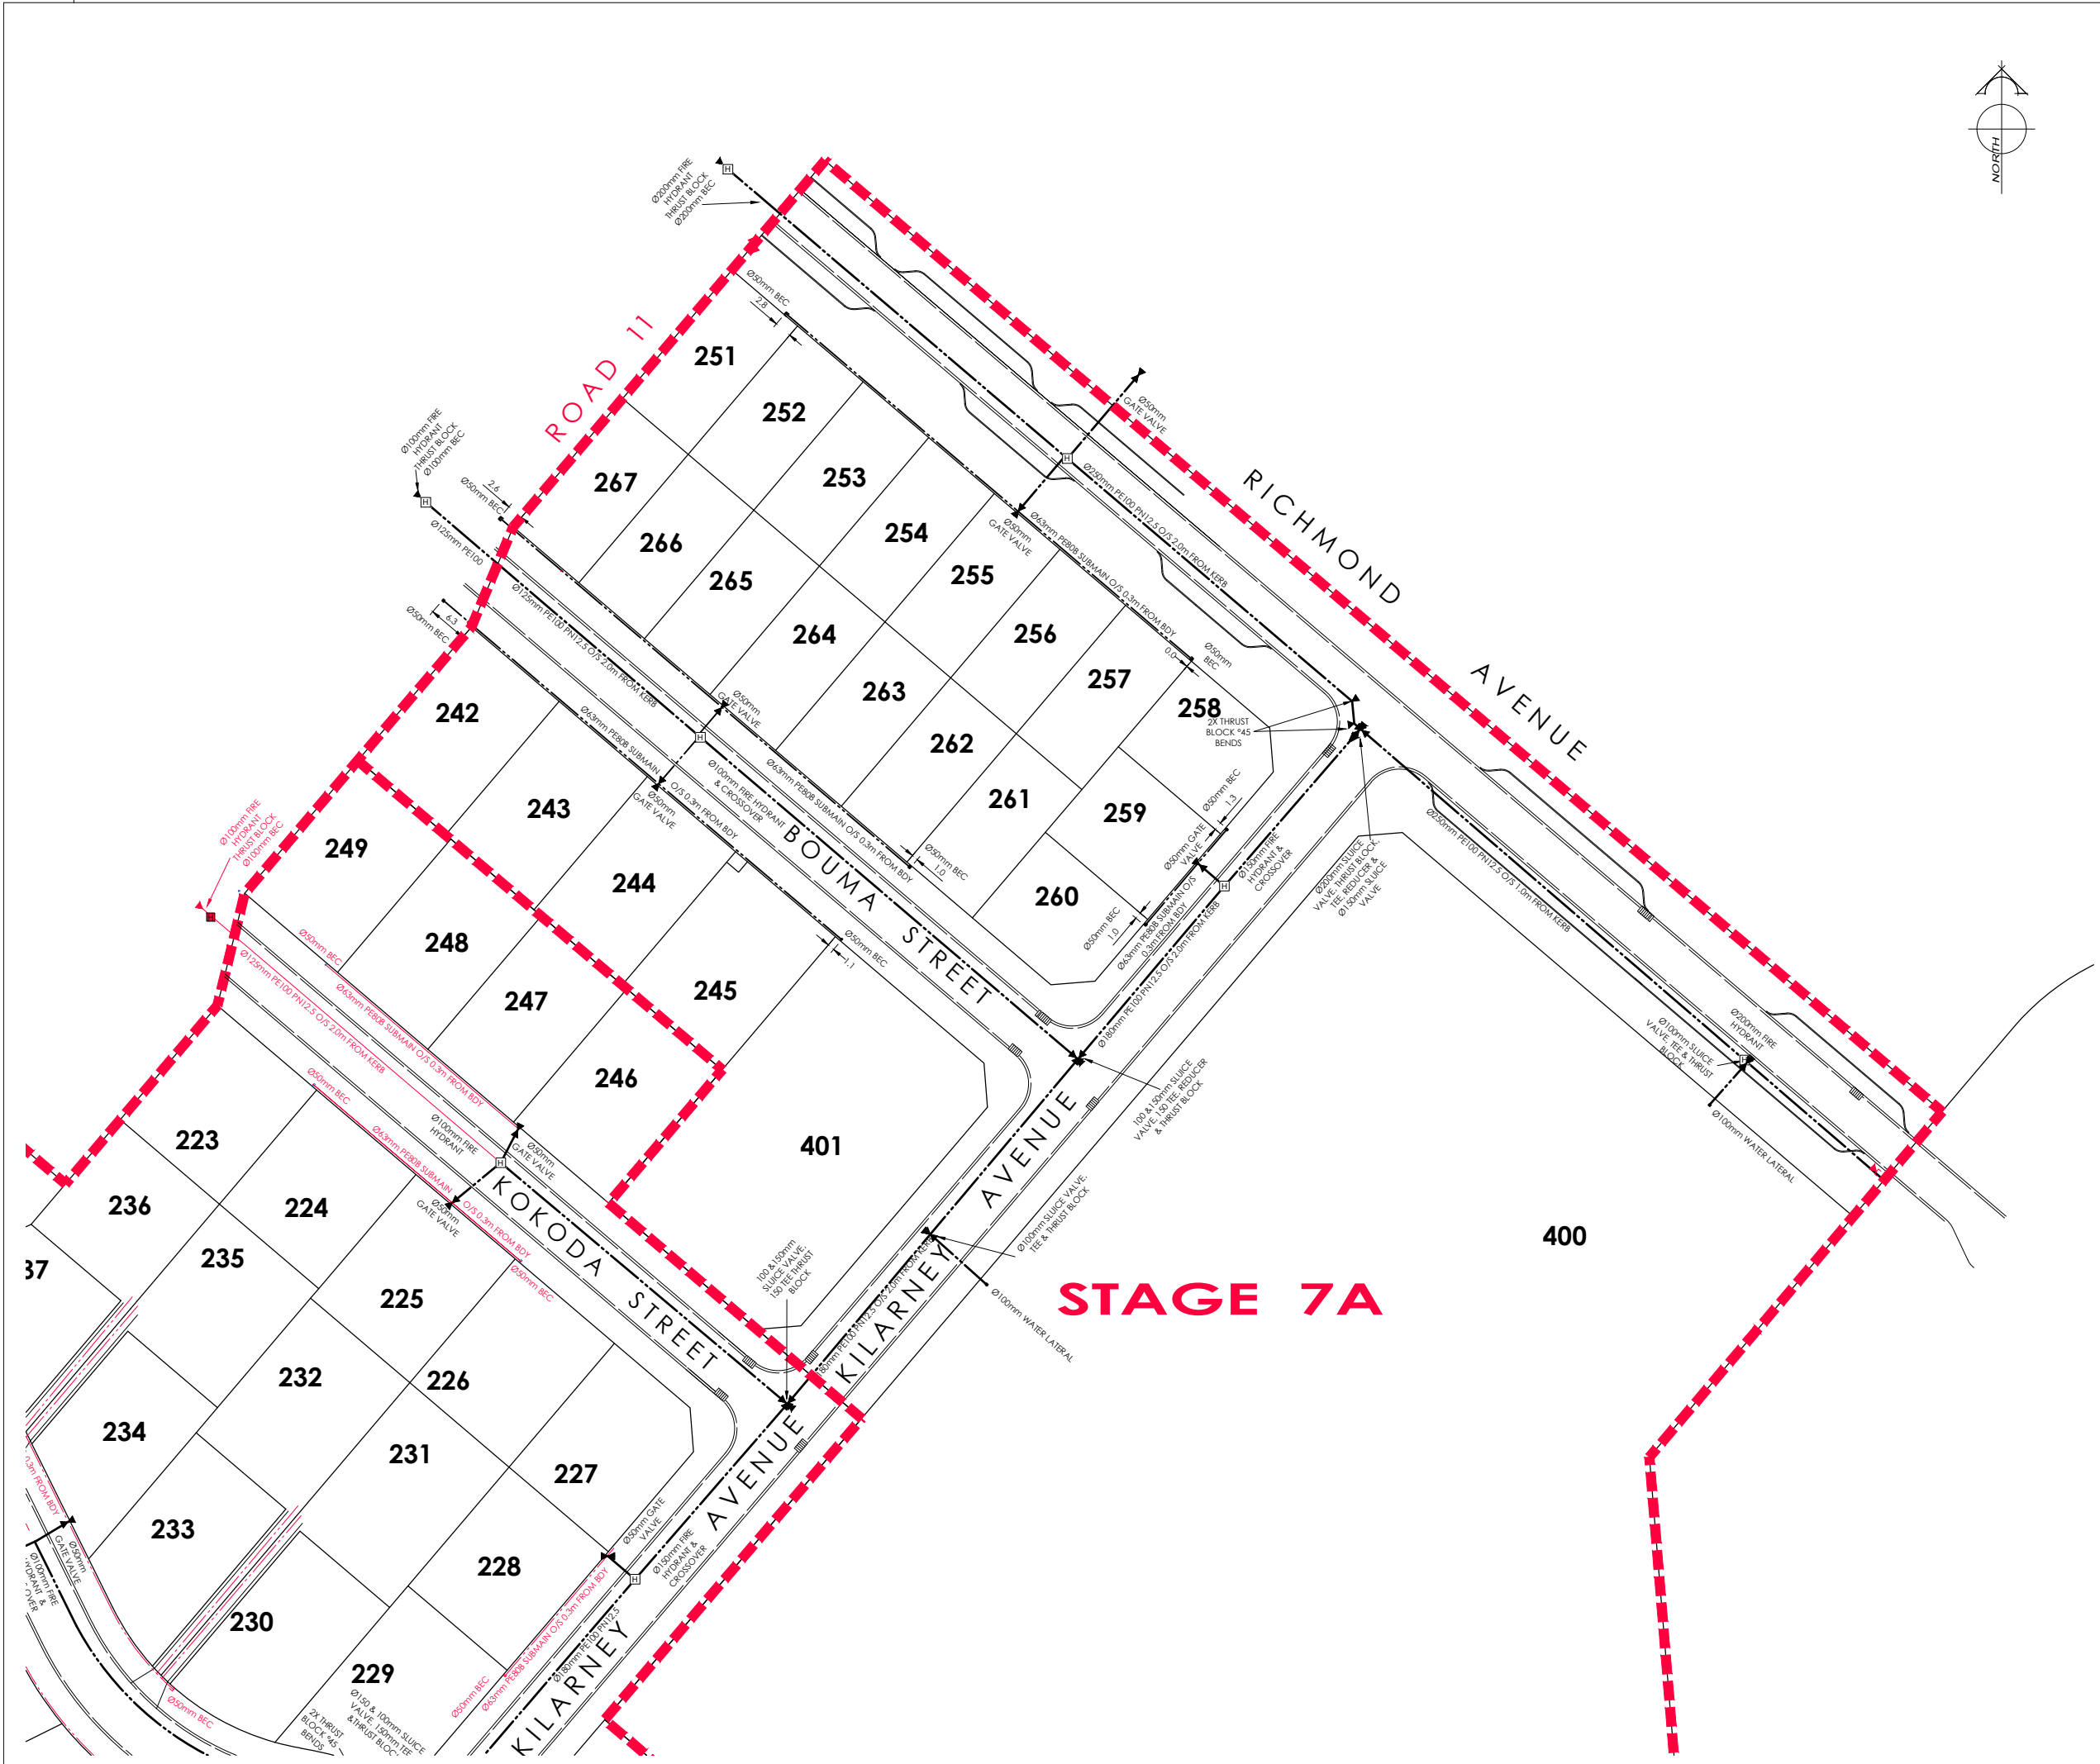

AMENDMENTS:		
AMENDMENT	DATE	DESCRIPTION

- NOTES:
- 1) This plan has been prepared for water asbuilt purposes only. No liability is accepted if the plan is used for any other purpose.
 - 2) Any measurements taken from information which is not dimensioned on the electronic copy are at the risk of the recipient.
 - 3) All roading and foot path information is not asbuilt and is for context purposes only.

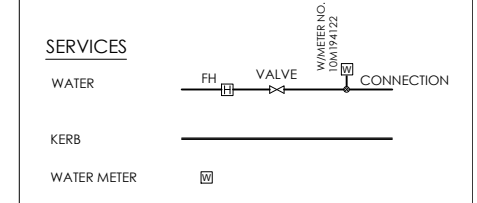

116 Wrights Road P O Box 679 Christchurch 8140, New Zealand
 Telephone: 03 379-0793 Website: www.dls.co.nz E-mail: office@dls.co.nz



JOB TITLE: **Fulton Hogan Land Development Knights Stream Park Stage 7**

SHEET TITLE: **Water - Asbuilt**

DRAWING STATUS: **Stages 7 Asbuilt**

SCALE: 1:500@A1 DATE: June 2015
 1:1000@A3


CAD FILE: J:\18447\ASBUILT\KSP7_AB.dwg SHEET No: **E.18447.AB01.W01** REVISION: **RO**

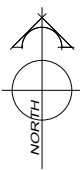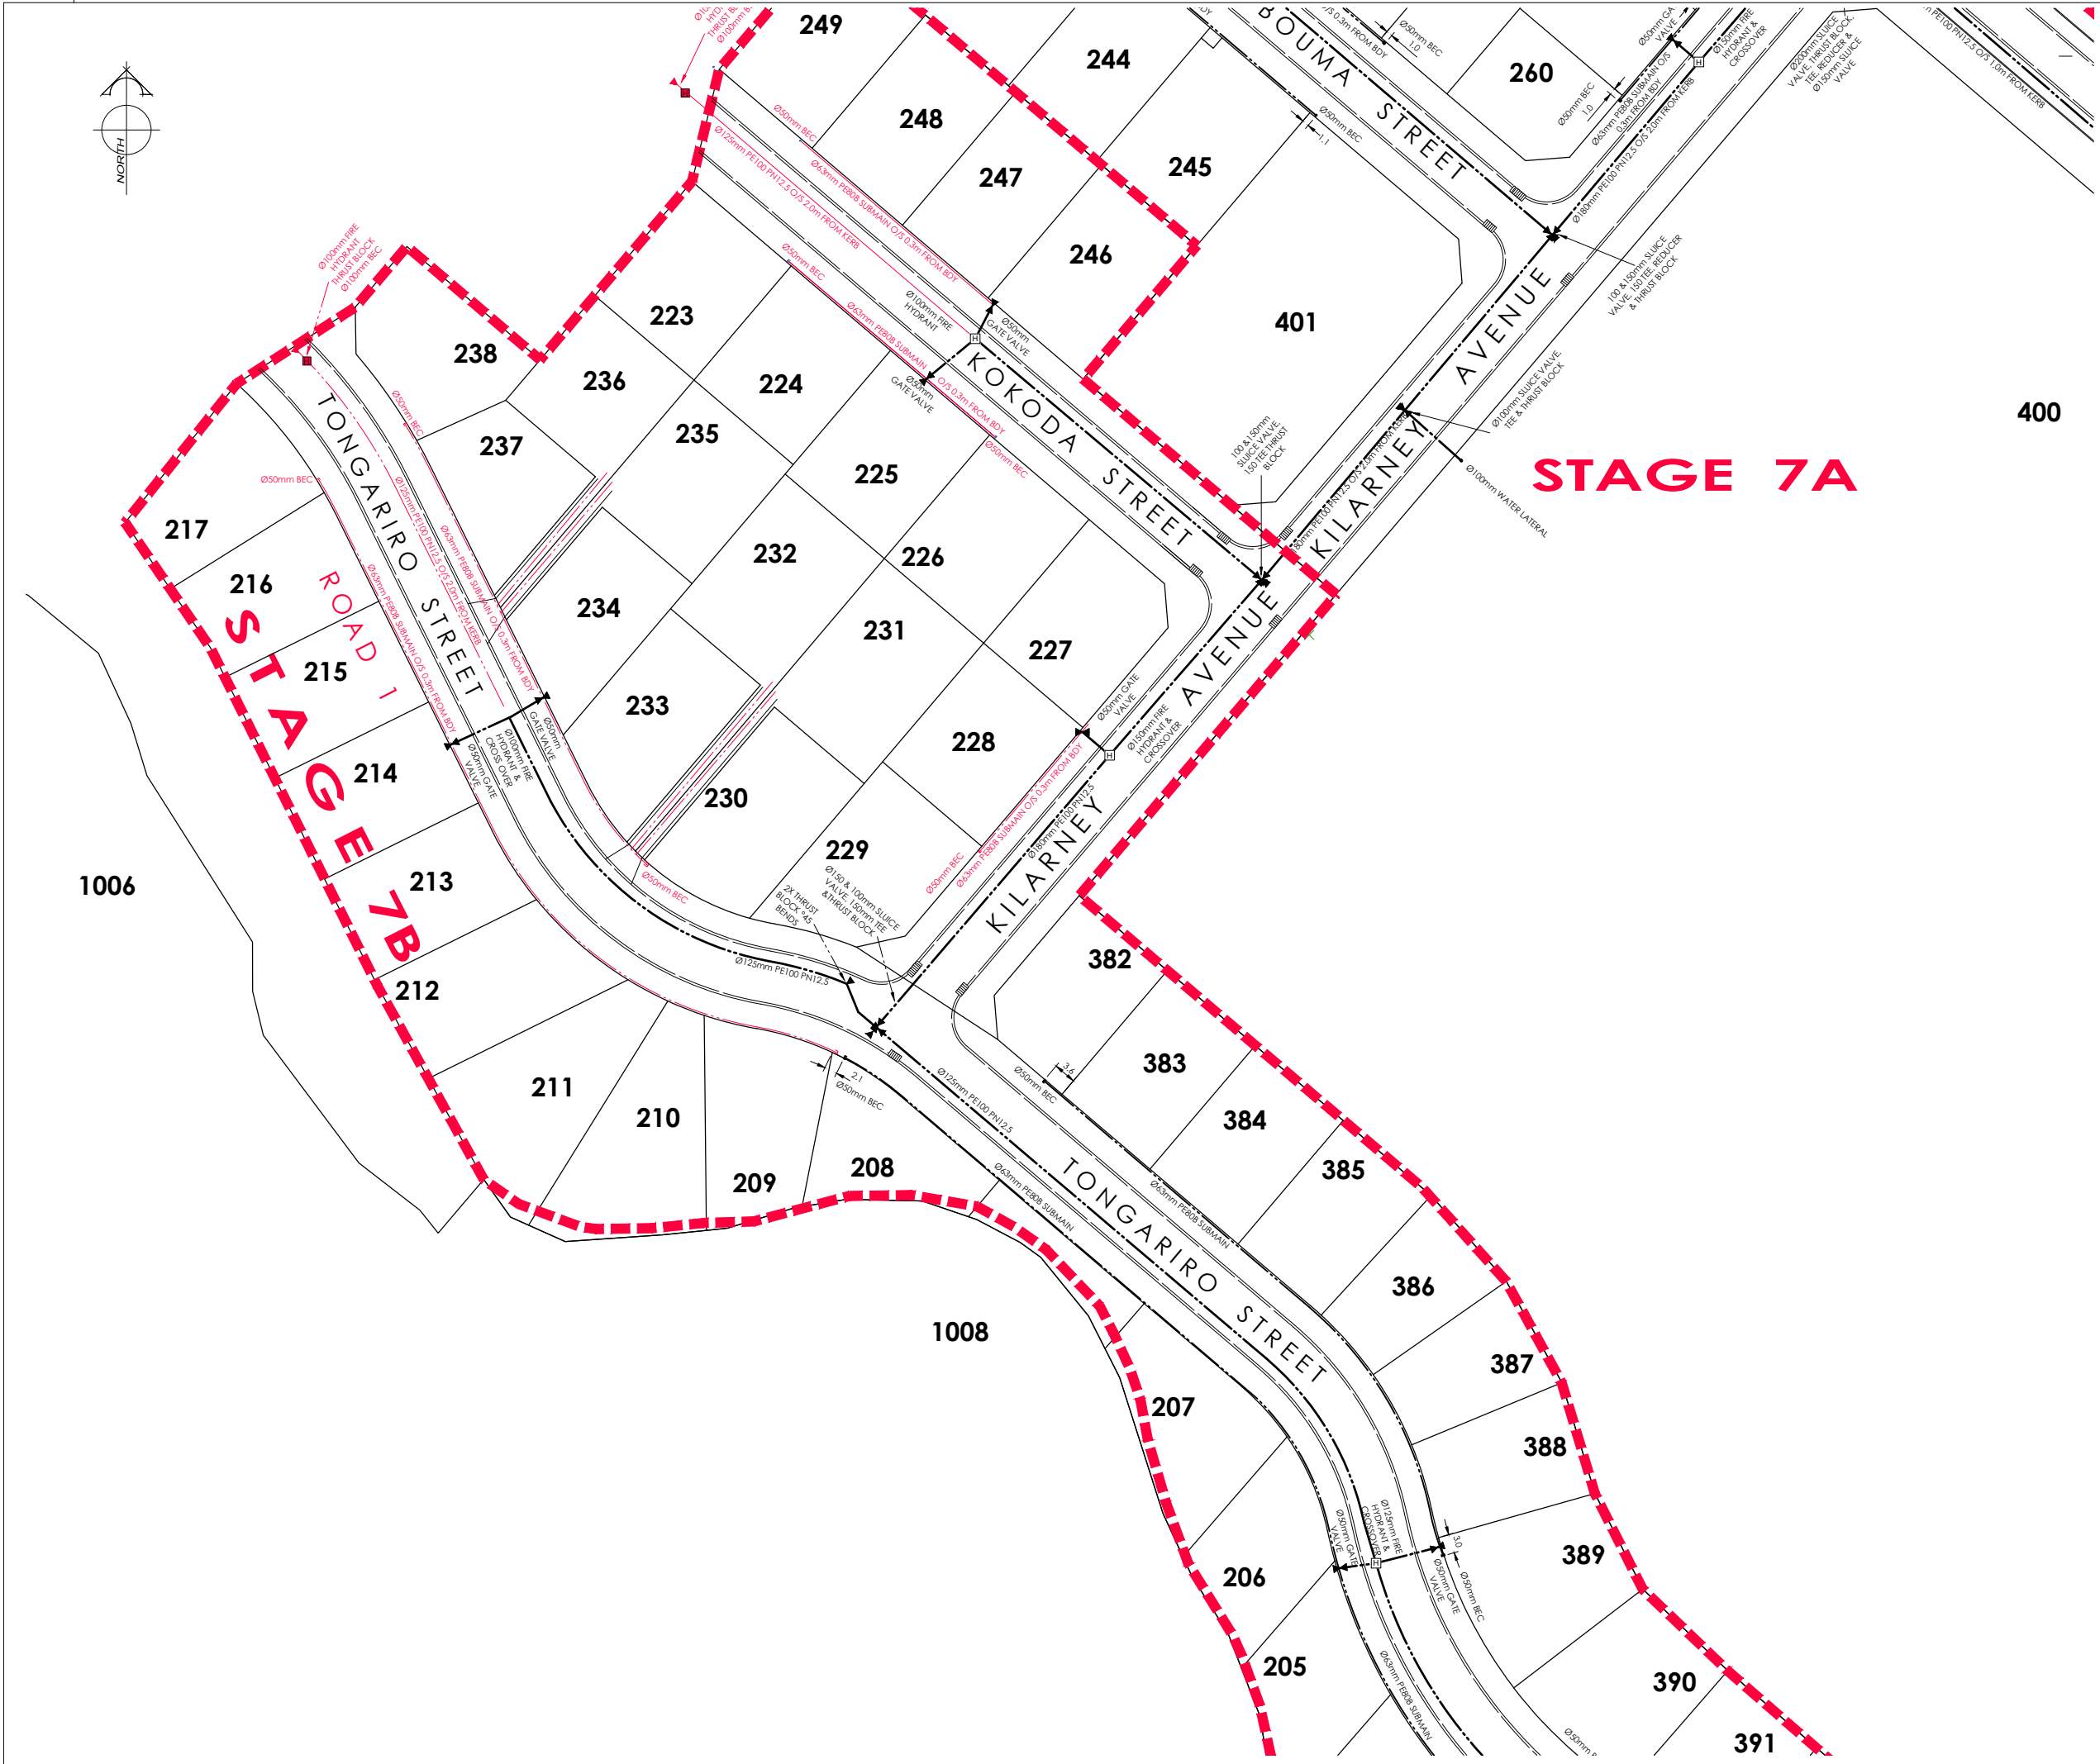

AMENDMENTS:		
AMENDMENT	DATE	DESCRIPTION

- NOTES:
- 1) This plan has been prepared for water asbuilt purposes only. No liability is accepted if the plan is used for any other purpose.
 - 2) Any measurements taken from information which is not dimensioned on the electronic copy are at the risk of the recipient.
 - 3) All roading and foot path information is not asbuilt and is for context only.

STAGE 7A

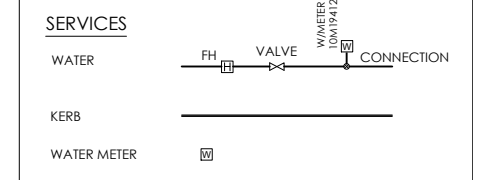

116 Wrights Road P O Box 679 Christchurch 8140, New Zealand
 Telephone: 03 379-0793 Website: www.dls.co.nz E-mail: office@dls.co.nz


JOB TITLE:
Fulton Hogan Land Development Knights Stream Park Stage 7

SHEET TITLE:
Water - Asbuilt

DRAWING STATUS:
Stages 7 Asbuilt


SCALE: 1:500@A1 DATE: June 2015
 1:1000@A3

CAD FILE: J:\18447\ASBUILT\KSP7_AB.dwg REVISION:
 DRAWING No: SHEET No:
E.18447.AB01.W02 **RO**

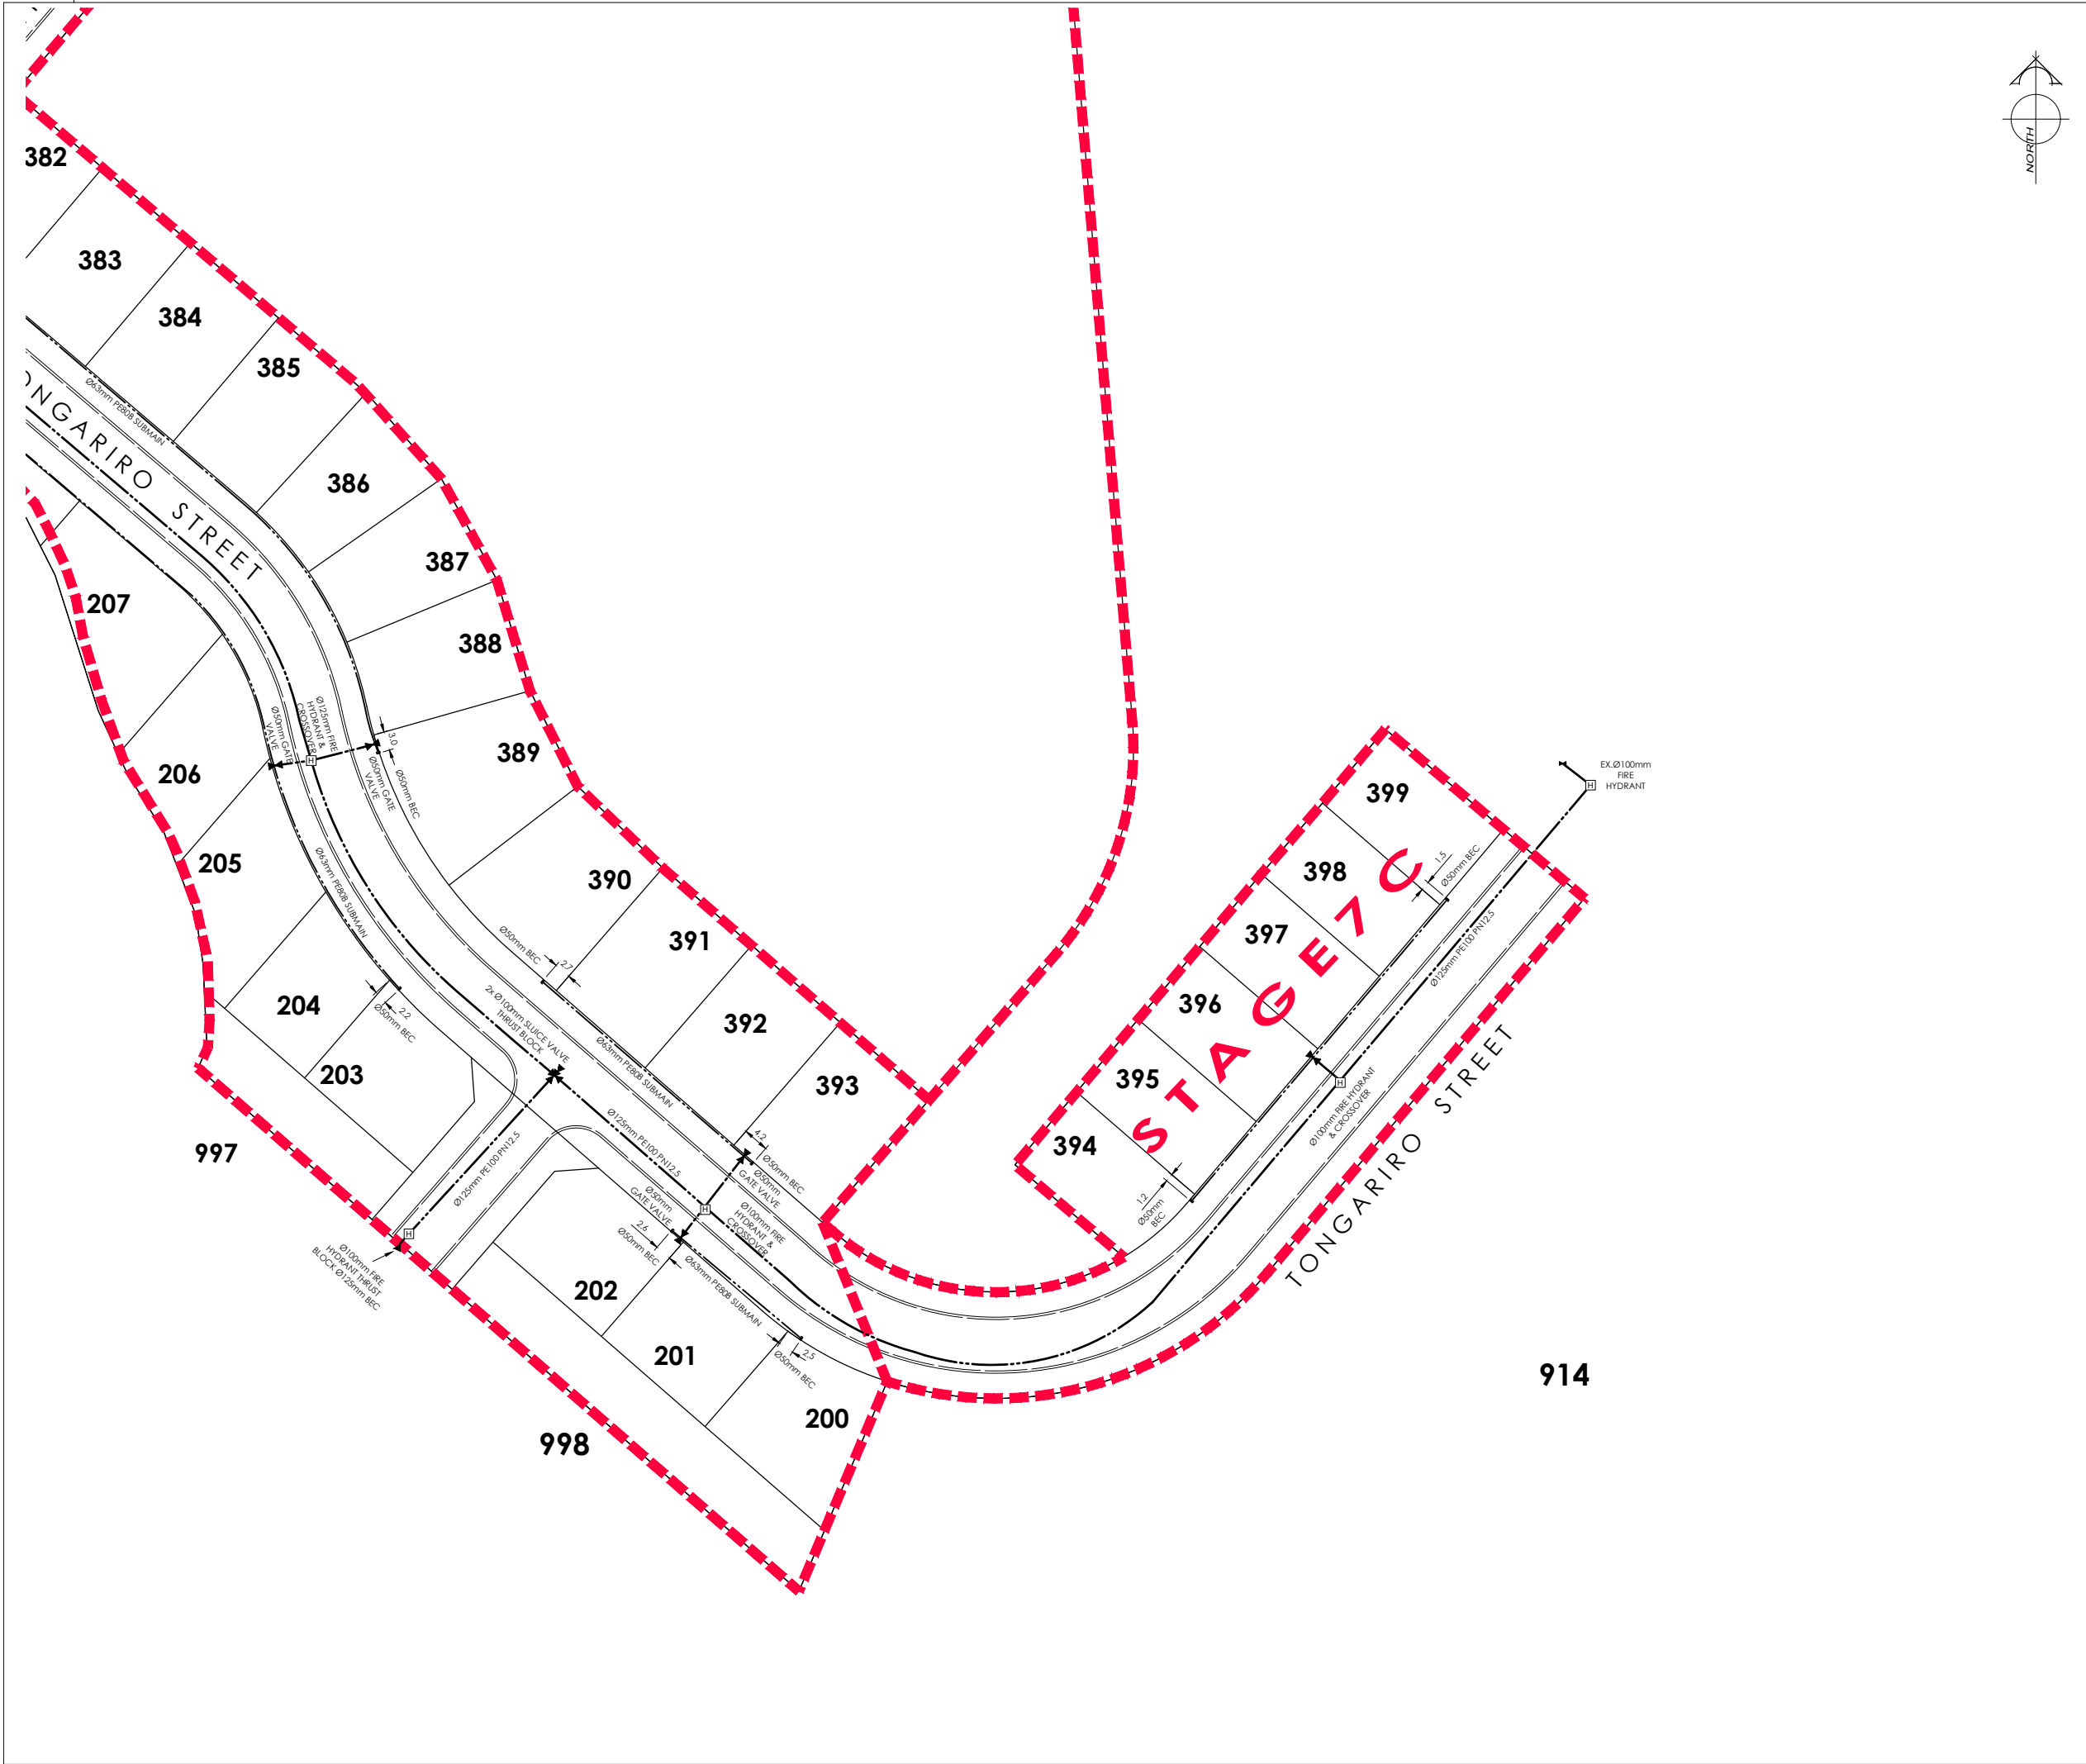

AMENDMENTS:		
AMENDMENT	DATE	DESCRIPTION

- NOTES:
- 1) This plan has been prepared for water asbuilt purposes only. No liability is accepted if the plan is used for any other purpose.
 - 2) Any measurements taken from information which is not dimensioned on the electronic copy are at the risk of the recipient.
 - 3) All Roding and foot path information is not asbuilt and is for context only.

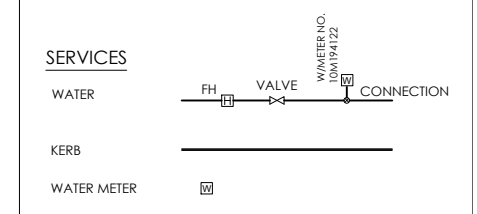

116 Wrights Road P O Box 679 Christchurch 8140, New Zealand
 Telephone: 03 379-0793 Website: www.dls.co.nz E-mail: office@dls.co.nz

JOB TITLE: **Fulton Hogan Land Development Knights Stream Park Stage 7**


SHEET TITLE: **Water - Asbuilt**

DRAWING STATUS: **Stages 7 Asbuilt**

SCALE: 1:500@A1 1:1000@A3 DATE: June 2015

CAD FILE: J:\18447\ASBUILT\KSP7_AB.dwg REVISION: **R0**

DRAWING No: **E.18447.AB01.W03**

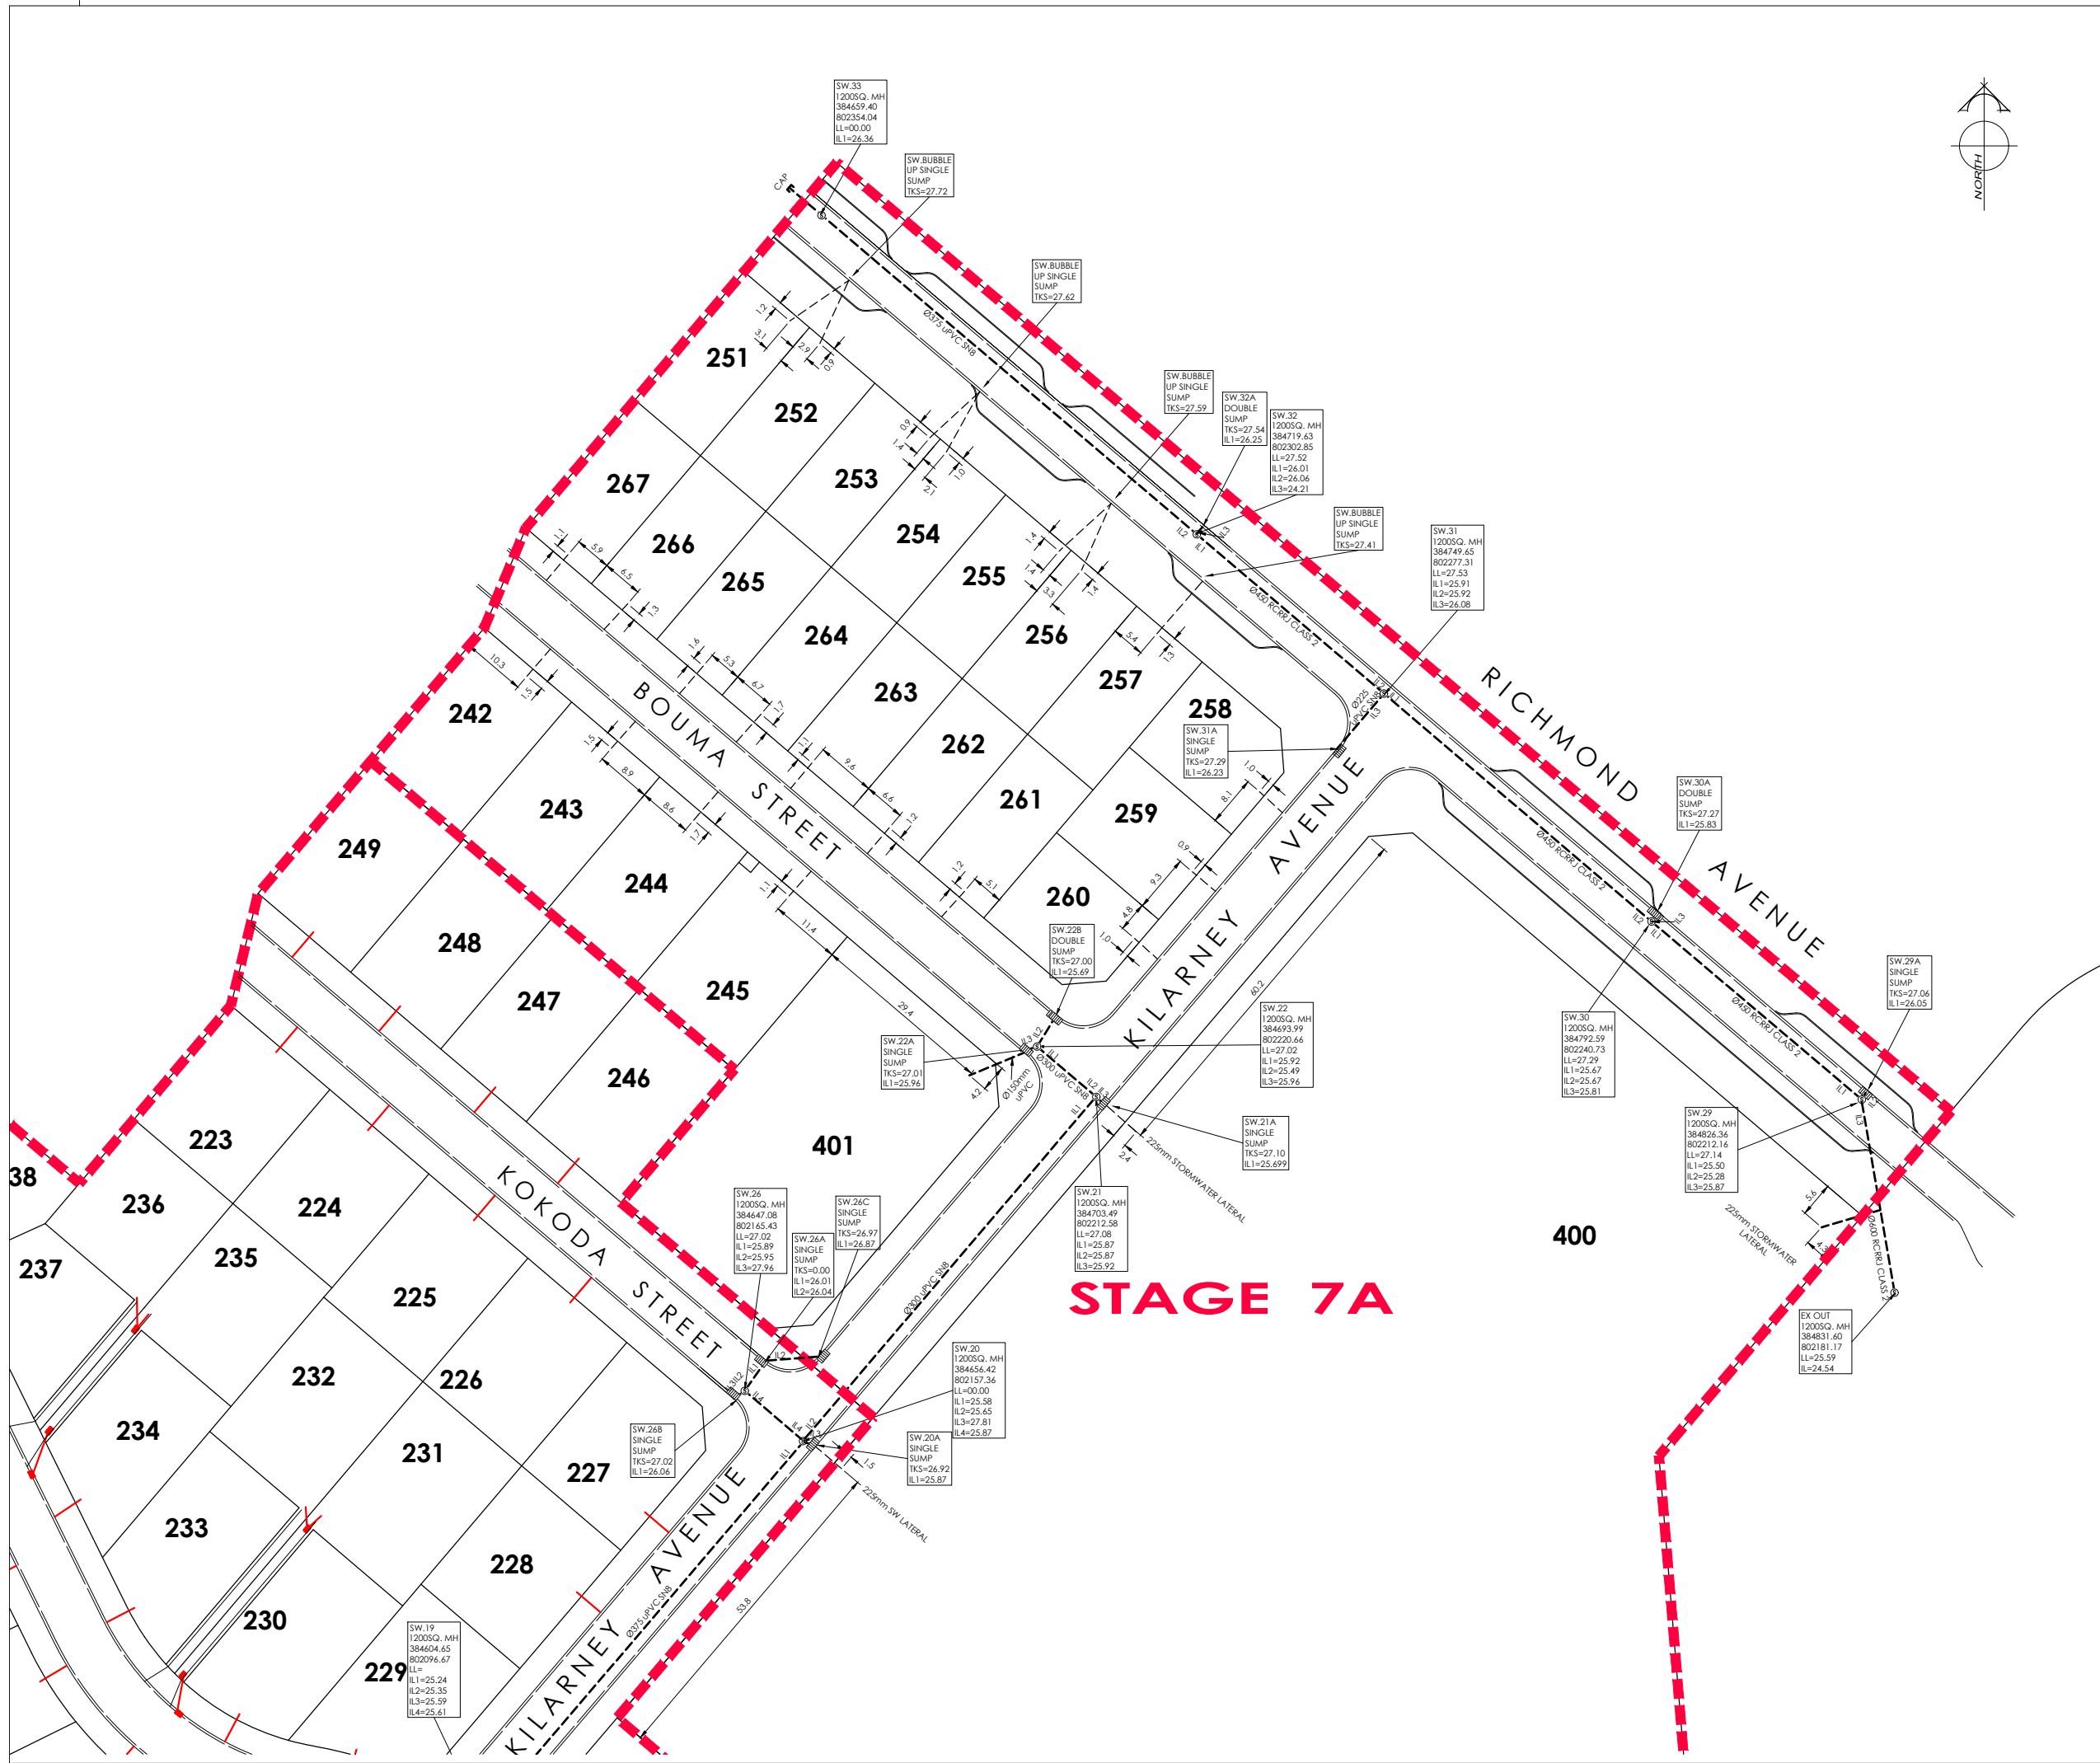

STAGE 7A

AMENDMENTS:		
AMENDMENT	DATE	DESCRIPTION

- NOTES:
- 1) This plan has been prepared for storm water asbuilt purposes only. No liability is accepted if the plan is used for any other purpose.
 - 2) Any measurements taken from information which is not dimensioned on the electronic copy are at the risk of the recipient.
 - 3) All roading and foot path information is not asbuilt and is for context purposes only.

- SERVICES
- STORMWATER
- KERB
- NOTES:
- 1) CONTOUR INTERVAL:
0.20m MINOR
1.00m MAJOR

DAVIE LOVELL-SMITH
PLANNING SURVEYING ENGINEERING

116 Wrights Road P O Box 679 Christchurch 8140, New Zealand
Telephone: 03 379-0793 Website: www.dls.co.nz E-mail: office@dls.co.nz


JOB TITLE:
**Fulton Hogan Land Development
Knights Stream Park Stage 7**

SHEET TITLE:
Stormwater - Asbuilt

DRAWING STATUS:
Stages 7 Asbuilt

SCALE: 1:500@A1
1:1000@A3 DATE: June 2015

CAD FILE: J:\18447\ASBUILT\KSP7_AB.dwg REVISION:
DRAWING No: SHEET No:
E.18447.AB01.SW01 **RO**

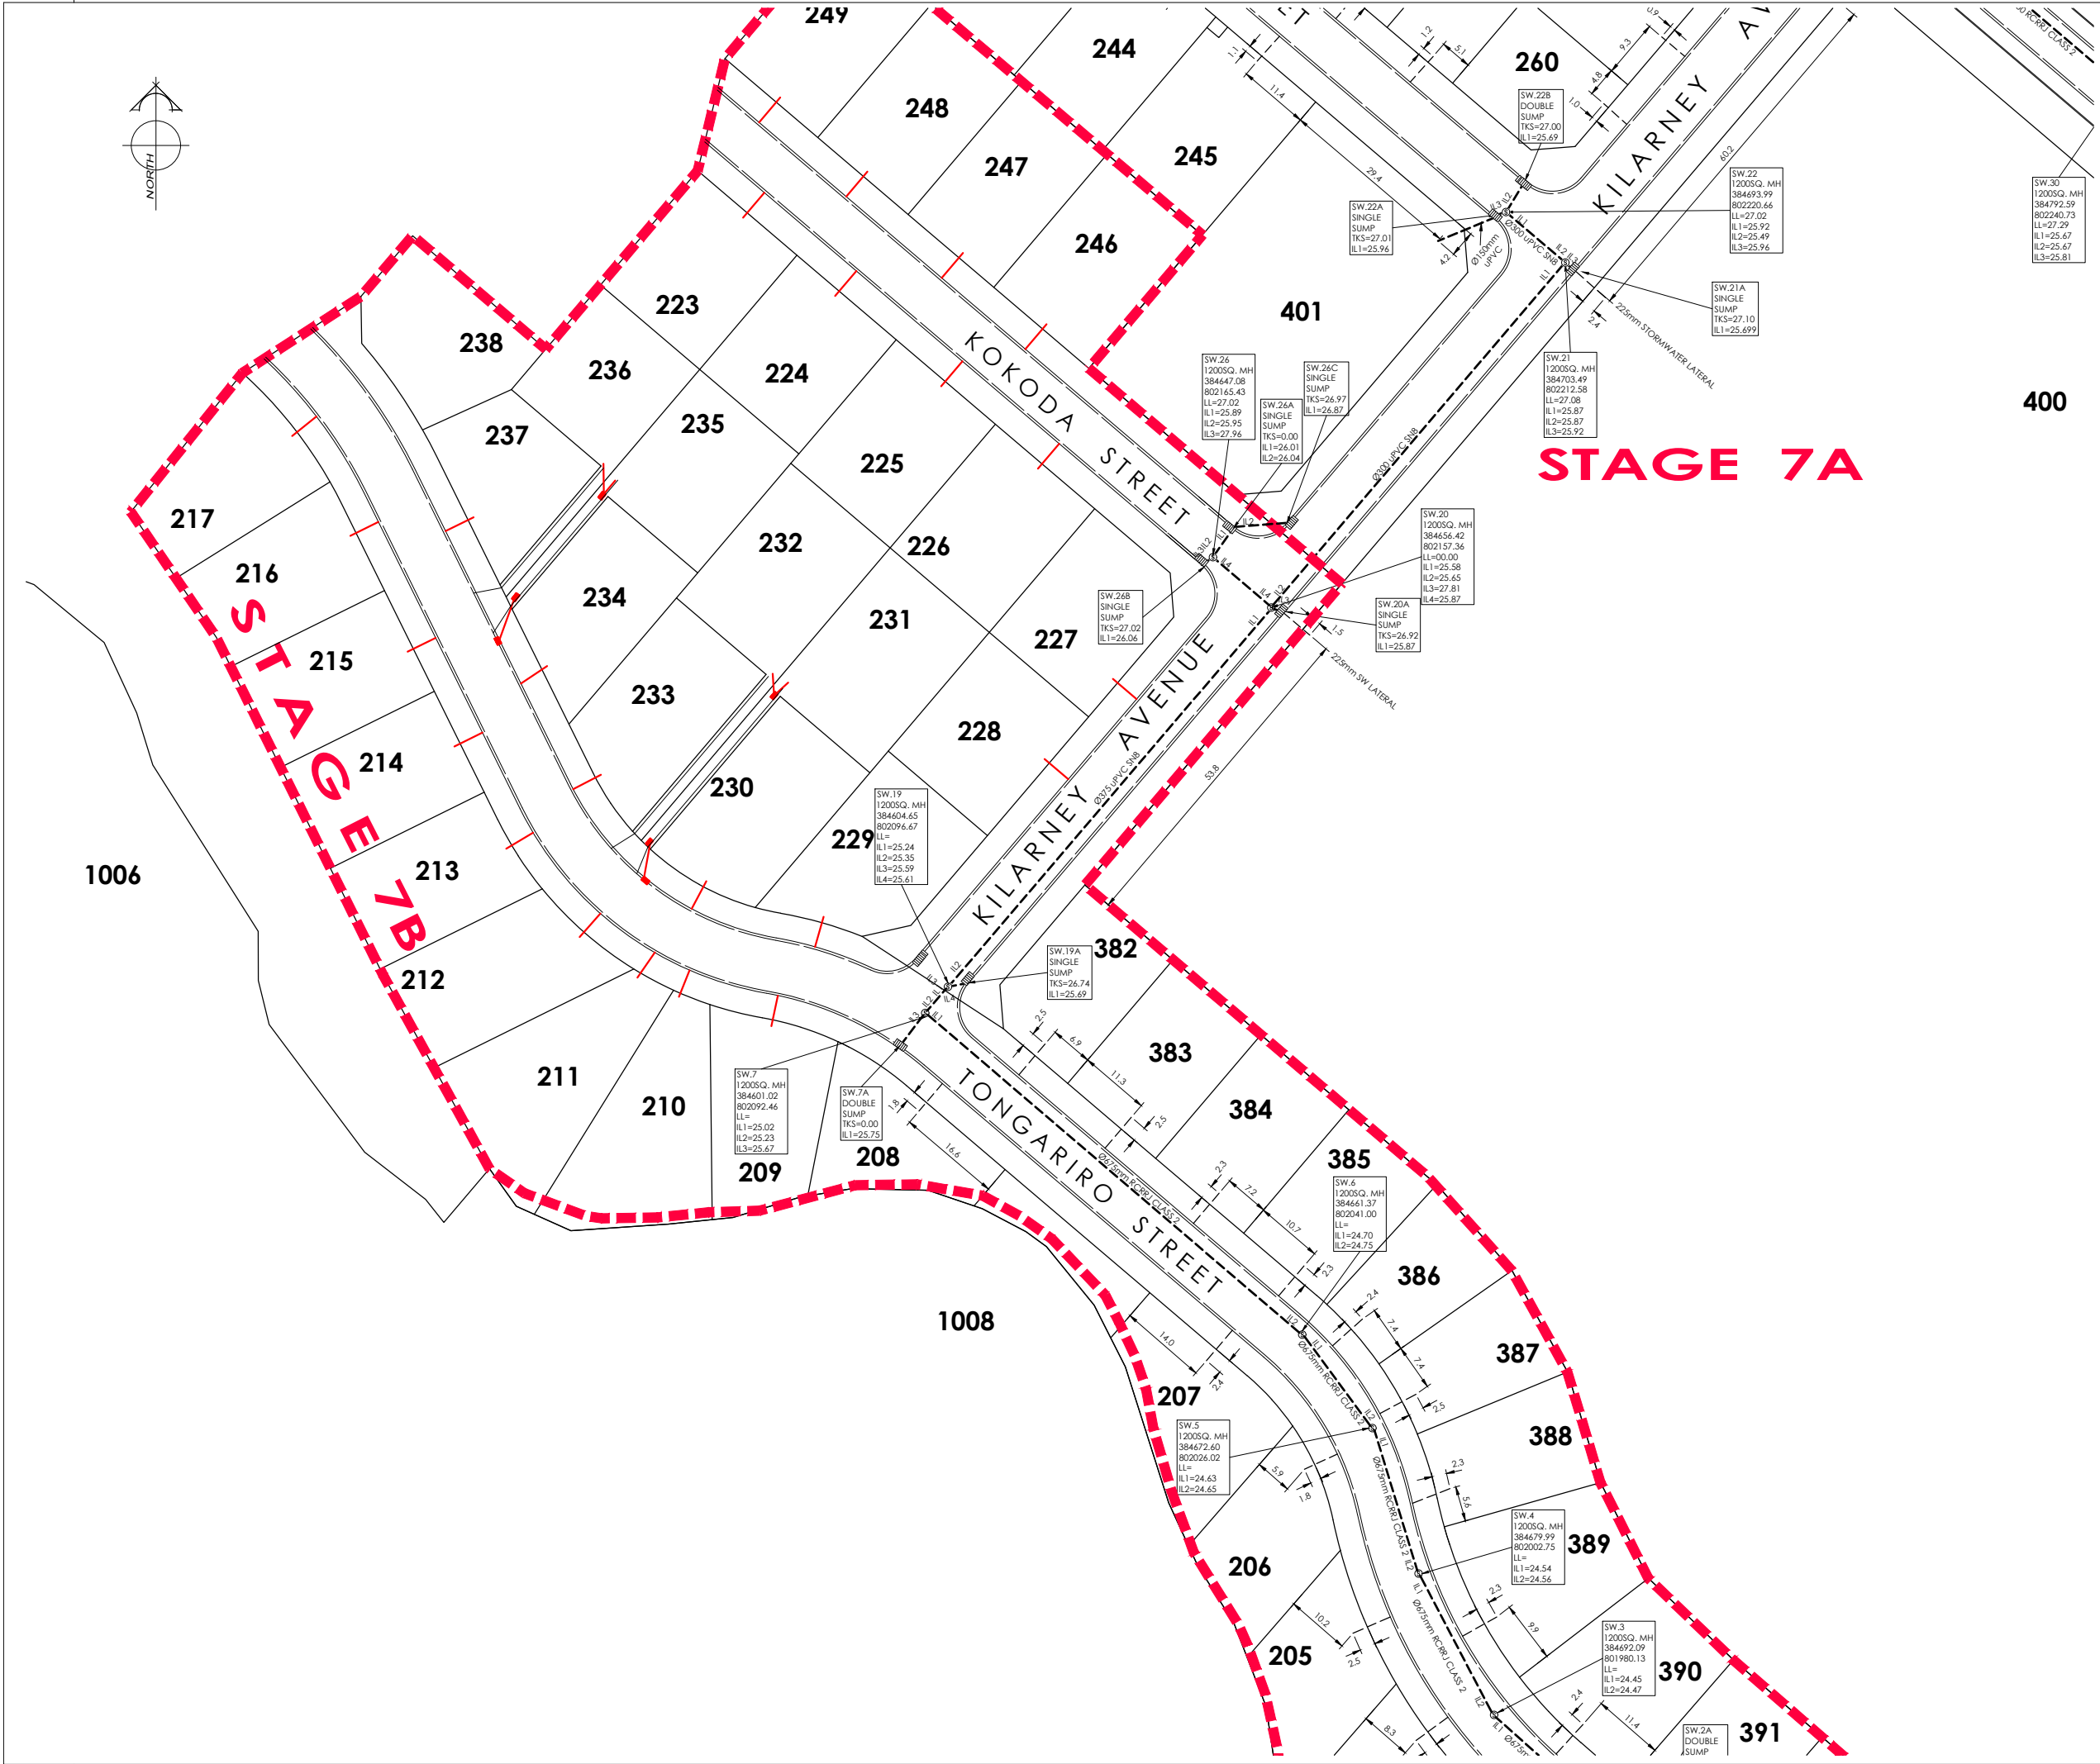

AMENDMENTS:		
AMENDMENT	DATE	DESCRIPTION

- NOTES:
- 1) This plan has been prepared for storm water asbuilt purposes only. No liability is accepted if the plan is used for any other purpose.
 - 2) Any measurements taken from information which is not dimensioned on the electronic copy are at the risk of the recipient.
 - 3) All roading and foot path information is not asbuilt and is for context purposes only.

STAGE 7A

SERVICES

STORMWATER

KERB

NOTES:

- 1) CONTOUR INTERVAL:
0.20m MINOR
1.00m MAJOR



116 Wrights Road P O Box 679 Christchurch 8140, New Zealand
Telephone: 03 379-0793 Website: www.dls.co.nz E-mail: office@dls.co.nz


JOB TITLE:
**Fulton Hogan Land Development
Knights Stream Park Stage 7**

SHEET TITLE:
Stormwater - Asbuilt

DRAWING STATUS:
Stages 7 Asbuilt

SCALE: 1:500@A1 DATE: June 2015
1:1000@A3

CAD FILE: J:\18447\ASBUILT\KSP7_AB.dwg REVISION:
DRAWING No: SHEET No:
E.18447.AB01.SW02 **RO**

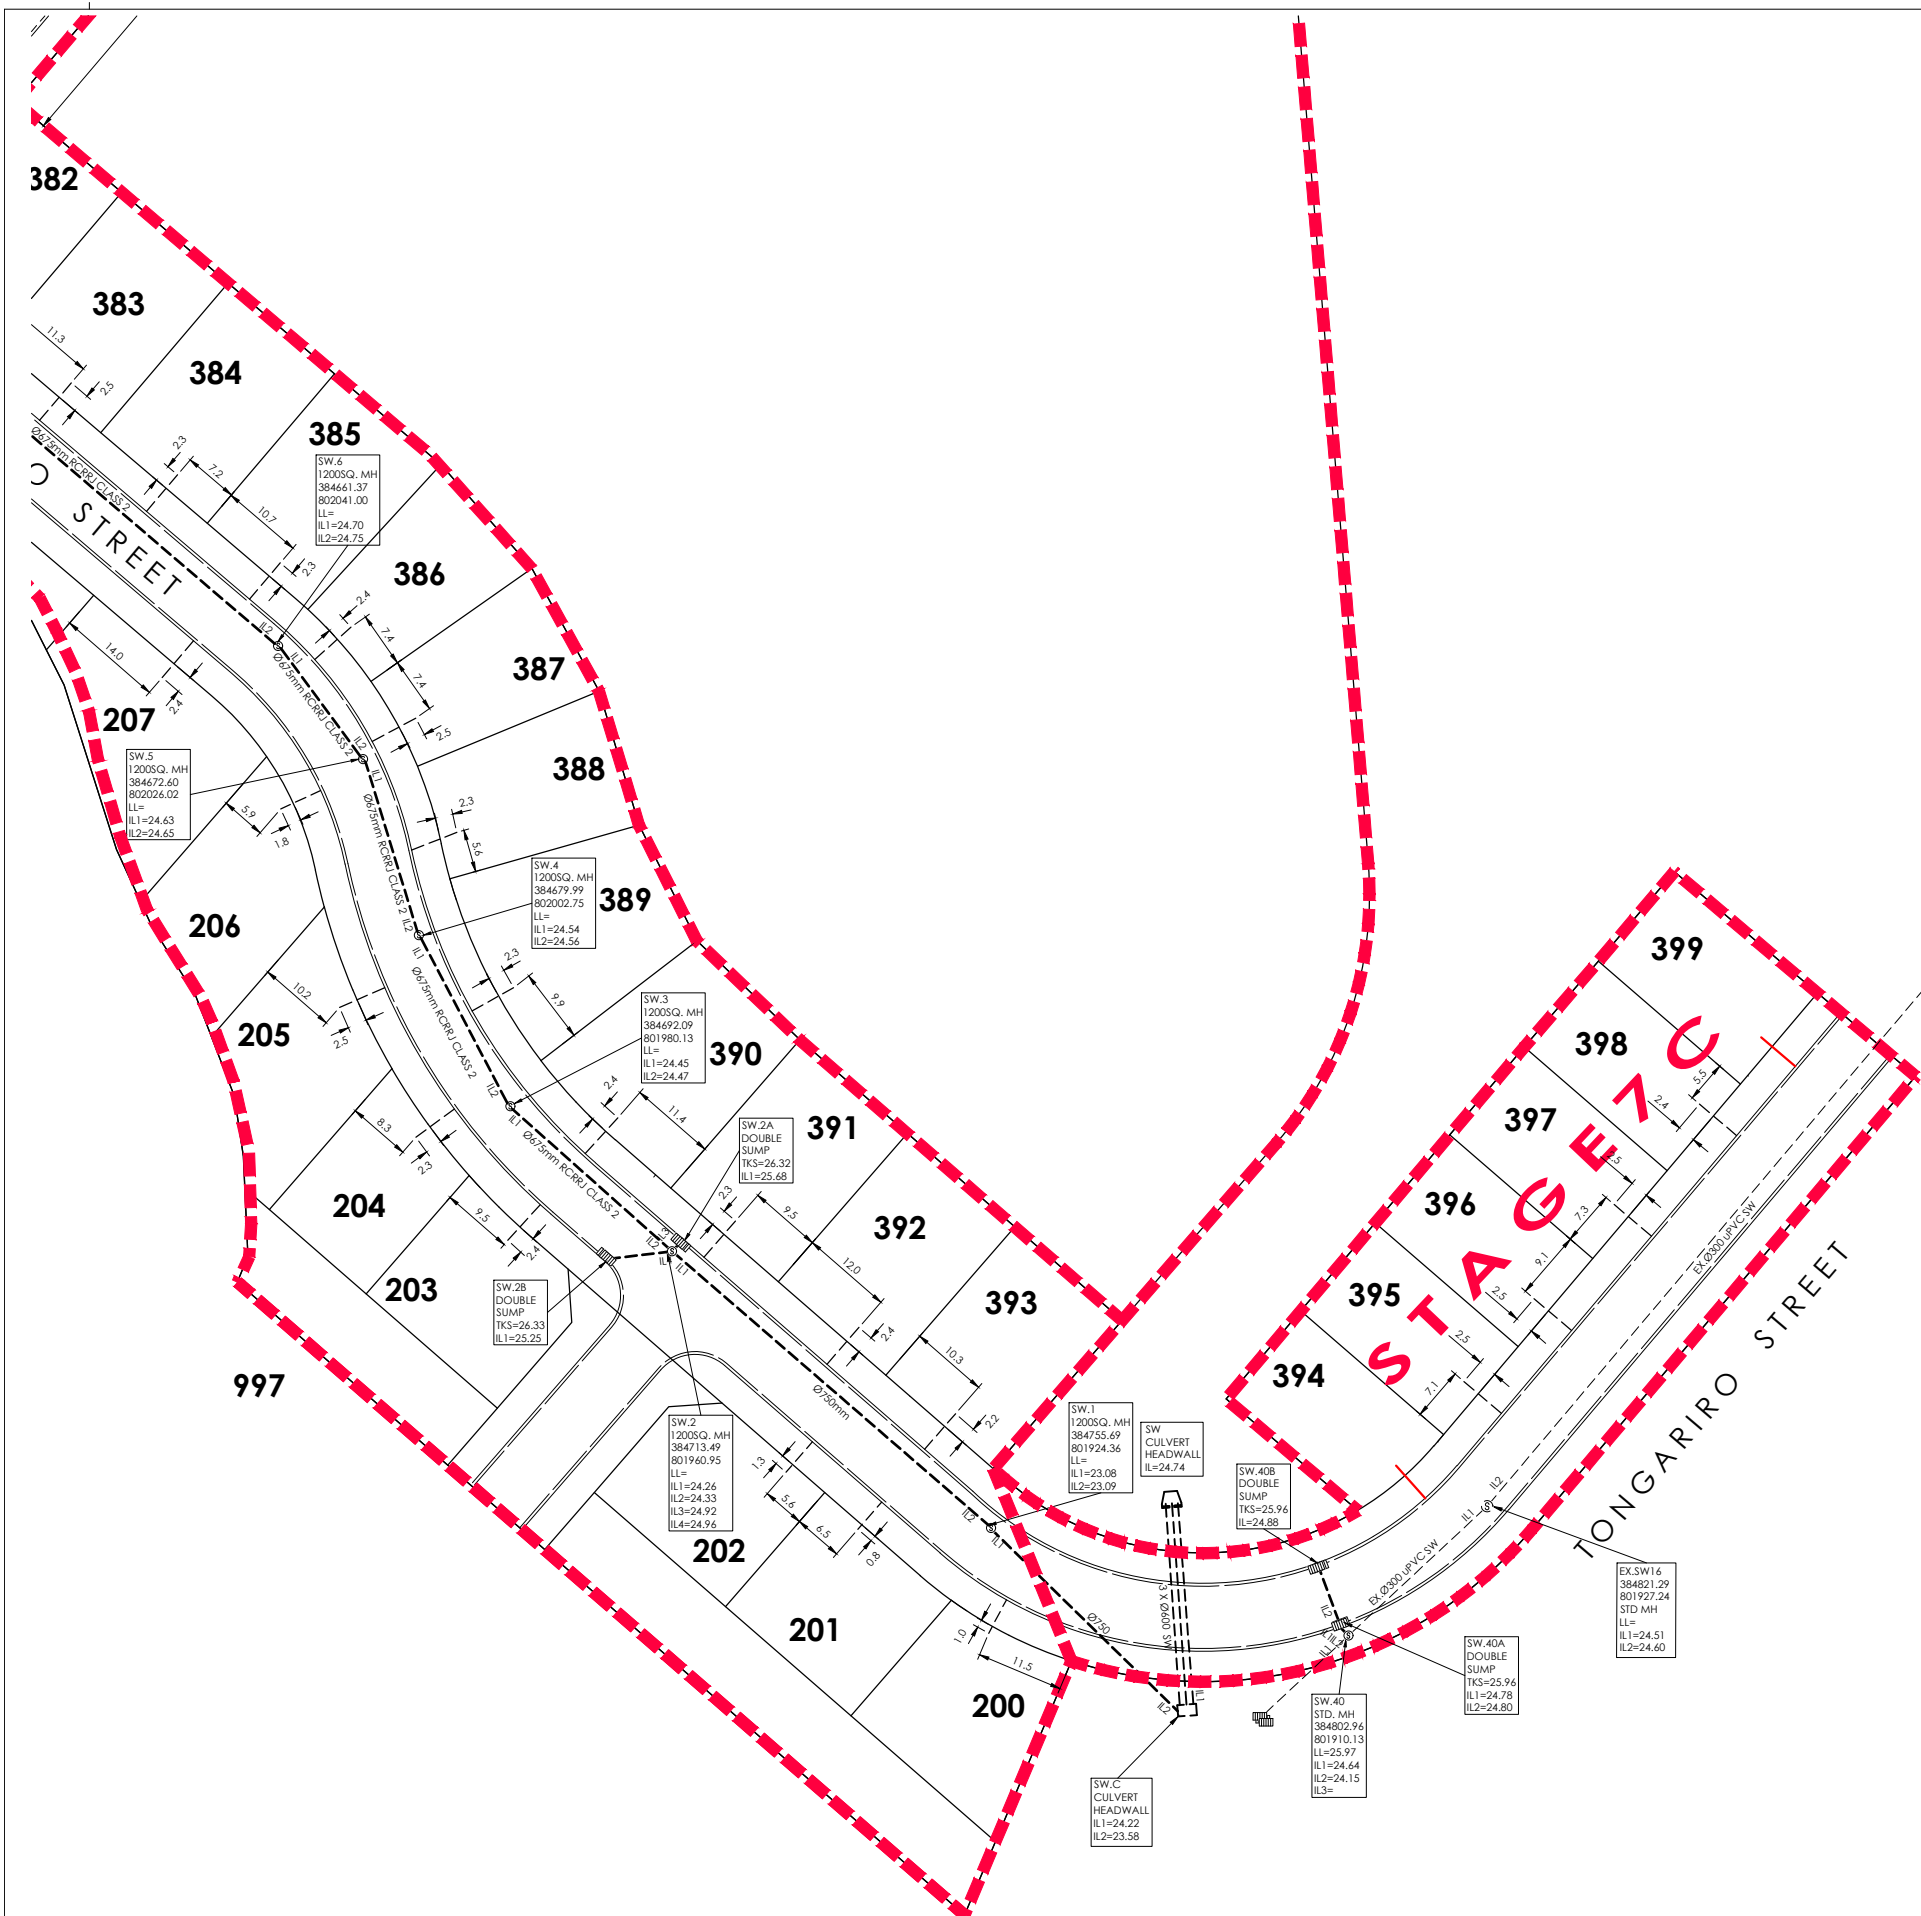

AMENDMENTS:		
AMENDMENT	DATE	DESCRIPTION

- NOTES:
- 1) This plan has been prepared for storm water asbuilt purposes only. No liability is accepted if the plan is used for any other purpose.
 - 2) Any measurements taken from information which is not dimensioned on the electronic copy are at the risk of the recipient.
 - 3) All roading and foot path information is not asbuilt and is for context purposes only.

SERVICES

STORMWATER

KERB

NOTES:

- 1) CONTOUR INTERVAL:
0.20m MINOR
1.00m MAJOR



116 Wrights Road P O Box 679 Christchurch 8140. New Zealand
Telephone: 03 379-0793 Website: www.dls.co.nz E-mail: office@dls.co.nz

JOB TITLE:
**Fulton Hogan Land Development
Knights Stream Park Stage 7**

SHEET TITLE:
Stormwater - Asbuilt

DRAWING STATUS:
Stages 7 Asbuilt

SCALE: 1:500@A1 DATE: June 2015
1:1000@A3

CAD FILE: J:\18447\ASBUILT\KSP7_AB.dwg REVISION:
DRAWING No: SHEET No:
E.18447.AB01.SW03 **RO**